

CONSULTANTS:
 OWNER'S PROJECT ARCHITECT:
 MOSES TUCKER REAL ESTATE, INC.
 CIVIL ENGINEER:
 McCLELLAND ENGINEERS
 LANDSCAPE ARCHITECT:
 LARSON BURNS SMITH
 STRUCTURAL ENGINEER:
 CROMWELL ENGINEERS INC.
 MECH., ELEC., PLUMB. ENGINEER:
 CROMWELL ENGINEERS INC.
 SUSTAINABLE CONSULTANT:
 BNIM / ELEMENTS
 GLOBAL VILLAGE CONSULTANT
 CAMBRIDGE SEVEN ASSOCIATES
 INTERIOR DESIGNER:
 POLK STANLEY YEARY
 GENERAL CONTRACTOR:
 CDI

GENERAL NOTES:

NOTES:

ISSUE DATE:
 NOVEMBER 17, 2003
 STRUCTURAL/FOUNDATION
 PACKAGE #4

REVISIONS:


#	DATE	DESCRIPTION
1	01/19/2004	PACKAGE 4-ADDM.04
2	02/26/2004	PACKAGE 4-ADDM.05
3	3/23/2004	PACKAGE 4-ADDM.07
4	4/13/2004	PACKAGE 4-ADDM.09
5	6/01/2004	ASI #2
6	7/01/2004	PACKAGE 7
7	07/16/2004	ASH10
8	08/26/2004	ASH17

HEIFER INTERNATIONAL CENTER OFFICE BUILDING
 LITTLE ROCK, ARKANSAS


PSY PROJECT NUMBER:
 431C

CONTENTS:
 SHEAR WALL ELEVATIONS


SHEET NUMBER:
S302

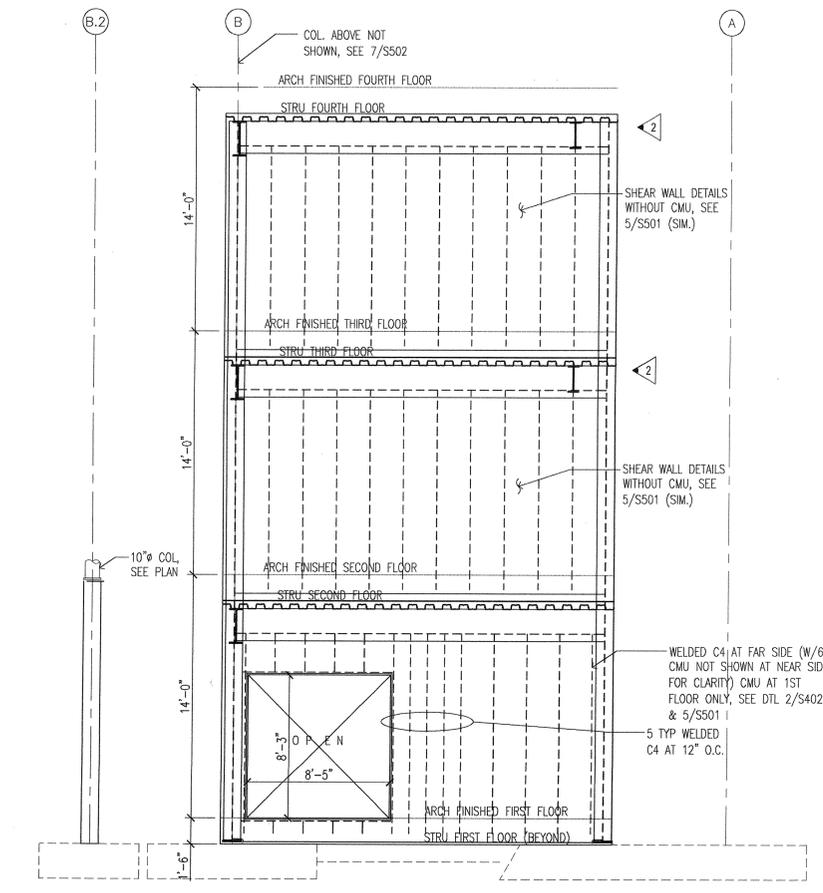


1 SHEAR WALL ELEVATION AT MECH. ROOM 2 ALONG GRID 21
 SCALE: 1/4"=1'-0"

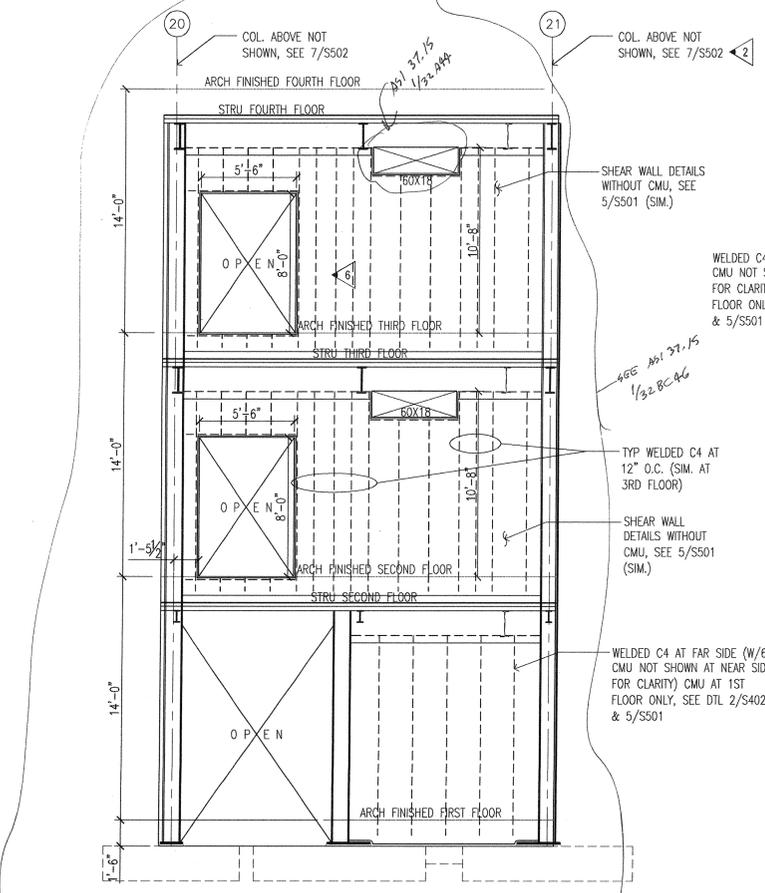


2 INTERIOR SOUTH SHEAR WALL ELEVATION AT MECH. ROOM 2 ALONG GRID-B
 SCALE: 1/4"=1'-0"

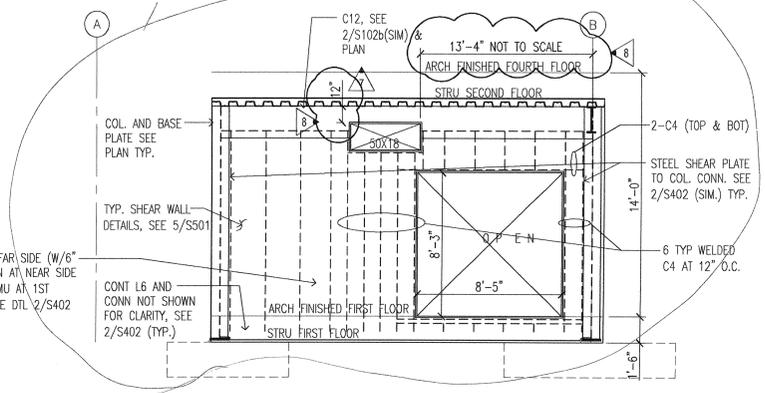

3 INTERIOR SHEAR WALL ELEVATION AT MECH. ROOM 2 BETWEEN GRID-20 AND GRID-21
 SCALE: 1/4"=1'-0"

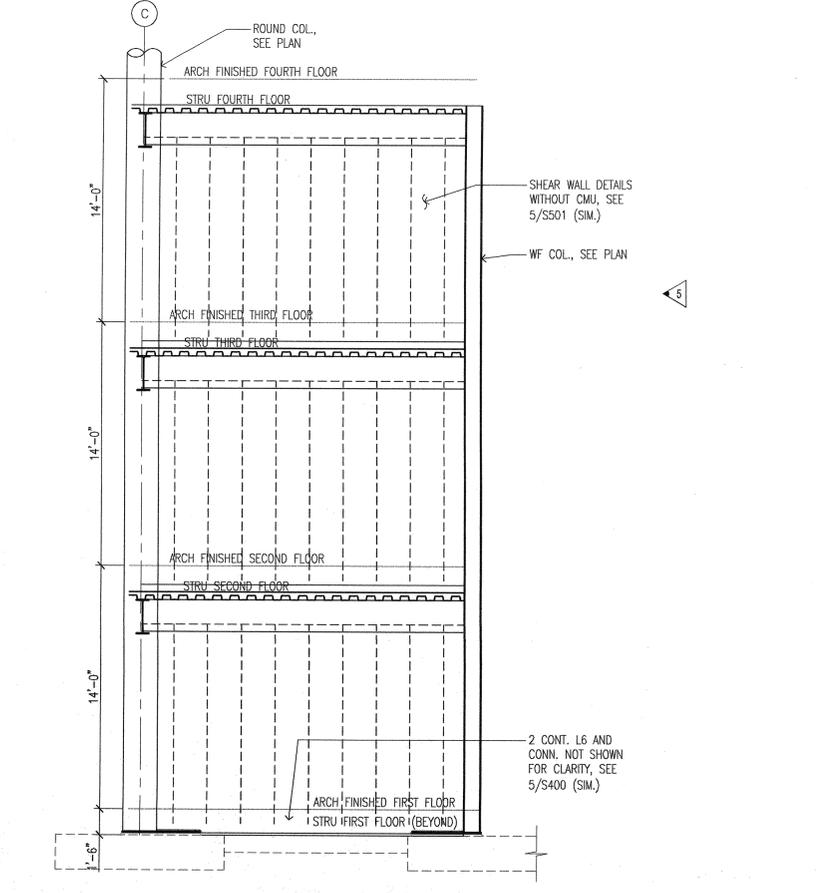


5 SHEAR WALL ELEVATION AT GRID 12 AND 15 (OPP. HAND)
 SCALE: 1/4"=1'-0"

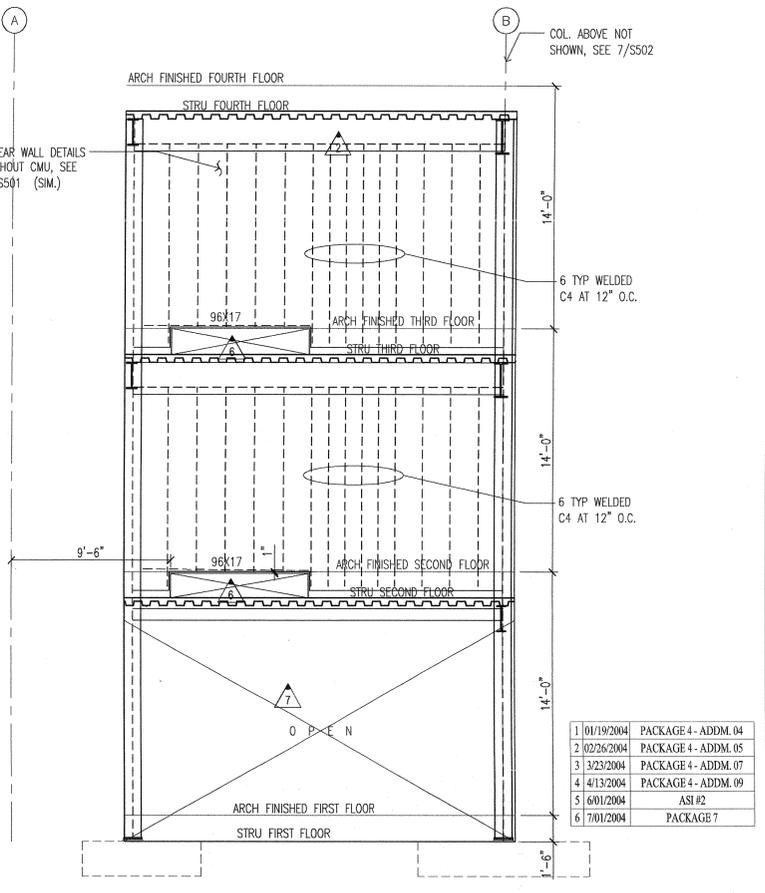

4 WEST SHEAR WALL ELEVATION AT MECH. ROOM 2 ALONG GRID 20
 SCALE: 1/4"=1'-0"

NOTE:
 VERIFY ALL OPENING SIZES AND LOCATIONS WITH MECHANICAL AND ARCHITECTURAL DWGS.

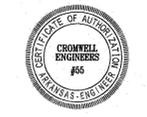

F:\Projects\2001\2001_066\2001066.dwg\5302.dwg, 08/27/2004 10:25:08 AM
 CROMWELL ENGINEERS