

CONSULTANTS:

OWNER'S PROJECT ADVISOR:
MOSES TUCKER REAL ESTATE, INC.

CIVIL ENGINEER:
MCCLELLAND ENGINEERS

LANDSCAPE ARCHITECT:
LARSON BURNS SMITH

STRUCTURAL ENGINEER:
CROMWELL ENGINEERS INC.

MECH., ELEC., PLUMB. ENGINEER:
CROMWELL ENGINEERS INC.

SUSTAINABLE CONSULTANT:
BNIM / ELEMENTS

GLOBAL VILLAGE CONSULTANT
CAMBRIDGE SEVEN ASSOCIATES

INTERIOR DESIGNER:
POLK STANLEY YEARY

GENERAL CONTRACTOR:
CDI

GENERAL NOTES:

NOTES:

ISSUE DATE:
NOVEMBER 17, 2003
STRUCTURAL/FOUNDATION
PACKAGE #4

REVISIONS:

#	DATE	DESCRIPTION
1	01/19/2004	PACKAGE 4 - ADDM. 04
2	02/26/2004	PACKAGE 4 - ADDM. 05
3	03/17/2004	PACKAGE 4 - ADDM. 06
4	03/23/2004	PACKAGE 4 - ADDM. 07
5	04/XX/2004	PACKAGE 4 - ADDM. 09
6	06/12/2004	ASI #2




**HEIFER
INTERNATIONAL
CENTER
OFFICE BUILDING**
LITTLE ROCK, ARKANSAS

PSY PROJECT NUMBER:
431C

CONTENTS:
SLAB AND FOUNDATION
DETAILS

SHEET NUMBER:

S401

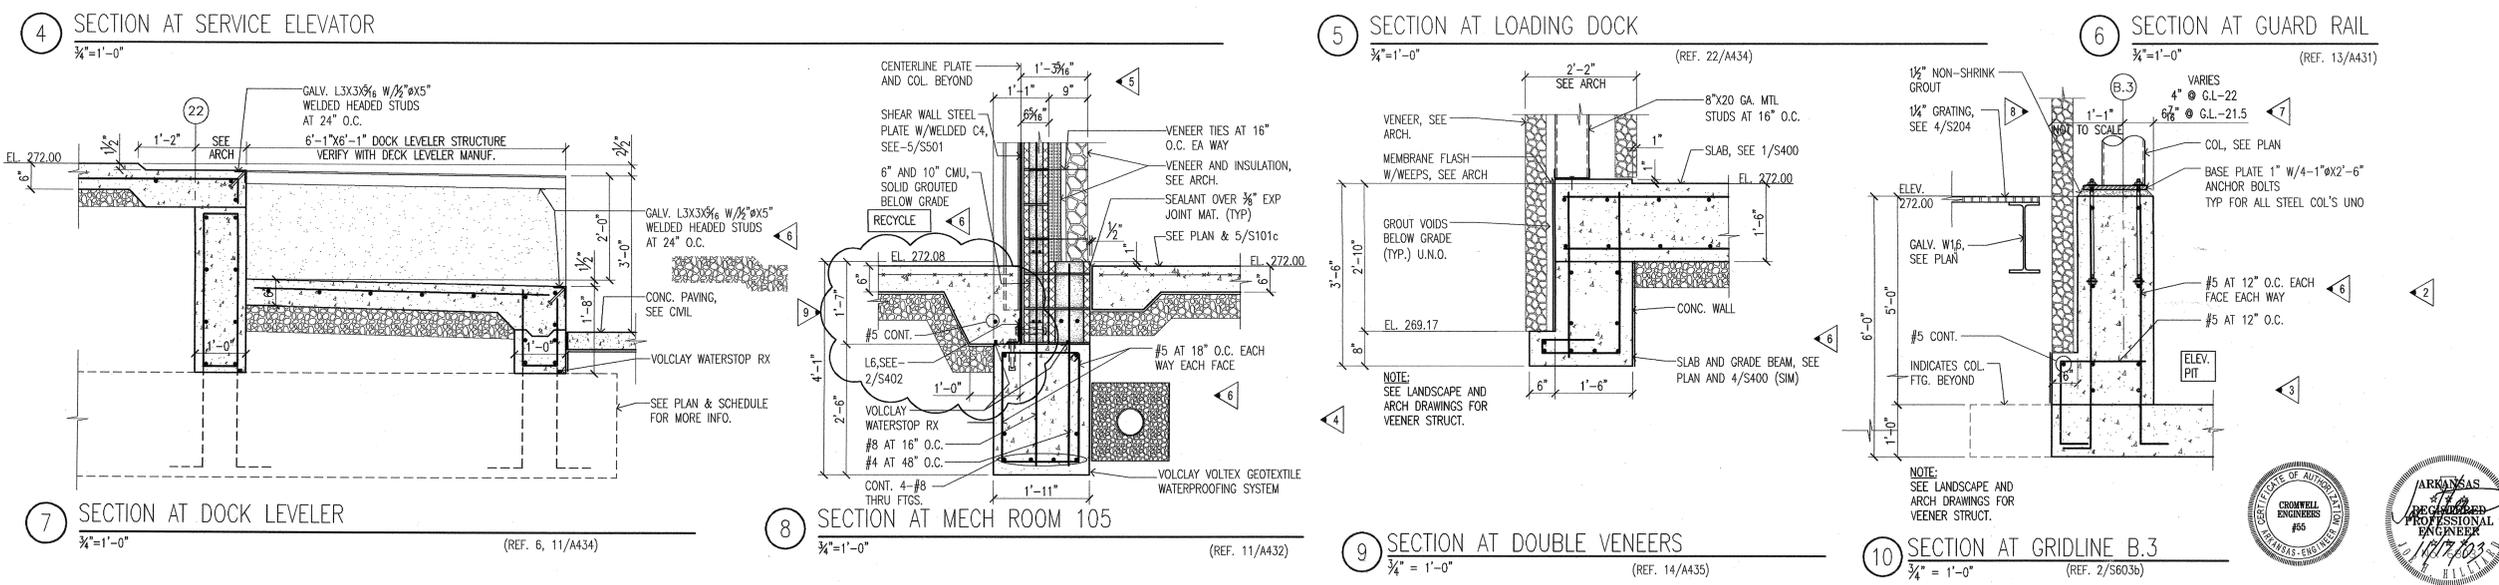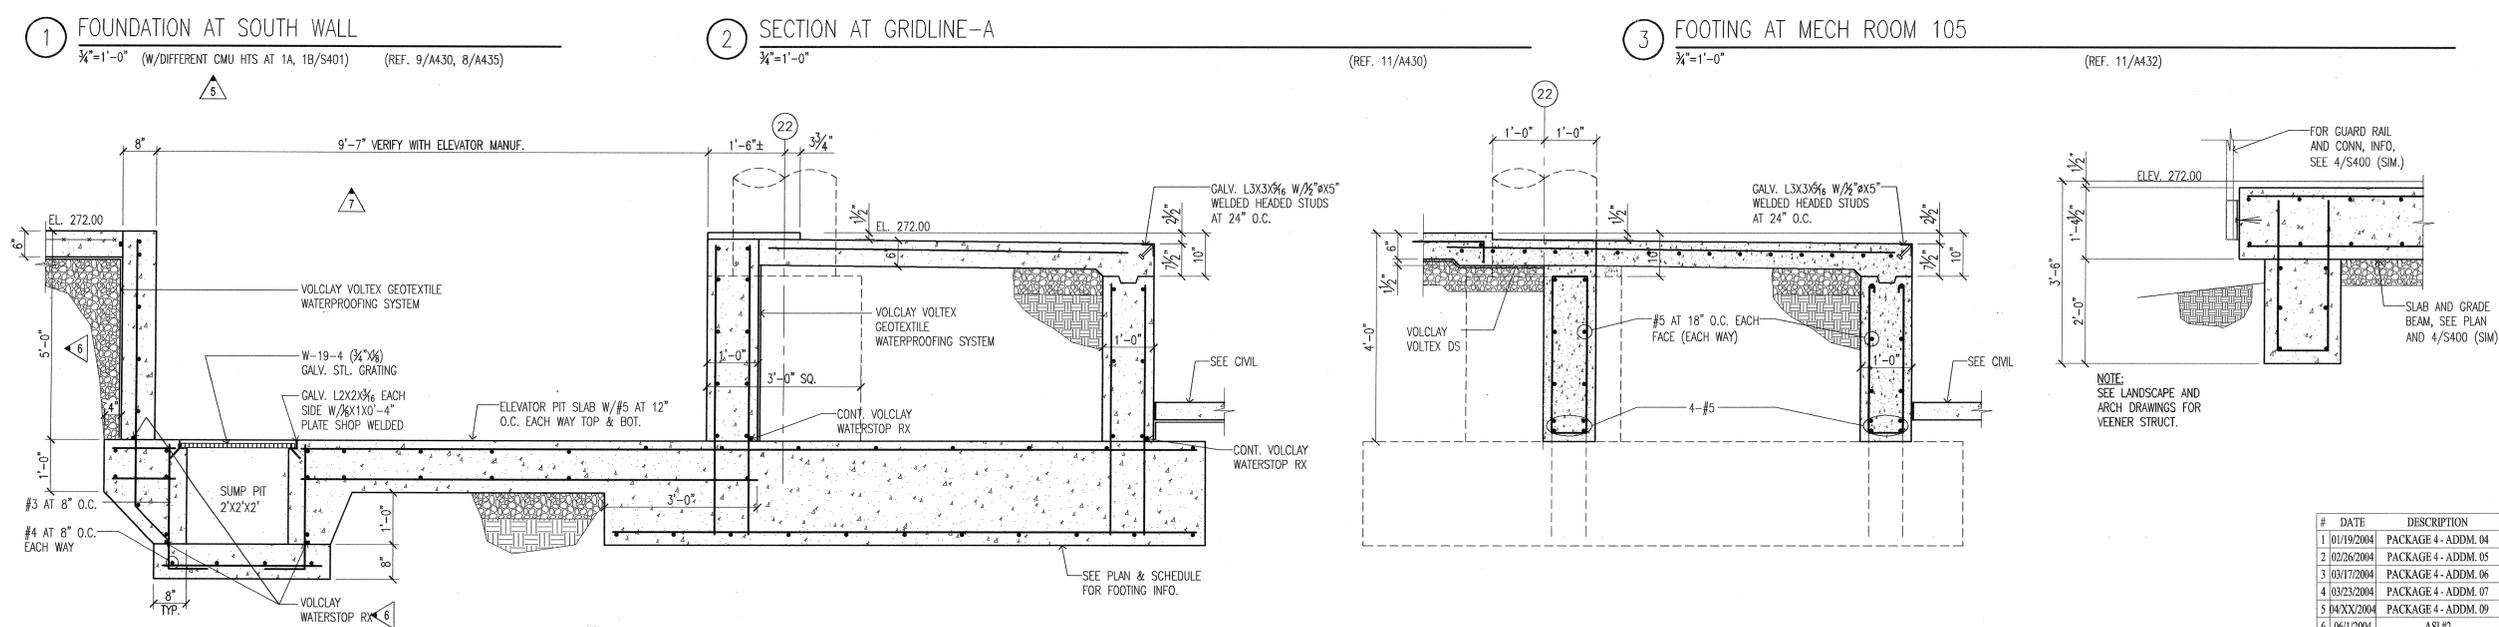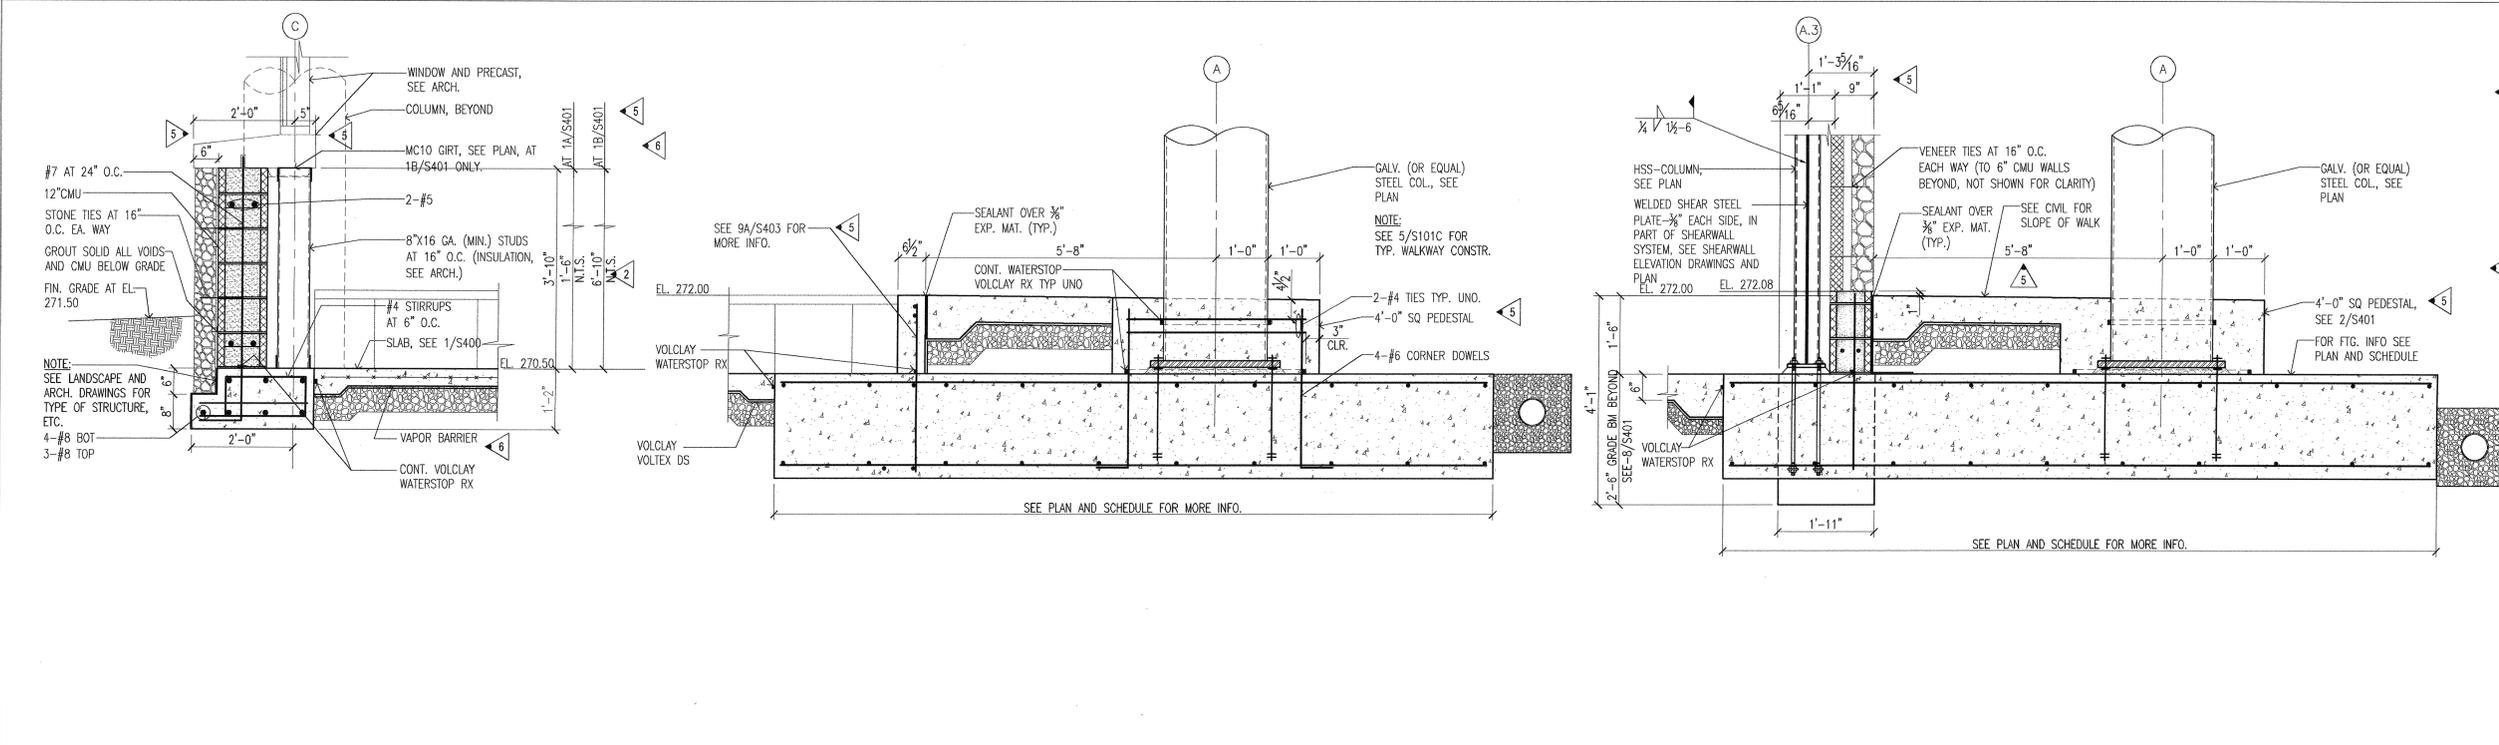

F:\Projects\2001\2001_066\2001066.dwg S401.dwg 08/27/2004 10:27:35 AM

