

CONSULTANTS:

OWNER'S PROJECT ADVISOR:
MOSES TUCKER REAL ESTATE, INC.

CIVIL ENGINEER:
McCLELLAND ENGINEERS

LANDSCAPE ARCHITECT:
LARSON BURNS SMITH

STRUCTURAL ENGINEER:
CROMWELL ENGINEERS INC.

MECH., ELEC., PLUMB. ENGINEER:
CROMWELL ENGINEERS INC.

SUSTAINABLE CONSULTANT:
BNIM / ELEMENTS

GLOBAL VILLAGE CONSULTANT
CAMBRIDGE SEVEN ASSOCIATES

INTERIOR DESIGNER:
POLK STANLEY YEARY

GENERAL CONTRACTOR:
CDI

GENERAL NOTES:

NOTES:

ISSUE DATE:
NOVEMBER 17, 2003
STRUCTURAL FOUNDATION
PACKAGE #4

REVISIONS:

#	DATE	DESCRIPTION
1	01/19/2004	PACKAGE 4 - ADDM. 04
2	02/26/2004	PACKAGE 4 - ADDM. 05
3	03/17/2004	PACKAGE 4 - ADDM. 06
4	03/23/2004	PACKAGE 4 - ADDM. 07
5	04/13/2004	PACKAGE 4 - ADDM. 09
6		

**HEIFER
INTERNATIONAL
CENTER
OFFICE BUILDING**


LITTLE ROCK, ARKANSAS

PSY PROJECT NUMBER:
431C


CONTENTS:
SLAB AND FOUNDATION
DETAILS

SHEET NUMBER:


S402

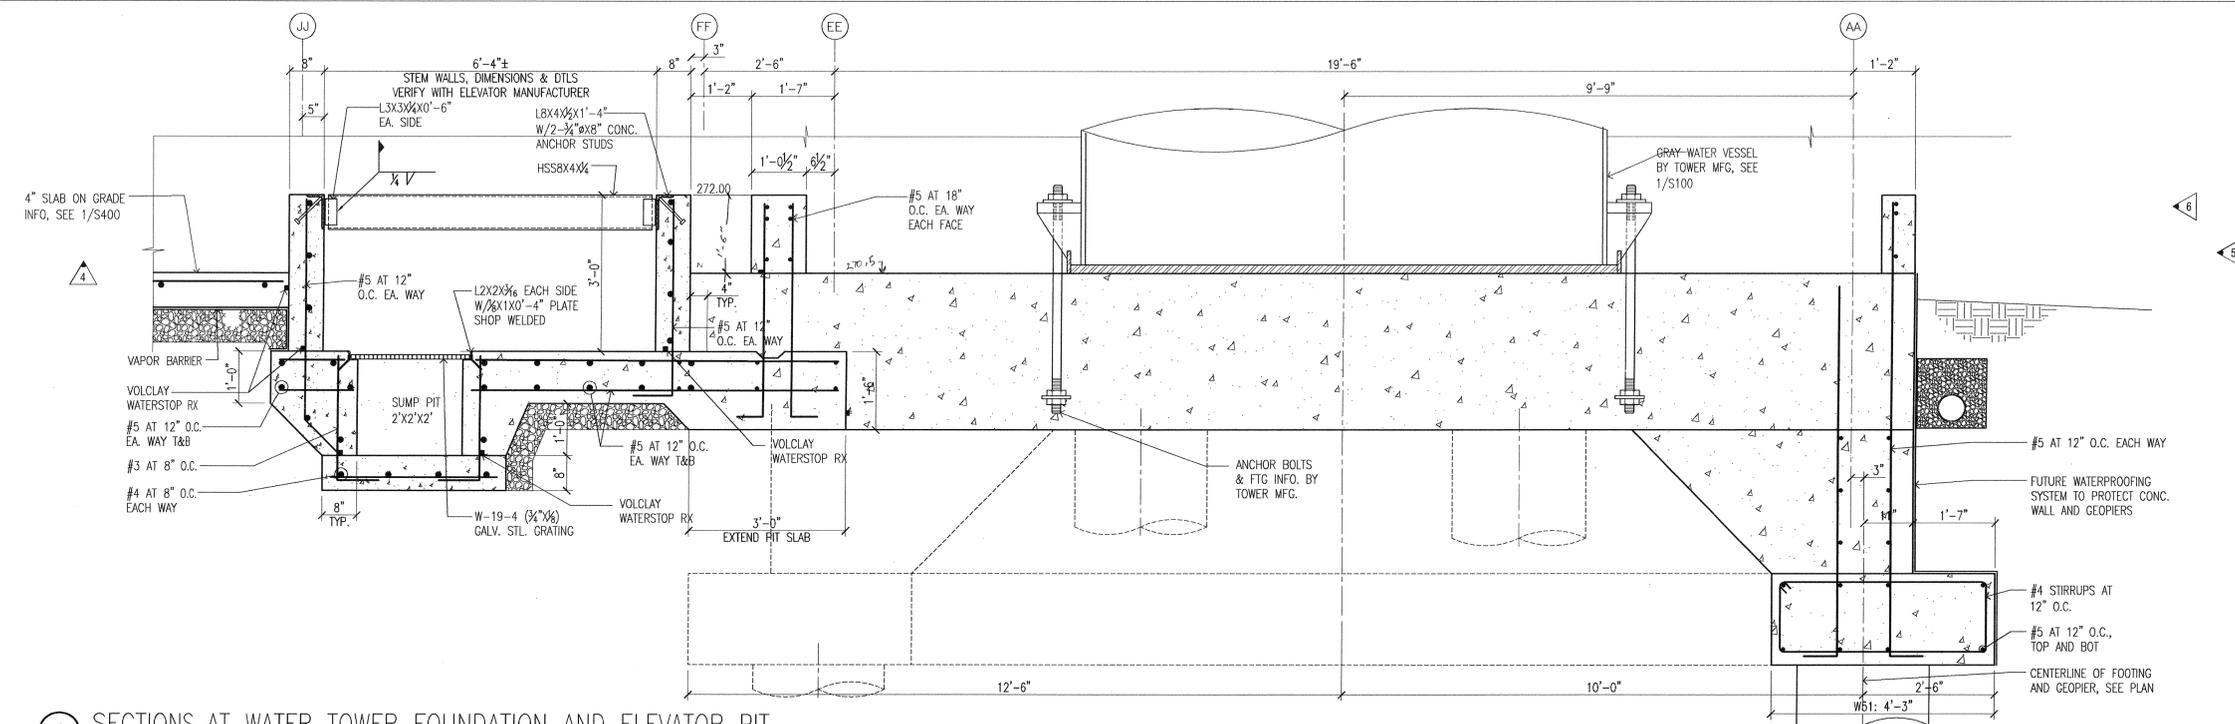


1 SECTIONS AT WATER TOWER FOUNDATION AND ELEVATOR PIT
3/4" = 1'-0"

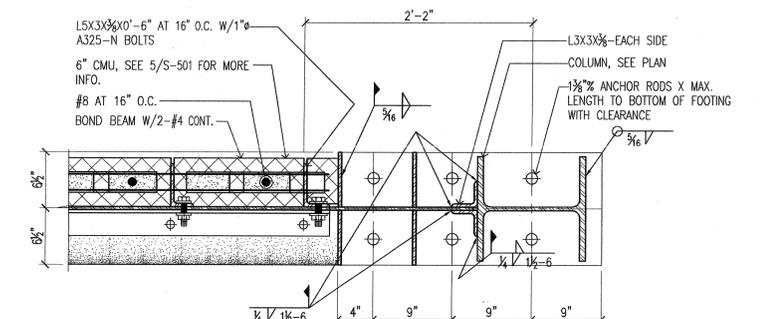

2 BASE PLATE DETAILS AT SHEAR WALL COLUMN
1/2" = 1'-0"

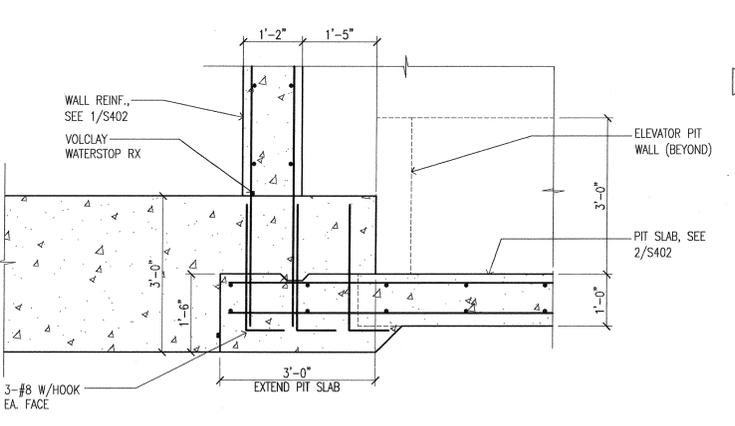


3 SECTION AT FOOTING INTERSECTION BETWEEN WATER TOWER AND ELEV. PIT FOOTINGS
3/4" = 1'-0"

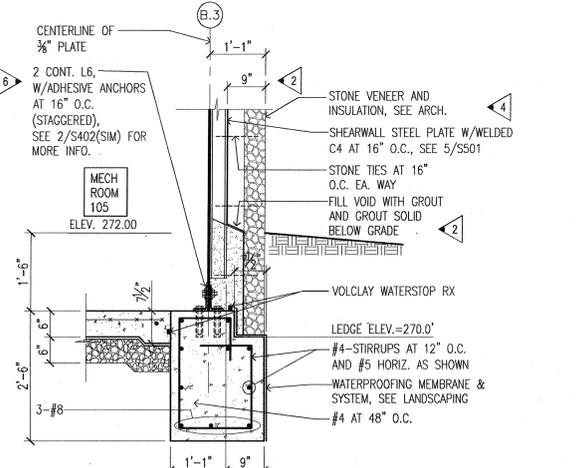

4 SECTION AT MECH. ROOM
3/4" = 1'-0" (REF. 12/A432)

5 NOT USED
NOT TO SCALE

A ELEVATION

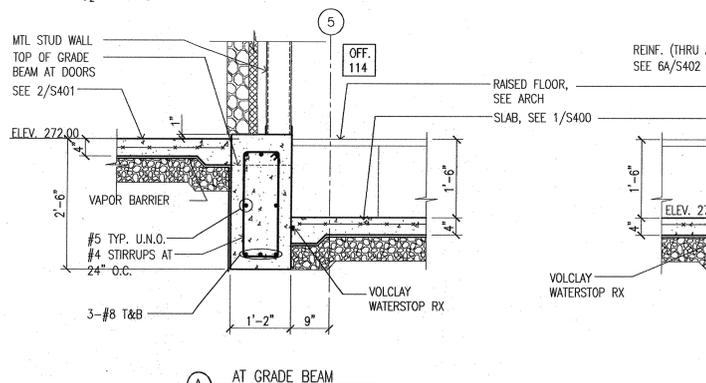

6 SECTION
3/4" = 1'-0" (REF. 6, 7/A435) (REF. 6, 7/A431)

