



FRONT FACE
ALL SPECIFIED TOP AND BOTTOM REINFORCING IS CONT. THRU JOINT.

NOTES:
1. STOP 50% OF THE HORIZ. REINF. AT FRONT FACE.
2. STOP 25% OF THE HORIZ. REINF. AT BACK FACE.
3. DO NOT SPLICE HORIZ. REINF. AT THE JOINT.
4. PROVIDE 30" SPLICE AT HORIZ. REINF.

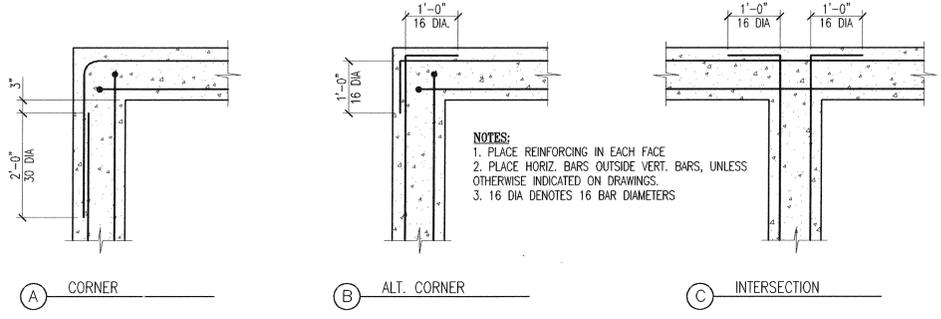


② CONCRETE BASEMENT AND GRADE BEAM REINF. DETAILS AT CORNERS
NOT TO SCALE


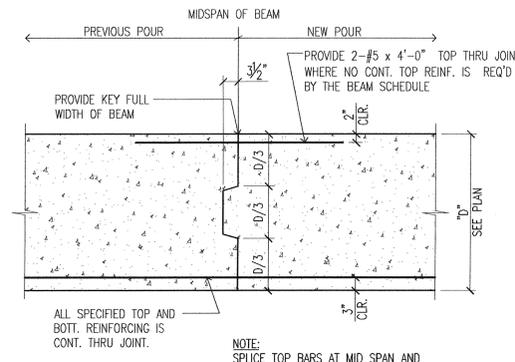


③ TYPICAL CONSTRUCTION JOINT IN GRADE BEAM
NOT TO SCALE

① TYPICAL CONTROL AND CONSTRUCTION JOINTS AT BASEMENT WALLS
NOT TO SCALE

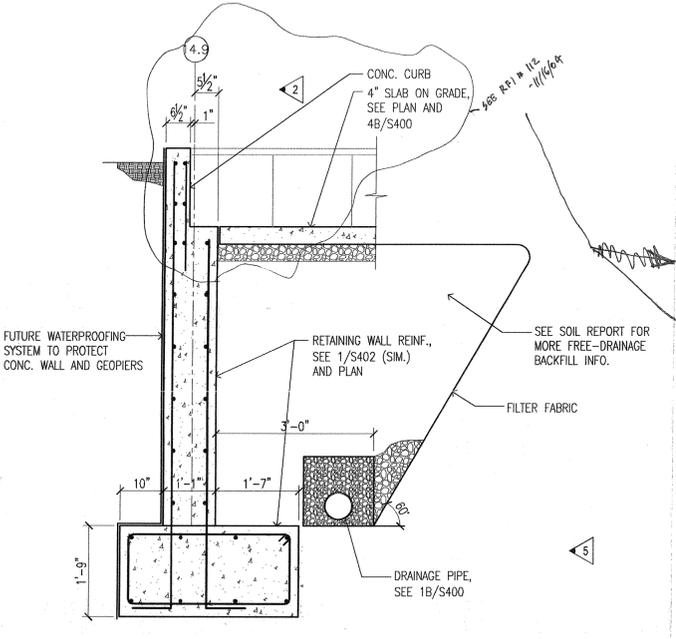


④ RETAINING WALL DETAIL
3/4\"/>

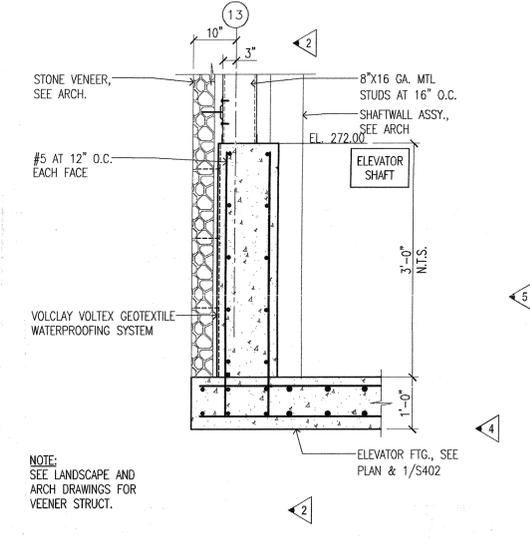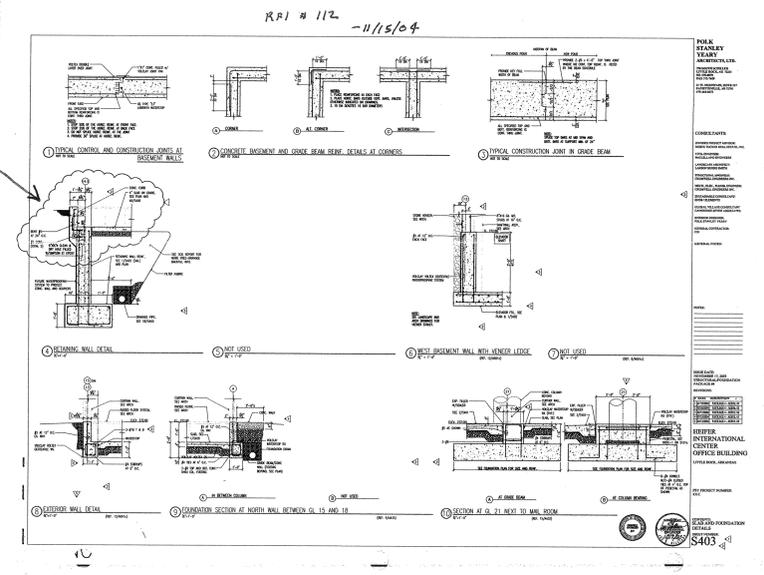


⑥ WEST BASEMENT WALL WITH VENEER LEDGE
3/4\"/>


⑦ NOT USED
3/4\"/>

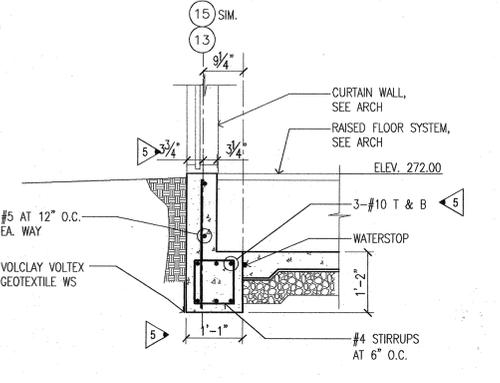

⑧ EXTERIOR WALL DETAIL
3/4\"/>

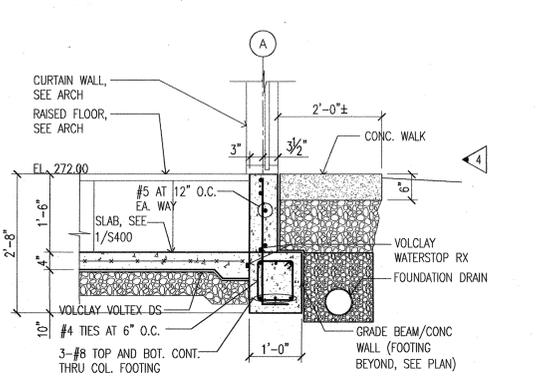

⑨ FOUNDATION SECTION AT NORTH WALL BETWEEN GL 15 AND 18
3/4\"/>

 

⑩ SECTION AT GL 21 NEXT TO MAIL ROOM
3/4\"/>

POLK STANLEY YEARY ARCHITECTS, LTD.
700 SOUTH SCHILLER
LITTLE ROCK, AR 72201
501 378-0878
FAX 372-7629

21 W. MOUNTAIN, SUITE 227
FAYETTEVILLE, AR 72701
479-444-0473

CONSULTANTS:

OWNER'S PROJECT ADVISOR:
MOSES TUCKER REAL ESTATE, INC.

CIVIL ENGINEER:
MCLELLAND ENGINEERS

LANDSCAPE ARCHITECT:
LARSON BURNS SMITH

STRUCTURAL ENGINEER:
CROMWELL ENGINEERS INC.

MECH., ELEC., PLUMB. ENGINEER:
CROMWELL ENGINEERS INC.

SUSTAINABLE CONSULTANT:
BNM / ELEMENTS

GLOBAL VILLAGE CONSULTANT
CAMBRIDGE SEVEN ASSOCIATES

INTERIOR DESIGNER:
POLK STANLEY YEARY

GENERAL CONTRACTOR:
CDI

GENERAL NOTES:

NOTES:

ISSUE DATE:
NOVEMBER 17, 2003
STRUCTURAL/FOUNDATION
PACKAGE #4

REVISIONS:

#	DATE	DESCRIPTION
1	01/19/2004	PACKAGE 4 - ADDM. 04
2	02/26/2004	PACKAGE 4 - ADDM. 05
3	03/17/2004	PACKAGE 4 - ADDM. 06
4	03/23/2004	PACKAGE 4 - ADDM. 07
5	04/13/2004	PACKAGE 4 - ADDM. 09

HEIFER INTERNATIONAL CENTER OFFICE BUILDING
LITTLE ROCK, ARKANSAS

PSY PROJECT NUMBER:
431C

CONTENTS:
SLAB AND FOUNDATION
DETAILS
SHEET NUMBER:
S403

