

**CONSULTANTS:**  
 OWNER'S PROJECT ADVISOR: MOSES TUCKER REAL ESTATE, INC.  
 CIVIL ENGINEER: MCLELLAND ENGINEERS  
 LANDSCAPE ARCHITECT: LARSON BURNS SMITH  
 STRUCTURAL ENGINEER: CROMWELL ENGINEERS INC.  
 MECH., ELEC., PLUMB. ENGINEER: CROMWELL ENGINEERS INC.  
 SUSTAINABLE CONSULTANT: BNIM / ELEMENTS  
 GLOBAL VILLAGE CONSULTANT: CAMBRIDGE SEVEN ASSOCIATES  
 INTERIOR DESIGNER: POLK STANLEY YEARY  
 GENERAL CONTRACTOR: CDI

**GENERAL NOTES:**  
 NOTE: SHAPED W10X12 FROM ROOF SHALL BE RE-USED IN THESE DTL'S BEFORE USING L'S

**NOTES:**

**ISSUE DATE:** NOVEMBER 17, 2003  
**STRUCTURAL FOUNDATION PACKAGE #4**  
**REVISIONS:**


#	DATE	DESCRIPTION
7	7/1/2003	PACKAGE 7
8	8/26/2004	ASIF#7
9	9/28/2004	ASIF#9

**HEIFER INTERNATIONAL CENTER OFFICE BUILDING**  
 LITTLE ROCK, ARKANSAS


**PSY PROJECT NUMBER:** 431C

**CONTENTS:** SHEET FRAMING DETAILS

**SHEET NUMBER:** S502

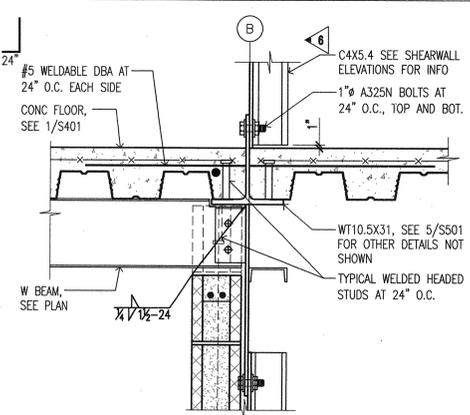


**1 2ND FLOOR BEAM CONN. AT MECH. ROOM WALL**  
 SCALE: 1/2"=1'-0" (OCCURS 2 PLACES ALONG GL 20.5)

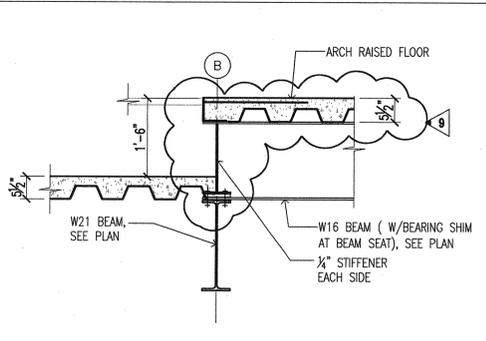


**2 SECTION AT "BRIDGE"**  
 SCALE: 3/4"=1'-0"

**3 NOT USED**  
 SCALE: 1/2"=1'-0"

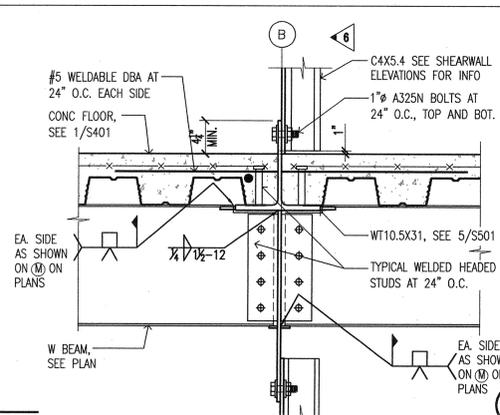


**4 MOMENT BEAM CONN.**  
 SCALE: 1/2"=1'-0"


**5 NOT USED**  
 SCALE: 3/4"=1'-0"

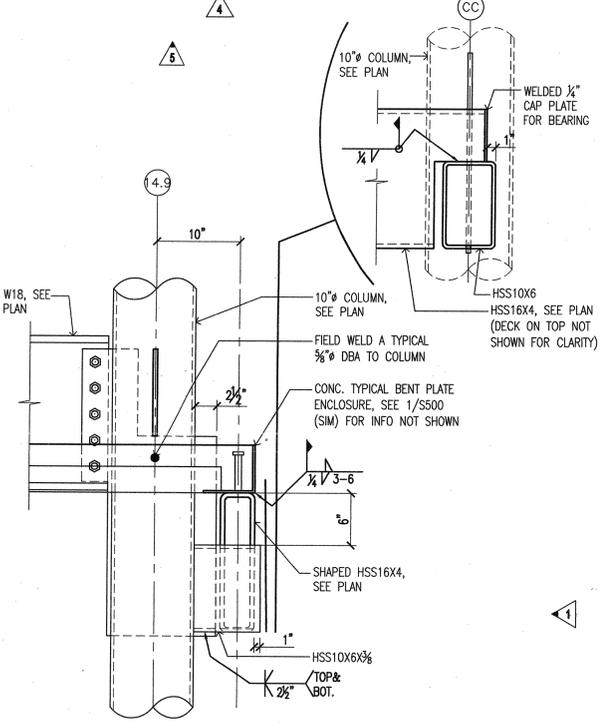


**6 SECTION AT COLUMN SEAT**  
 SCALE: 1/2"=1'-0"

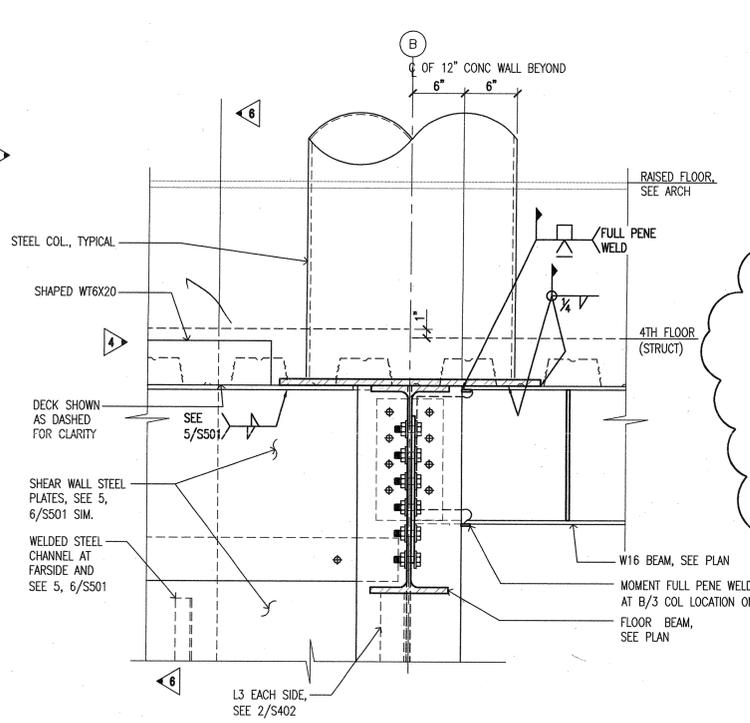


**7 EL. AT 4TH FLOOR ROUND COL. BEARING ON WF COLUMN BELOW**  
 SCALE: 1/2"=1'-0"

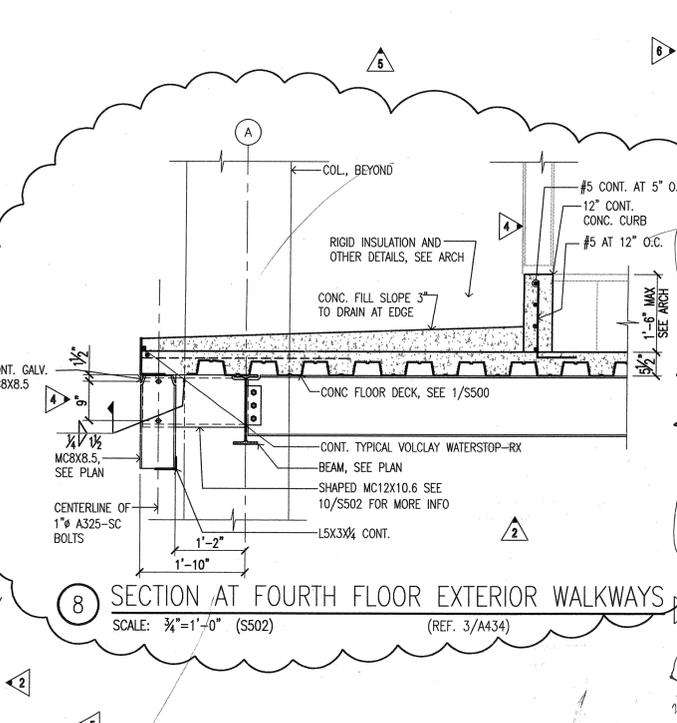


**8 SECTION AT FOURTH FLOOR EXTERIOR WALKWAYS**  
 SCALE: 3/4"=1'-0" (S502) (REF. 3/A434)

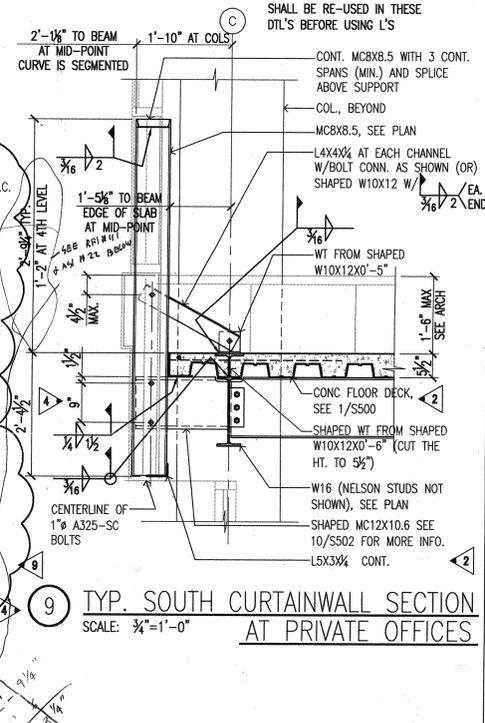


**9 TYP. SOUTH CURTAINWALL SECTION AT PRIVATE OFFICES**  
 SCALE: 3/4"=1'-0"

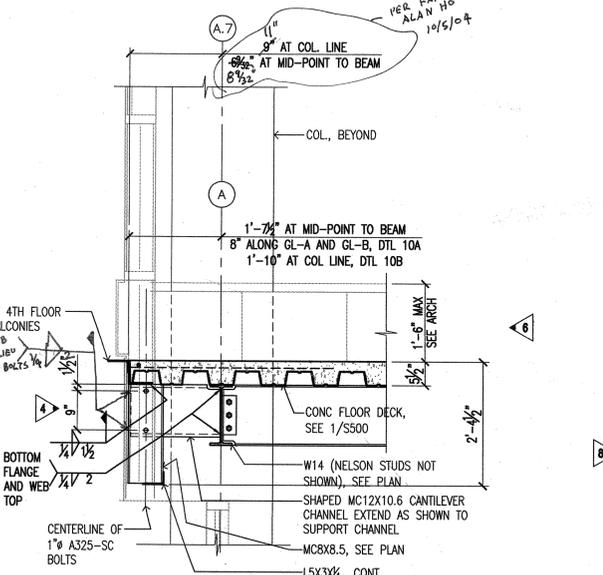

**10 TYP. CURTAIN WALL DETAIL OTHER THAN DETAIL 9/S502**  
 SCALE: 3/4"=1'-0"

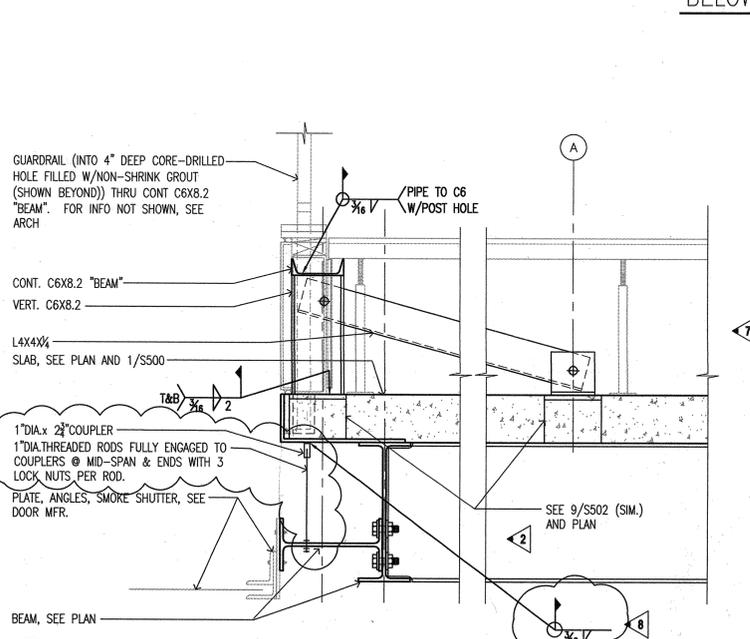

**11 HANDRAIL SUPPORT DETAIL**  
 SCALE: 1/2"=1'-0"

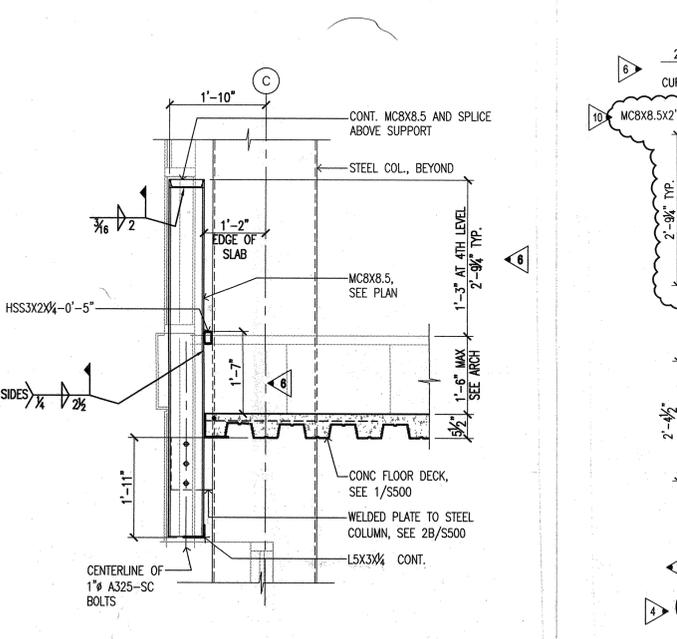

**12 TYP. SOUTH CURTAINWALL SECTION AT PRIVATE OFFICES**  
 SCALE: 3/4"=1'-0"