

CONSULTANTS:

OWNER'S PROJECT ADVISOR:
MOSES TUCKER REAL ESTATE, INC.

CIVIL ENGINEER:
McCLELLAND ENGINEERS

LANDSCAPE ARCHITECT:
LARSON BURNS SMITH

STRUCTURAL ENGINEER:
CROMWELL ENGINEERS INC.

MECH., ELEC., PLUMB. ENGINEER:
CROMWELL ENGINEERS INC.

SUSTAINABLE CONSULTANT:
BNIM / ELEMENTS

GLOBAL VILLAGE CONSULTANT
CAMBRIDGE SEVEN ASSOCIATES

INTERIOR DESIGNER:
POLK STANLEY YEARY

GENERAL CONTRACTOR:
CDI

GENERAL NOTES:

NOTES:

ISSUE DATE:
NOVEMBER 17, 2003
STRUCTURAL FOUNDATION
PACKAGE #4

REVISIONS:













#	DATE	DESCRIPTION
1	12/1/2003	ADDENDUM 1
2	12/11/2003	ADDENDUM 2
3	01/19/2004	PACKAGE 4 - ADDM. 04
4	02/26/2004	PACKAGE 4 - ADDM. 05
5	07/01/2004	PACKAGE-7
6	07/16/2004	ASH10

**HEIFER
INTERNATIONAL
CENTER
OFFICE BUILDING**
LITTLE ROCK, ARKANSAS

PSY PROJECT NUMBER:
431C

CONTENTS:
ROOF FRAMING DETAILS

SHEET NUMBER:
S601

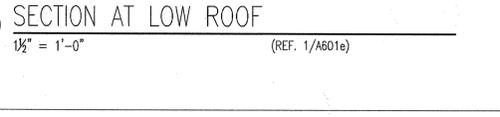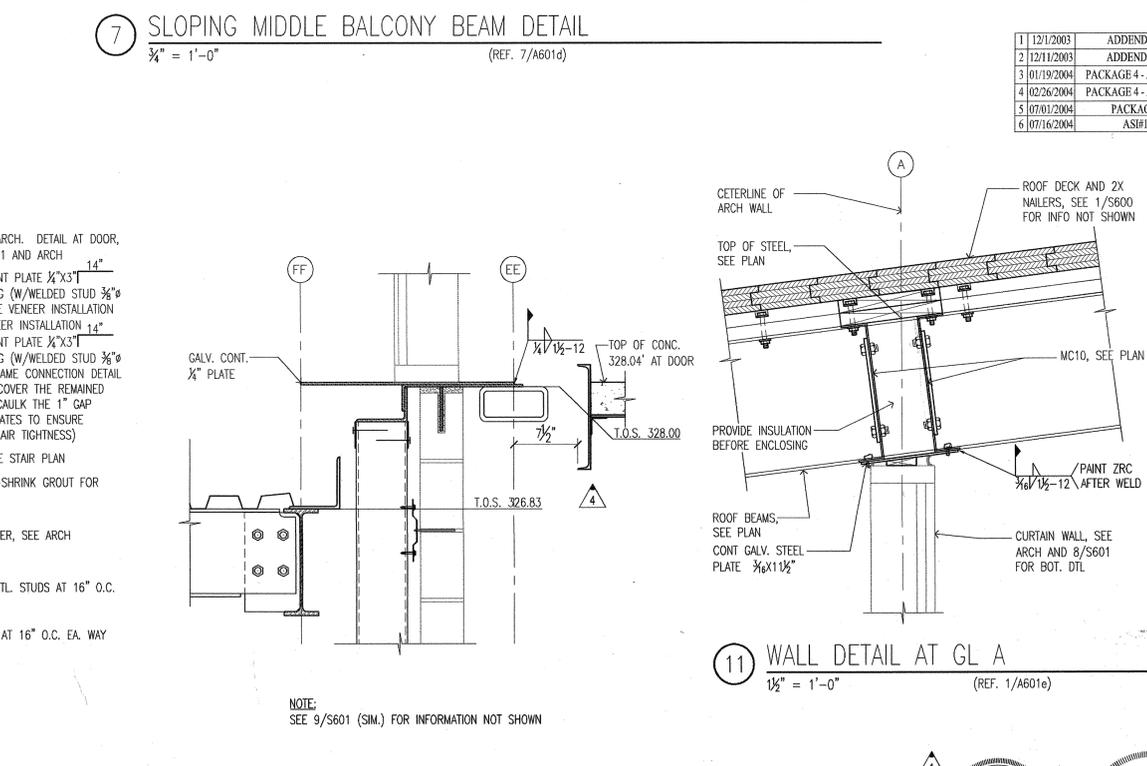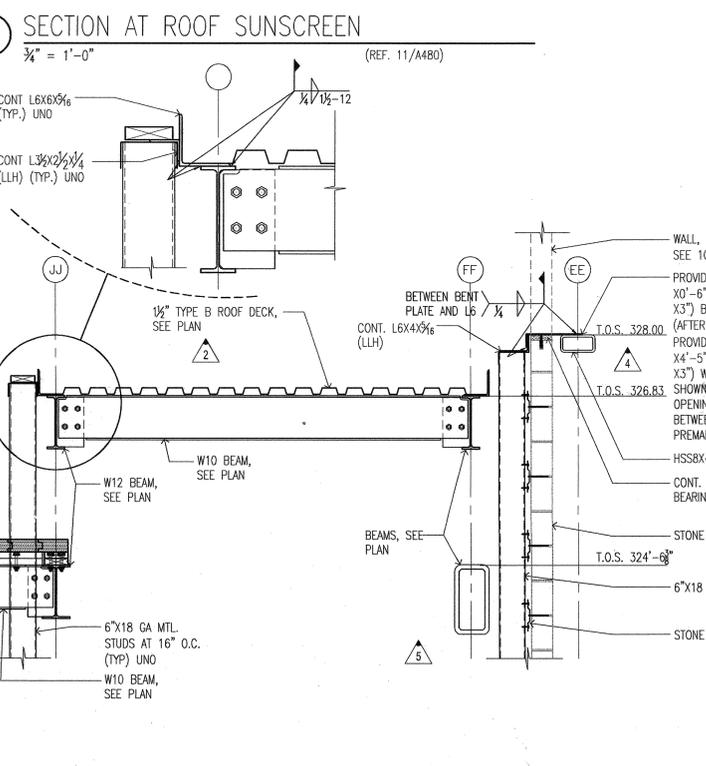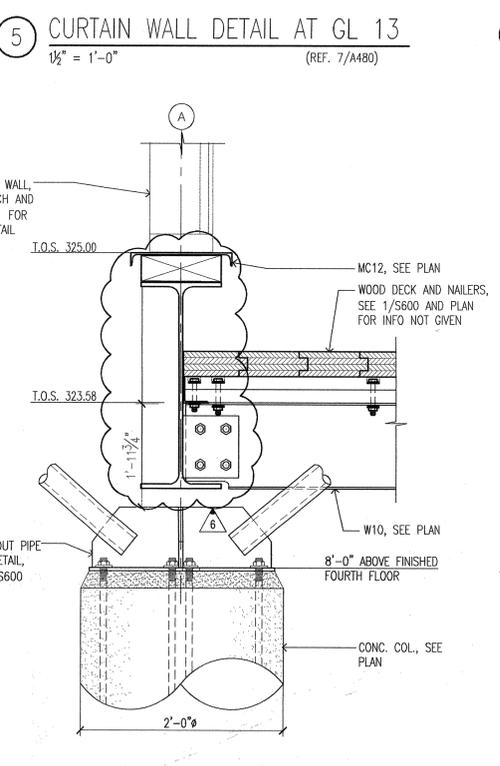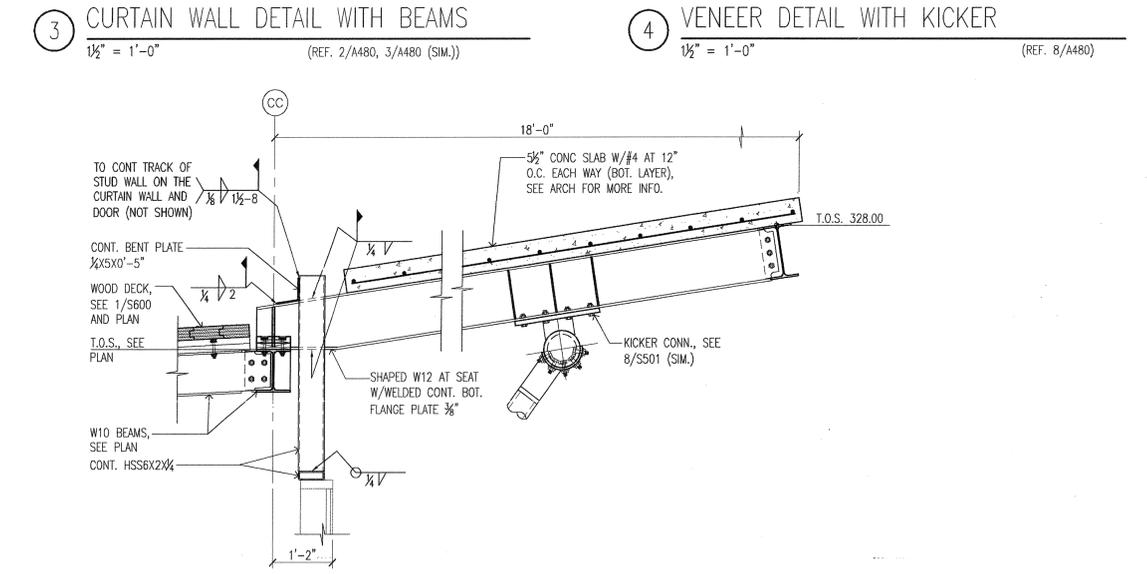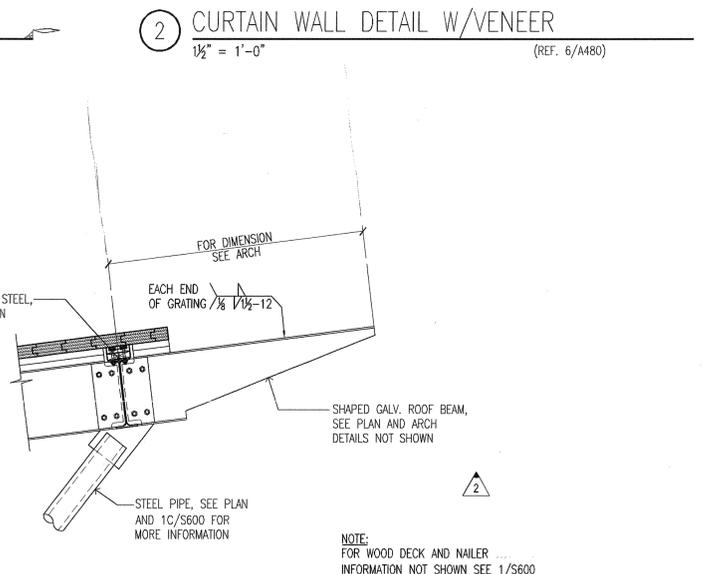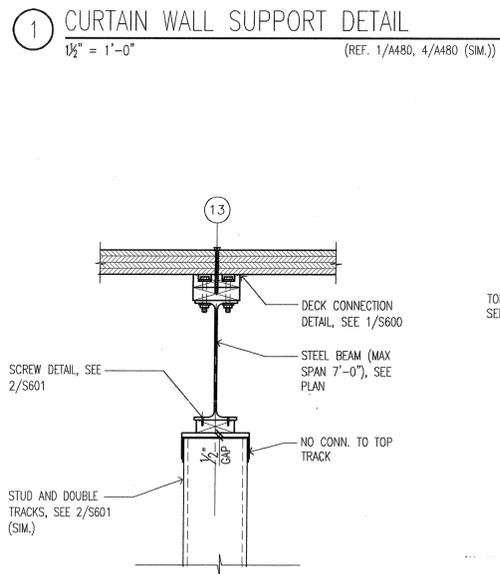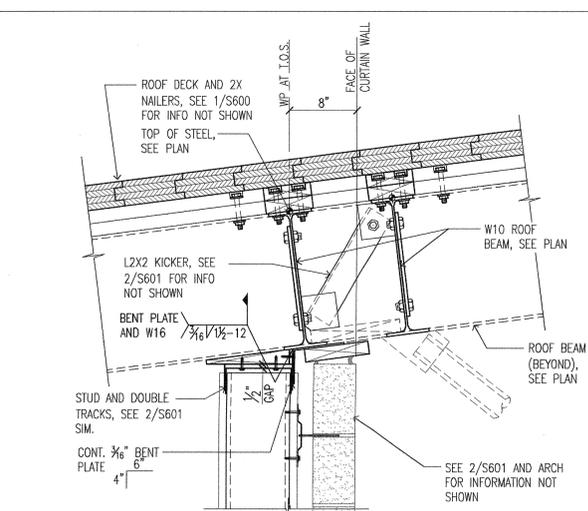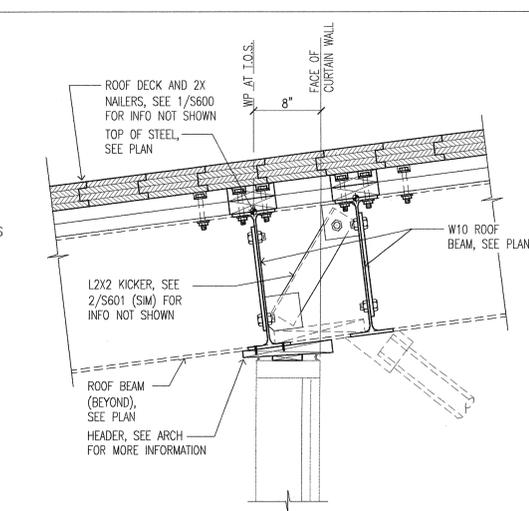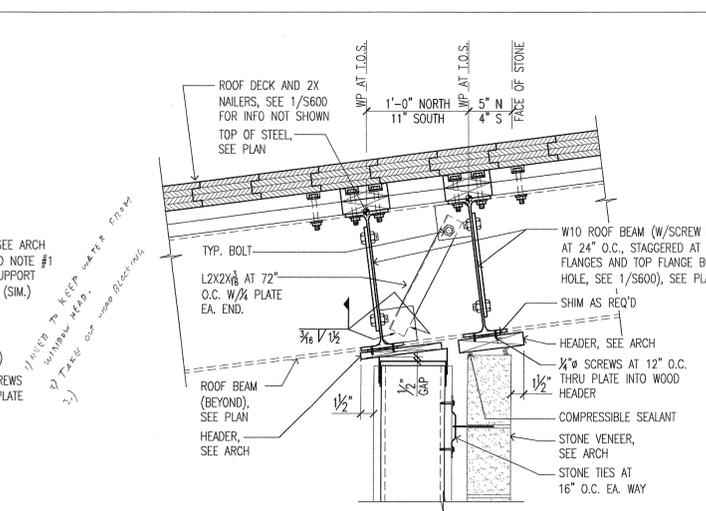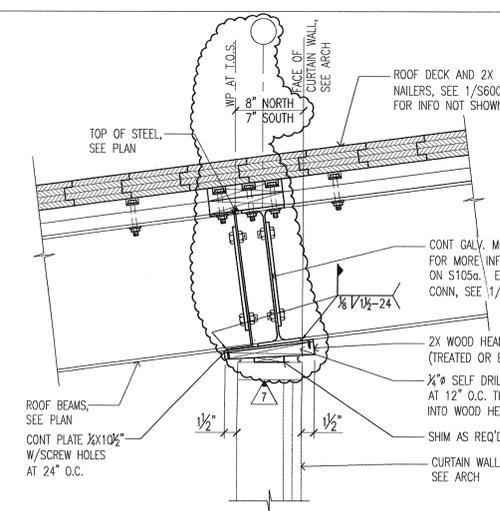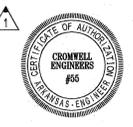

F:\Projects\2001\2001_066\2001066.dwg, S601.dwg, 08/27/2004 10:29:34 AM