

CONSULTANTS:

OWNER'S PROJECT ADVISOR:
MOSES TUCKER REAL ESTATE, INC.

CIVIL ENGINEER:
McCLELLAND ENGINEERS

LANDSCAPE ARCHITECT:
LARSON BURNS SMITH

STRUCTURAL ENGINEER:
CROMWELL ENGINEERS INC.

MECH., ELEC., PLUMB. ENGINEER:
CROMWELL ENGINEERS INC.

SUSTAINABLE CONSULTANT:
BNIM / ELEMENTS

GLOBAL VILLAGE CONSULTANT
CAMBRIDGE SEVEN ASSOCIATES

INTERIOR DESIGNER:
POLK STANLEY YEARY

GENERAL CONTRACTOR:
CDI

GENERAL NOTES:

NOTES:

ISSUE DATE:
DECEMBER 15, 2003
CORE/SHELL
PACKAGE #5

REVISIONS:

#	DATE	DESCRIPTION
1	04/01/2004	PACKAGE 4 - ADDM. 08
2	04/13/2004	PACKAGE 4 - ADDM. 09
3	08/26/2004	ASI #16

**HEIFER
INTERNATIONAL
CENTER
OFFICE BUILDING**

LITTLE ROCK, ARKANSAS

PSY PROJECT NUMBER:
431C

CONTENTS:
STUD WALL DETAILS



SHEET NUMBER:

S700


EXTERIOR METAL WALL STUD SCHEDULE

SPAN*	STUD DESIGNATION	DEPTH	FLANGE	LIP	GAUGE	SPACING	Ix (IN ⁴)	Sx (IN ³)	REMARKS
12'-0" (MAX.)	600S162-54	6"	1 3/8"	3/8"	16	16" O.C.	2.86	0.953	15'-0" FROM CORNER
15'-0" (MAX.)	600S250-54	6"	2 1/2"	3/8"	16	16" O.C.	3.8	1.27	15'-0" FROM CORNER
12'-0" (MAX.)	600S200-54	6"	2"	3/8"	16	16" O.C.	3.3	1.1	WITHIN 15'-0" OF CORNER
15'-0" (MAX.)	600S250-68	6"	2 1/2"	3/8"	14	16" O.C.	4.7	1.57	WITHIN 15'-0" OF CORNER
12'-0" (MAX.)	800S162-33	8"	1 1/2"	3/8"	20	16" O.C.	3.58	0.896	15'-0" FROM CORNER
15'-0" (MAX.)	800S162-43	8"	1 1/2"	3/8"	18	16" O.C.	5.73	1.43	15'-0" FROM CORNER
12'-0" (MAX.)	800S162-54	8"	1 1/2"	3/8"	18	16" O.C.	4.63	1.158	WITHIN 15'-0" OF CORNER
15'-0" (MAX.)	800S162-54	8"	1 1/2"	3/8"	16	16" O.C.	5.73	1.43	WITHIN 15'-0" OF CORNER

* MEASURED FROM BOTTOM OF STUD TO BRACE ABOVE CEILING, OR TO CONNECTION AT FLOOR OR ROOF STRUCTURE ABOVE.

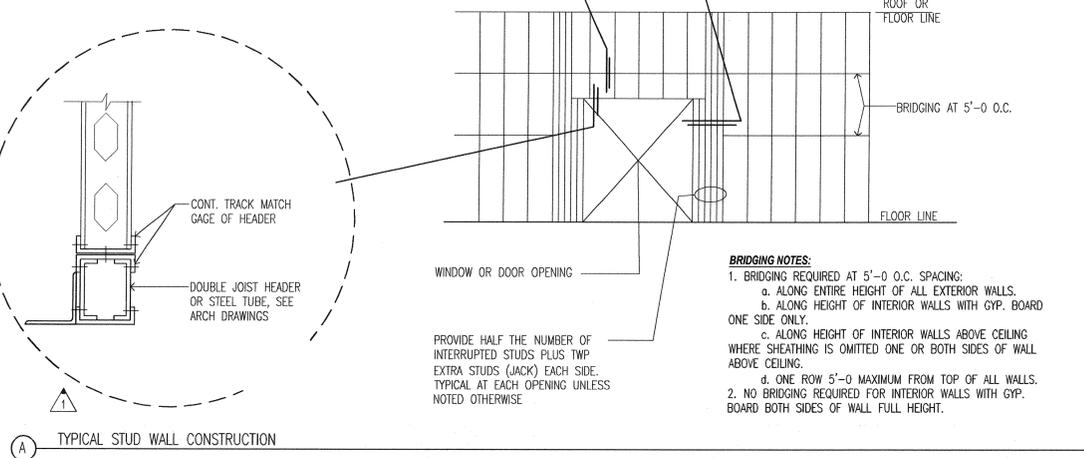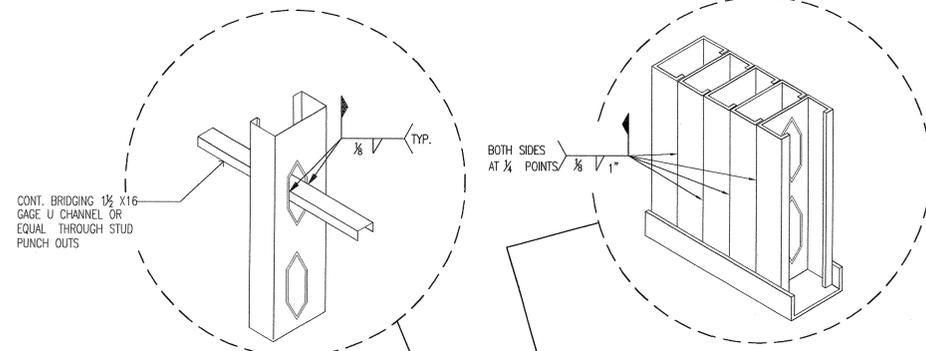


1 COLD-FORMED STEEL FRAMING (METAL STUD WALL) DETAILS
NOT TO SCALE

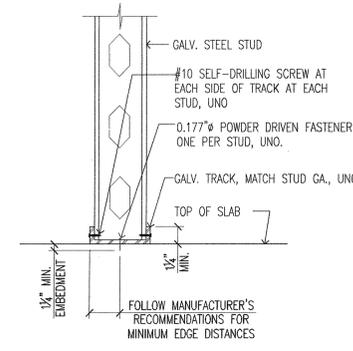


2 DETAILS OF STONE VENEER ANCHORAGE
SCALE: 1/2" = 1'-0"

3 HI-BEAM DETAIL AT SEISMIC JOINT

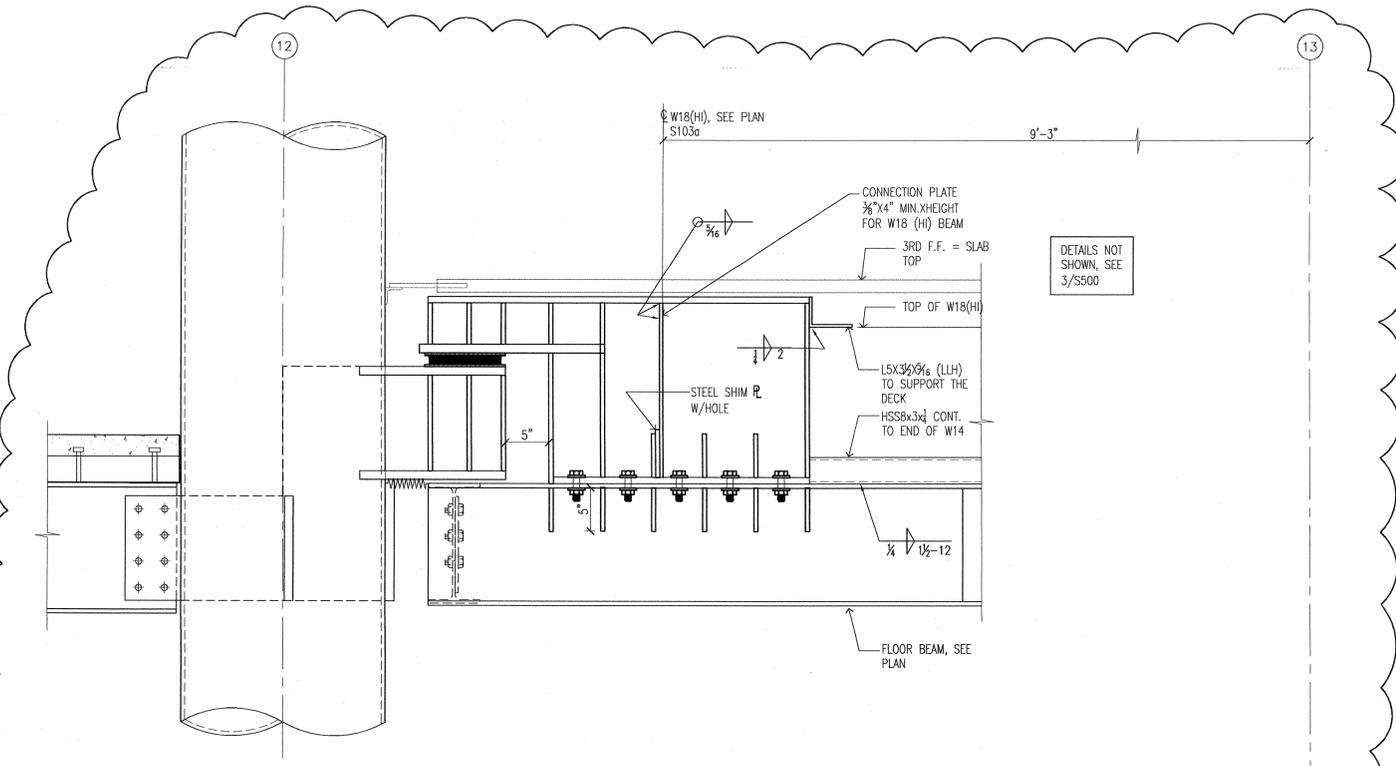

4 LINTEL AT CONCRETE WALL OPENING

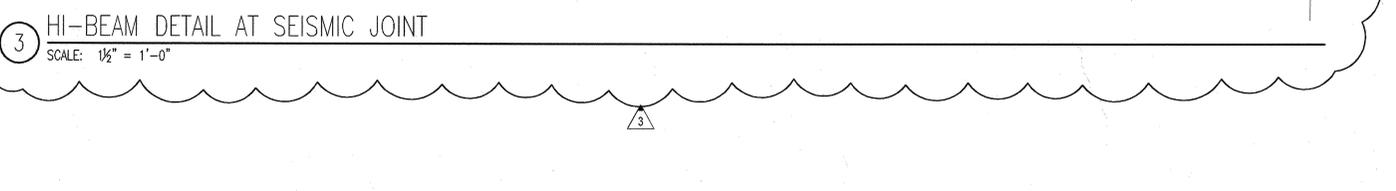

5 LINTEL AT CONCRETE WALL OPENING

F:\Projects\2001\2001_066\2001066.dwg, 08/27/2004 10:31:10 AM

