



CONSULTANTS:
CIVIL ENGINEER:
MCCLELLAND ENGINEERS
LANDSCAPE ARCHITECT:
LARSON BURNS SMITH
STRUCTURAL ENGINEER:
CROMWELL ENGINEERS INC.
MECH., ELEC., PLUMB. ENGINEER:
CROMWELL ENGINEERS INC.
GLOBAL VILLAGE CONSULTANT
CAMBRIDGE SEVEN ASSOCIATES
INTERIOR DESIGNER:
POLK STANLEY ROWLAND
CURZON PORTER ARCHITECTS
GENERAL CONTRACTOR:
CDI CONTRACTORS, INC.

NOTES:
1. ALL GLAZED WALL SYSTEMS SHALL BE ALUMINUM STOREFRONT UNLESS NOTED OTHERWISE
2. ALL GLAZING SHALL BE CLEAR INSULATED TYPE (I) UNLESS NOTED OTHERWISE
3. SEE GENERAL FINISH NOTES ON A801 FOR EXTERIOR FINISHES

ISSUE DATE:
17 SEPTEMBER 07

REVISIONS:


#	DATE	DESCRIPTION:
1	07 JAN 08	ASH NO. 1
2	24 MAR 08	ASH NO. 4
4	25 APR 08	ASH NO. 10
3	07 MAY 08	ASH NO. 13

**MURPHY KELLER
EDUCATION CENTER**

**HEIFER
INTERNATIONAL
CENTER**
LITTLE ROCK, ARKANSAS

PRSCP JOB NUMBER:
431E
CONTENTS:
BUILDING ELEVATIONS

SHEET NUMBER:
A201

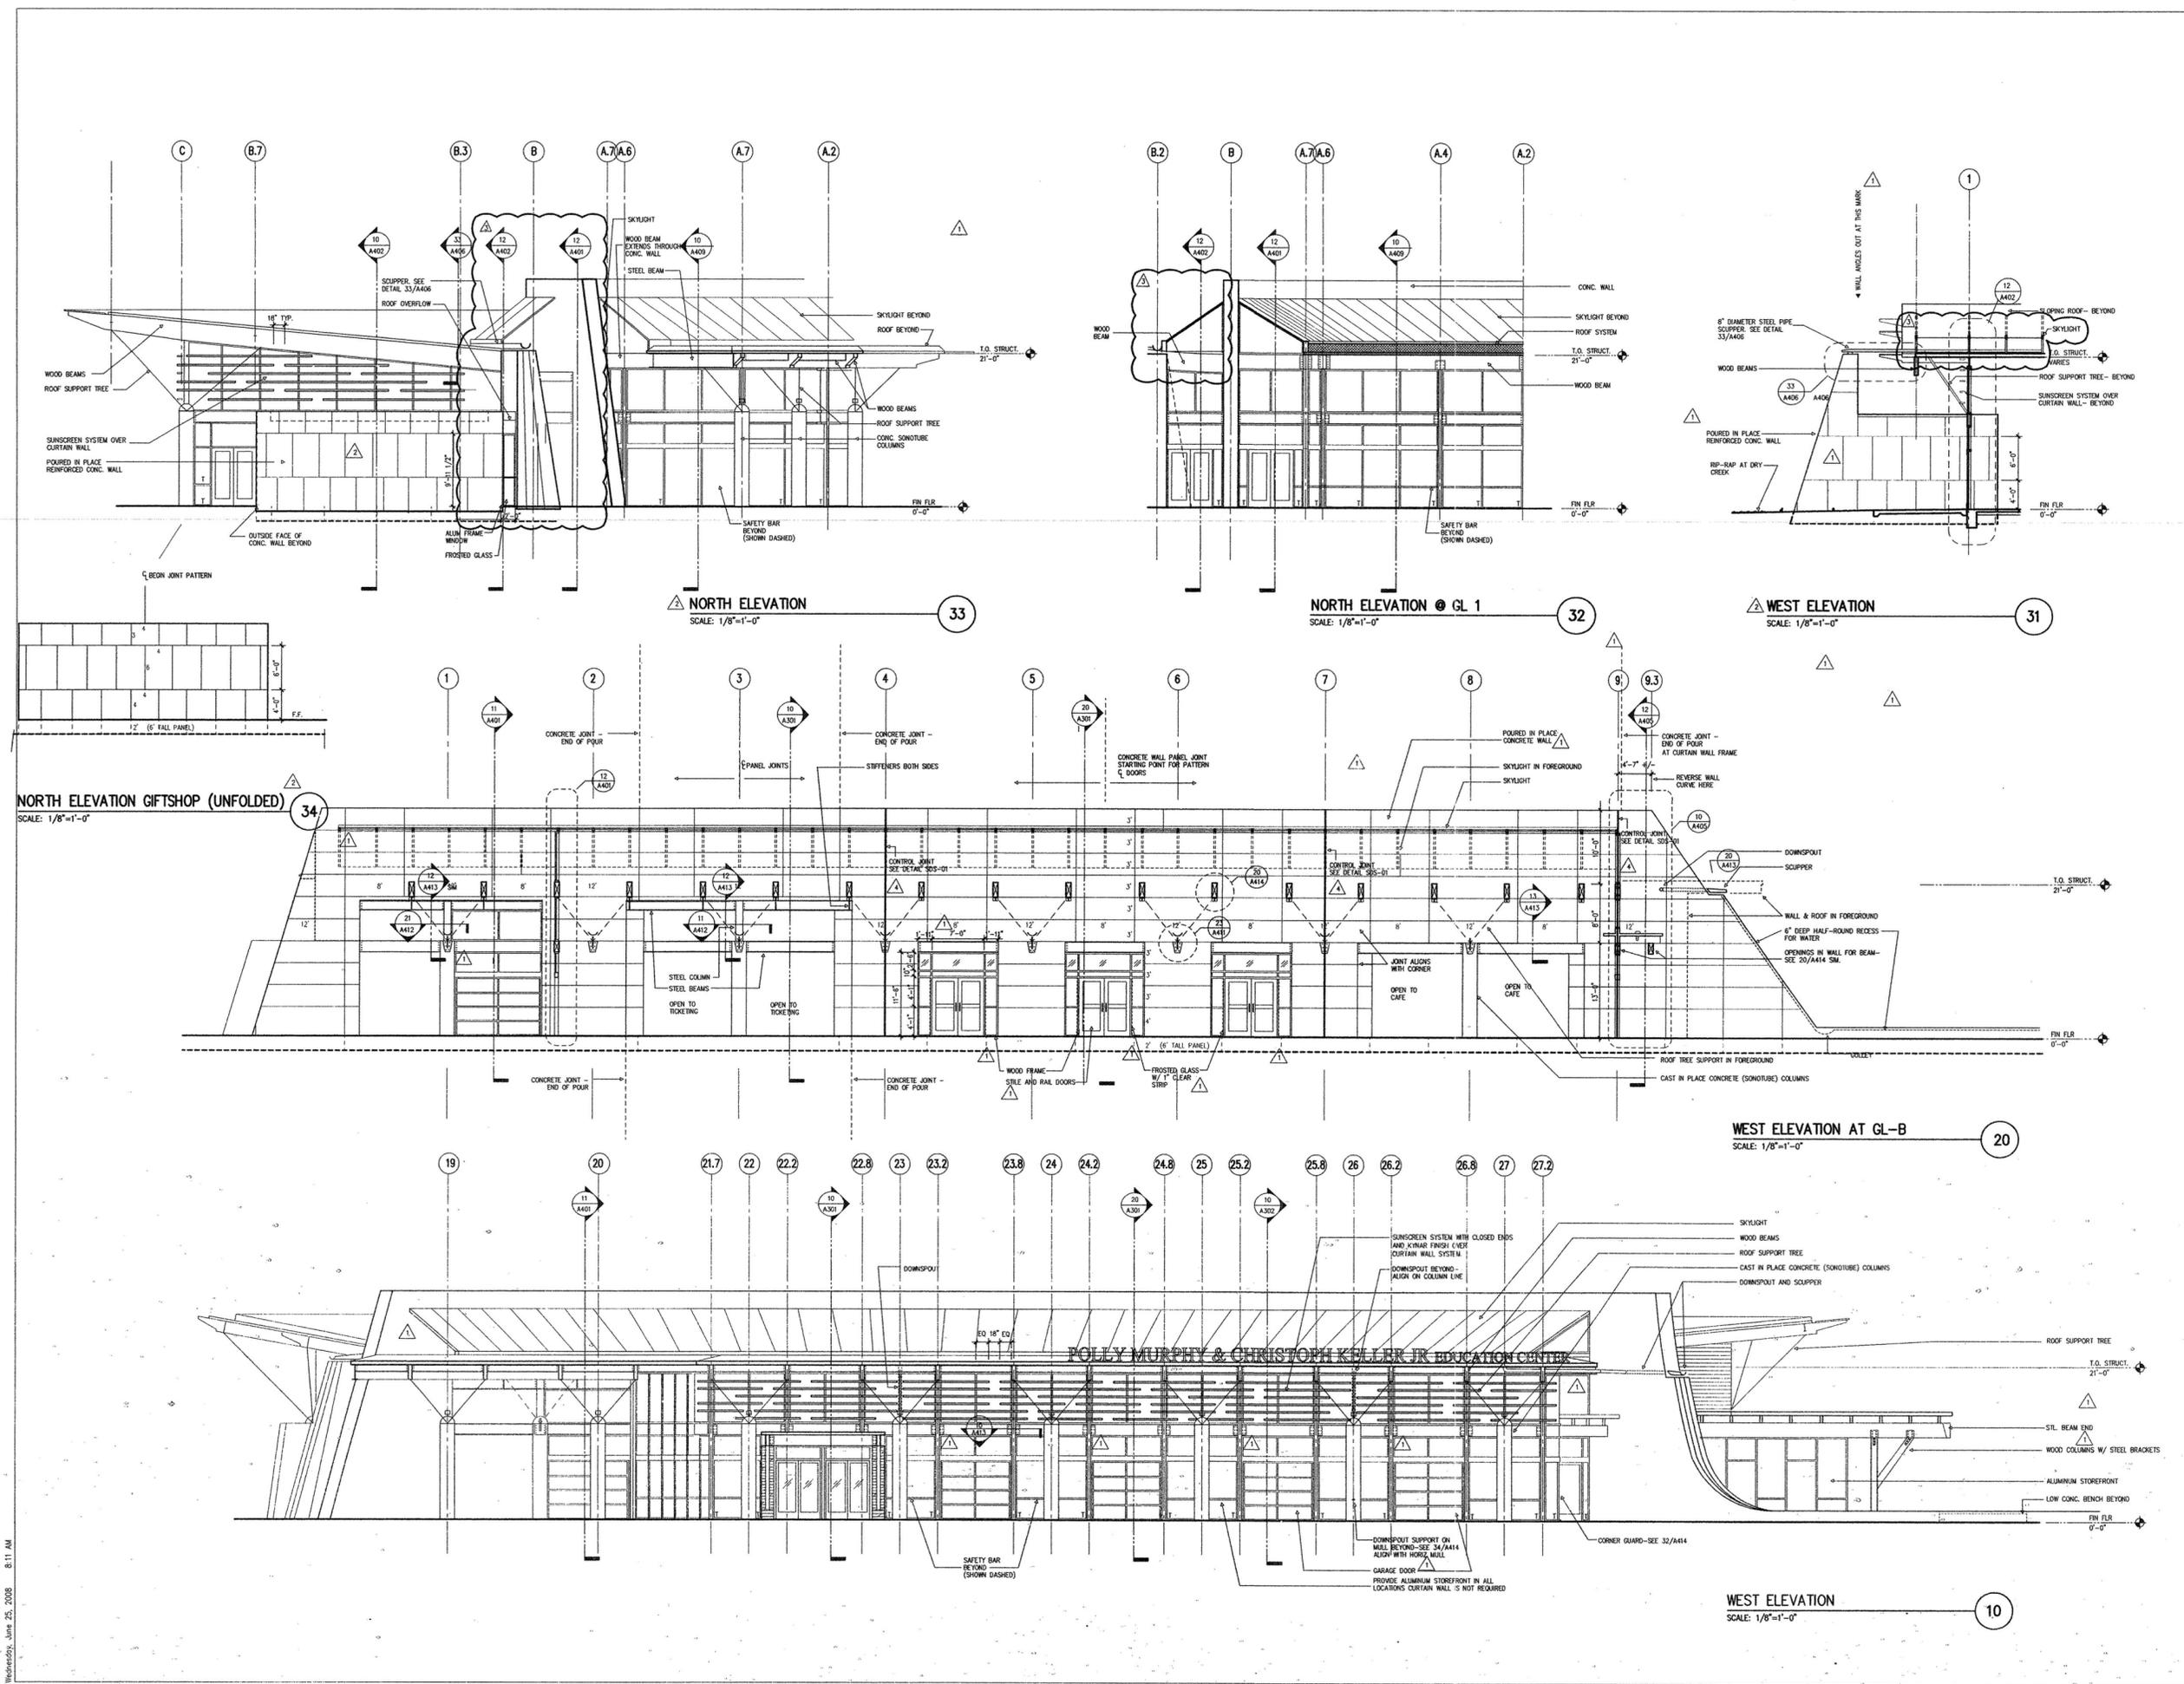

Wednesday, Jan 23, 2008 8:11 AM
 W:\Projects\431E\A201.dwg