
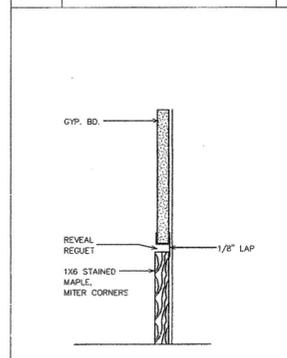
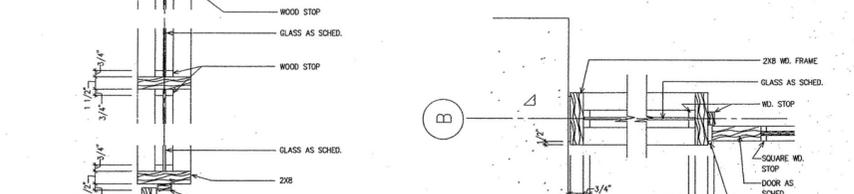
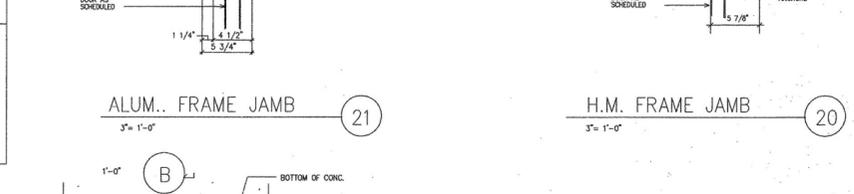
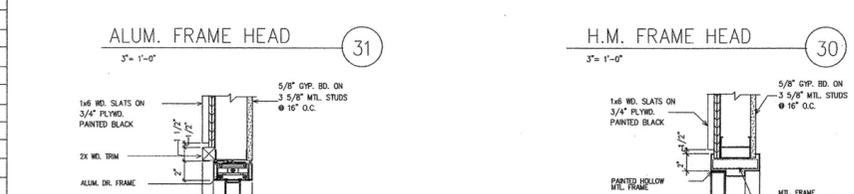
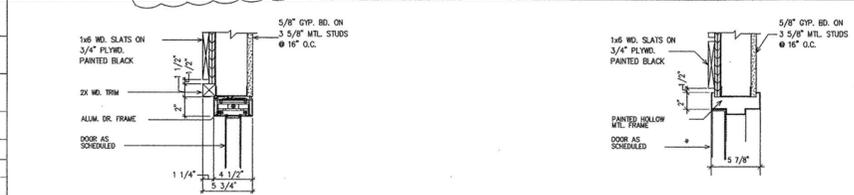


DOOR & FRAME SCHEDULE									
DOOR NUMBER	ROOM NAME	DOOR		FRAME				HARDWARE	REMARKS
		TYPE	WIDTH	HEIGHT	THRESHOLD	HEAD	JAMB		
100	EXHIBITS	A	3'-0" (PAIR)	8'-0"	---	---	---	---	DRIP AT HEAD
100a	EXHIBITS	A	3'-0" (PAIR)	8'-0"	---	---	---	---	DRIP AT HEAD, PANIC
100b	EXHIBITS	SEE 10/A201	9'-5"	8'-0"	---	---	---	---	---
100c	EXHIBITS	SEE 10/A201	9'-5"	8'-0"	---	---	---	---	---
100d	EXHIBITS	SEE 10/A201	9'-5"	8'-0"	---	---	---	---	---
100e	EXHIBITS	SEE 10/A201	9'-5"	8'-0"	---	---	---	---	---
101	VESTIBULE	A	3'-0" (PAIR)	8'-0"	---	---	---	---	DRIP AT HEAD, PANIC
101a	VESTIBULE	A	3'-0" (PAIR)	8'-0"	---	---	---	---	DRIP AT HEAD, PANIC
101b	VESTIBULE	A	3'-0" (PAIR)	8'-0"	---	---	---	---	---
101c	VESTIBULE	A	3'-0" (PAIR)	8'-0"	---	---	---	---	---
102	EXHIBITS/ EDUCATION	A	3'-0" (PAIR)	8'-0"	---	---	---	---	PANIC
102a	EXHIBITS/ EDUCATION	A	3'-0" (PAIR)	8'-0"	---	---	---	---	---
102b	EXHIBITS/ EDUCATION	A	3'-0" (PAIR)	8'-0"	---	---	---	---	PANIC
103	GIFT SHOP	A	3'-0" (PAIR)	8'-0"	---	---	---	---	DRIP AT HEAD
103a	GIFT SHOP	A	3'-0" (PAIR)	8'-0"	---	---	---	---	DRIP AT HEAD
103b	GIFT SHOP	A	3'-0" (PAIR)	8'-0"	---	---	---	---	---
103c	GIFT SHOP	SEE 33/A201	10'-0"	8'-0"	---	---	---	---	---
104	STORAGE	C	3'-0"	7'-0"	---	---	---	---	KICKPLATE
104a	STORAGE	C	4'-0"	8'-0"	---	---	---	---	KICKPLATE
105	OFFICE	C	3'-0"	7'-0"	---	---	---	---	KICKPLATE
105a	OFFICE	B	3'-0"	7'-0"	---	---	---	---	POCKET DOOR
106	MECHANICAL	B	4'-0"	7'-0"	---	---	---	---	WEATHERSTRIP FOR SOUND
107	WOMEN	B	3'-0"	7'-0"	---	---	---	---	KICKPLATE
107a	WOMEN	B	3'-0"	7'-0"	---	---	---	---	KICKPLATE
108	MEN	B	3'-0"	7'-0"	---	---	---	---	KICKPLATE
108a	MEN	B	3'-0"	7'-0"	---	---	---	---	KICKPLATE
109	JANITOR	B	3'-0"	7'-0"	---	---	---	---	KICKPLATE
110	MULTI-PURPOSE ROOM	F	3'-6" (PAIR)	8'-0"	---	---	---	---	PANIC
110a	MULTI-PURPOSE ROOM	F	3'-6" (PAIR)	8'-0"	---	---	---	---	PANIC
110b	MULTI-PURPOSE ROOM	A	3'-0"	8'-0"	---	---	---	---	DRIP @ HEAD
110c	MULTI-PURPOSE ROOM	A	3'-0"	8'-0"	---	---	---	---	DRIP @ HEAD
110d	MULTI-PURPOSE ROOM	A	3'-0"	8'-0"	---	---	---	---	DRIP @ HEAD
110e	MULTI-PURPOSE ROOM	A	3'-0"	8'-0"	---	---	---	---	DRIP @ HEAD
110f	MULTI-PURPOSE ROOM	A	3'-0"	8'-0"	---	---	---	---	DRIP @ HEAD
110g	MULTI-PURPOSE ROOM	A	3'-0" (PAIR)	8'-0"	---	---	---	---	PANIC
111	STORAGE	B	3'-0" (PAIR)	8'-0"	---	---	---	---	KICKPLATE
112	STORAGE	B	4'-0"	7'-0"	---	---	---	---	KICKPLATE
113	SERVER	B	4'-0"	8'-0"	---	---	---	---	KICKPLATE
114	FOOD SERV.	C	4'-0"	7'-0"	---	---	---	---	KICKPLATE
114a	FOOD SERV.	B	3'-0"	7'-0"	---	---	---	---	KICKPLATE
115	CAFE	A	3'-0" (PAIR)	8'-0"	---	---	---	---	---
115a	CAFE	A	3'-0" (PAIR)	8'-0"	---	---	---	---	---
115b	CAFE	A	3'-0" (PAIR)	8'-0"	---	---	---	---	---
115	CAFE	A	3'-0" (PAIR)	8'-0"	---	---	---	---	---
116	KITCHEN	D	4'-0"	7'-0"	---	---	---	---	---
116a	KITCHEN	C	3'-0" (PAIR)	8'-0"	---	---	---	---	KICKPLATE
116b	KITCHEN	C	3'-0" (PAIR)	8'-0"	---	---	---	---	KICKPLATE
117	WATER	D	4'-0"	7'-0"	---	---	---	---	---
1M00	MECHANICAL MEZZANINE	D	3'-0"	7'-0"	---	---	---	---	PANIC
119	FOLDING DOOR RM.	B	3'-0" (PAIR)	8'-0"	---	---	---	---	---

FINISH SCHEDULE									
ROOM NUMBER	ROOM NAME	FLOOR	BASE	WALLS	CEILING	REMARKS			
100	EXHIBITS	CONC. - ST. WITH PATTERN	(NONE)	CONC./CW/WW	EXP. STRUCT.				
101	VESTIBULE	ENTRY MAT	(NONE)	STONE	EXP. STRUCT.				
102	EXHIBITS/ EDUCATION	CONC. - ST WITH PATTERN	(NONE)/ B1 @ RESTROOM	WOOD/CW/WW ACCENT PAINT	EXP. STRUCT./ GB @ RESTROOM VEST.	ACCENT PAINT			
103	GIFT SHOP	CARPET TILE	B1	CONC./CW/WW/GB	EXP. STRUCT.	ACCENT PAINT			
104	STORAGE	CONC.	B2	GB	EXP. STRUCT.				
105	OFFICE	CARPET TILE	B2	GB	EXP. STRUCT.				
106	MECHANICAL	CONC.	B2	GB	EXP. STRUCT.				
107	WOMEN	CONC. - ST	T1	T1 (75%) & T2 (25%)	GB	EPOXY PAINT ACCENT PAINT			
108	MEN	CONC. - ST	T1	T1 (75%) & T2 (25%)	GB	EPOXY PAINT ACCENT PAINT			
109	JANITOR	CONC. - ST	B2	GB	EXP. STRUCT.	EPOXY PAINT			
110	MULTI-PURPOSE ROOM	CARPET TILE A, B, C, & D RANDOM MIX	B1	CONC./CW/GB	EXP. STRUCT.	ACCENT PAINT			
111	STORAGE	CARPET TILE A, B, C, & D RANDOM MIX	B2	GB	EXP. STRUCT.				
112	FURNITURE STORAGE	CONC.	B2	GB	EXP. STRUCT.				
113	SERVER	CONC.	B2	GB	EXP. STRUCT.				
114	FOOD SERV.	CONC. - ST.	B1	CONC./GB	EXP. STRUCT.	EPOXY PAINT			
115	CAFE	CONC. - ST.	B1	CONC./CW/GB/WD-1	EXP. STRUCT.	EPOXY PAINT			
116	CATERING KITCHEN	CONC.	B2	GB	EXP. STRUCT.	EPOXY PAINT			
117	WATER	CONC.	B2	GB	EXP. STRUCT.				
118	ELECTRICAL	CONC.	B2	PLYWD.-1	EXP. STRUCT.				
119	FOLDING DOOR	CARPET TILE A, B, C, & D RANDOM MIX	B2	PLYWD.-1	EXP. STRUCT.				
1M00	MECHANICAL MEZZANINE	CONC.	B2	GB-TB	EXP. STRUCT. (DO NOT FINISH)				

FINISHES KEY	
CONC.	CONC. (SEAL)
CONC. - ST	CONC. - STAIN
CW	CURTAIN WALL
WW	WINDOW WALL
EXP STRUCT	EXPOSED STRUCTURE
GB	GYPSUM BOARD
PLYWD.-1	PLYWOOD (SEAL)
PLYWD.-2	PLYWOOD (PAINT)
GB-TAB	GYPSUM BOARD, TAPE & BEAD ONLY
B1	STAINED WD. BASE: 1X6 MAPLE (SEE DTL.1)
B2	VINYL BASE
T1	TILE TYPE 1 - FIELD
T2	TILE TYPE 2 - ACCENT
WD-1	WOOD SLATS

- GENERAL FINISH NOTES**
1. STAIN & SEAL ALL WOOD STRUCTURAL MEMBERS, INCLUDING WOOD DECK.
  2. STAIN & SEAL ALL WOOD SLATS
  3. PAINT ALL STRUCTURAL STEEL EXPOSED TO VIEW (UNLESS NOTED OTHERWISE)
  4. DO NOT PAINT METAL DECK
  5. PAINT ALL BUILDING SYSTEMS EXPOSED TO VIEW (UNLESS OTHERWISE NOTED) EXCEPT FOR DUETS
  6. SEAL ALL STRUCTURAL CONC. WALLS & COLUMNS
  7. PROVIDE WALL BASES FOR ONLY FOR GYP. BD. WALLS
  8. PROVIDE SEALER FOR ALL STONE VENEER
  9. PAINT ALL GYP. BD. & PLYWOOD (UNLESS OTHERWISE NOTED)

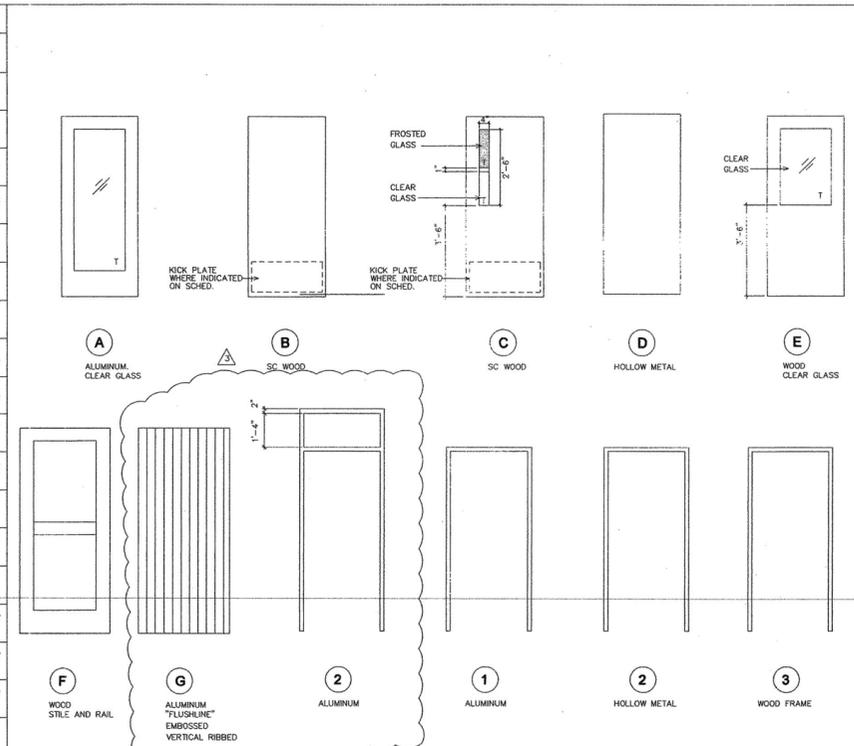

GLAZING SCHEDULE	
TYPE G1:	CLEAR INSULATED
TYPE G2:	INSULATED FROSTED
TYPE G3:	(SKYLIGHT)
TYPE G4:	1/4\" CLEAR FLOAT
TYPE G5:	1/4\" FROSTED
GENERAL NOTES:	
1. ALL EXTERIOR GLAZING SHALL BE CLEAR INSULATED (TYPE G1) UNLESS NOTED OTHERWISE.	
2. ALL INTERIOR GLAZING SHALL BE CLEAR FLOAT (TYPE G4) UNLESS NOTED OTHERWISE.	
3. SEE DRAWINGS FOR ALL LOCATIONS WITH SAFETY GLAZING - (\"T\").	
PARTITION TYPES:	
SYMBOL	DESCRIPTION
1	3 5/8\" X 20 GA. METAL STUDS @ 16\" O.C. W/ 5/8\" GYP. BD. EACH SIDE
1A	SOUND PARTITION- 3\" SOUND BATTS / SEAL TOP & BOTTOM OF PARTITION
1B	SOUND PARTITION- (SEE 1A) - GYP. BD. ONE SIDE ONLY ABOVE FINISH CEILING.
2	8\" X 20 GA. METAL STUDS @ 16\" O.C. W/ 5/8\" GYP. BD. EACH SIDE
2A	SOUND PARTITION- 3\" SOUND BATTS / SEAL TOP & BOTTOM OF PARTITION
3	SOUND PARTITION- 3 5/8\" X 20 GA. MTL. STUDS @ 16\" O.C. W/ 2 LAYERS 5/8\" GYP. BD. EA. SIDE/ 3\" SOUND BATTS/ SEAL TOP AND BOTTOM OF PARTITION.
4	3 5/8\" X 20 GA. METAL STUDS @ 16\" O.C. W/ 5/8\" GYP. BD. ONE SIDE
5	6\" X 20 GA. METAL STUDS @ 16\" O.C. W/ 5/8\" GYP. BD. BOTH SIDES
GENERAL PARTITION NOTES:	
1. ALL PARTITION TO DECK UNLESS NOTED OTHERWISE.	
2. PROVIDE \"GREEN\" GYP. BD. ON INSIDE FACE OF STUDS IN ROOMS 107, 108, 109.	
3. PROVIDE TILE BACKER BD. IN LIEU OF GYP. BD. IN ALL LOCATIONS WITH TILE.	



OVERHEAD DOOR HEAD DTL. 12

DOOR @ TRANSOM HEAD 11

DOOR JAMB 10

**POLK STANLEY ROWLAND CURZON PORTER ARCHITECTS, LTD.**

700 SOUTH SCHILLER  
LITTLE ROCK, AR 72201  
501.378.0878 office  
501.372.7629 fax  
509 W. SPRING STREET, SUITE 150  
FAYETTEVILLE, AR 72701  
479.444.0473 office  
473.251.7216 fax  
www.polkstanley.com

**CONSULTANTS:**  
**CIVIL ENGINEER:**  
 MCCLELLAND ENGINEERS  
**LANDSCAPE ARCHITECT:**  
 LARSON BURNS SMITH  
**STRUCTURAL ENGINEER:**  
 CROMWELL ENGINEERS INC.  
**MECH., ELEC., PLUMB. ENGINEER:**  
 CROMWELL ENGINEERS INC.  
**GLOBAL VILLAGE CONSULTANT**  
 CAMBRIDGE SEVEN ASSOCIATES  
**INTERIOR DESIGNER:**  
 POLK STANLEY ROWLAND  
 CURZON PORTER ARCHITECTS  
**GENERAL CONTRACTOR:**  
 CDI CONTRACTORS, INC.

**NOTES:**

- 1.
- 2.
- 3.
- 4.
- 5.
- 6.
- 7.
- 8.
- 9.

**ISSUE DATE:**  
17 SEPTEMBER 07

**REVISIONS:**

#	DATE:	DESCRIPTION:
1	07 JAN. 08	ASH NO. 1
2	01 MARCH 08	ASH NO. 3
3	25 AUG 08	ASH NO. 19

**MURPHY KELLER EDUCATION CENTER**  
**HEIFER INTERNATIONAL CENTER**  
 LITTLE ROCK, ARKANSAS

**PSRCP JOB NUMBER:**  
431E  
**CONTENTS:**  
FINISH SCHED, PARTITION TYPES, DOOR SCHED.

**SHEET NUMBER:**  
A801