GENERAL NOTE:
1. REMOVE EXISTING SITE REGULATOR TO INCHES W.C. AND INSTALL NEW REGULATOR TO 5 PSI. INSTALL NEW REGULATOR AT ENTRY TO EXISTING BUILDING FROM 5 PSI TO INCHES W.C. AT SAME CAPACITY OF EXISTING REGULATOR.
2. HAND SINK AND THREE COMPARTMENT SINK PIPING FROM MAIN TO FIXTURE MAY ALREADY BE INSTALLED. CONTRACTOR TO VERIFY PRIOR TO BID.

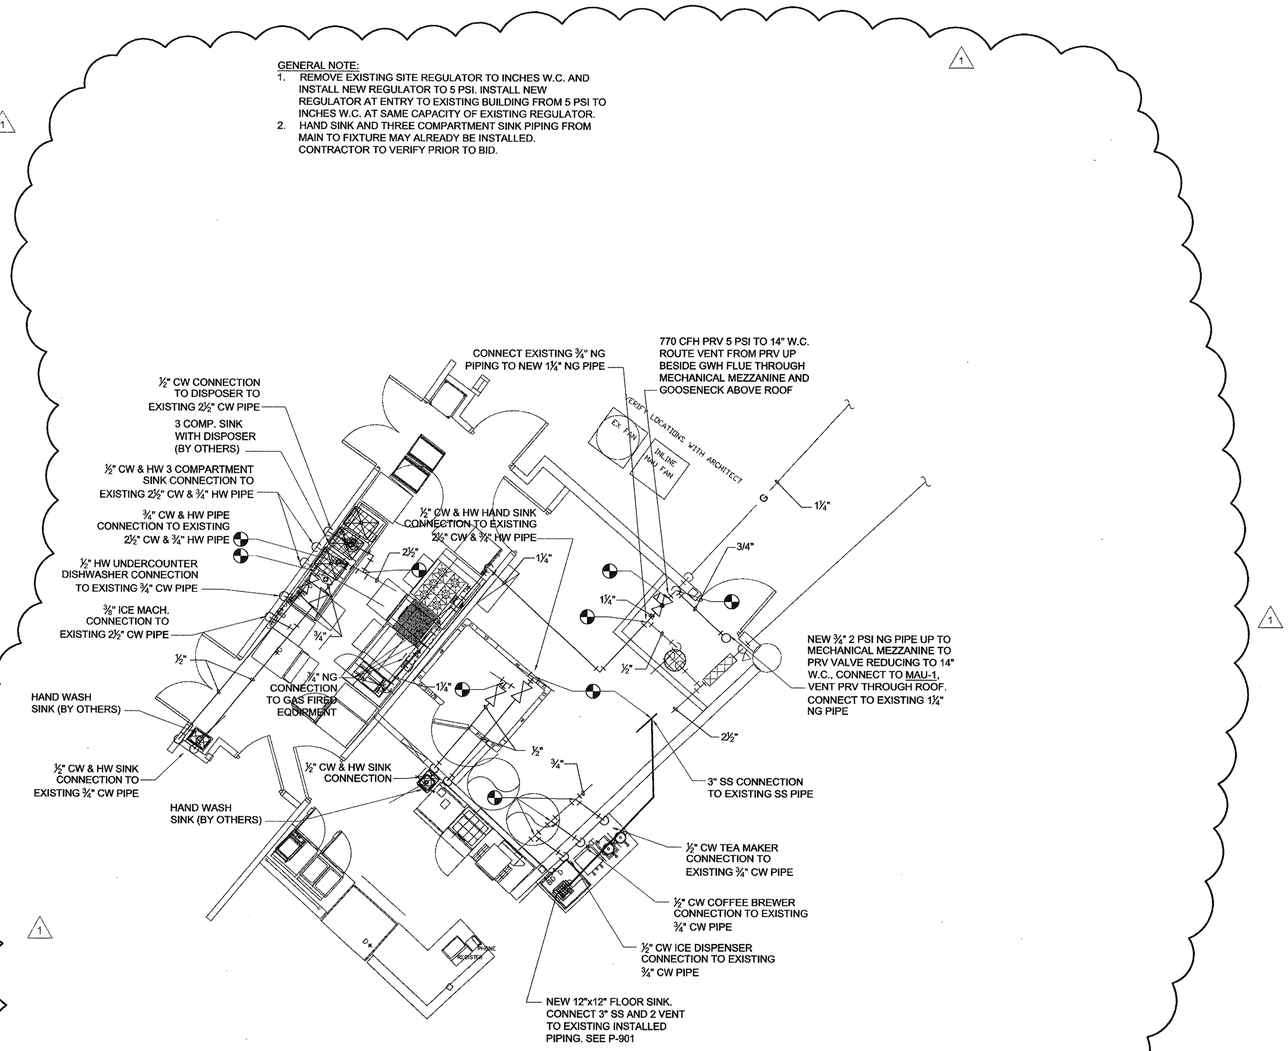

ENLARGED KITCHEN EQUIPMENT PLUMBING FIRST FLOOR PLAN (1)
SCALE: 1/4"=1'-0"

POLK STANLEY ROWLAND CURZON PORTER
ARCHITECTS LTD.

700 SOUTH SCHILLER
LITTLE ROCK, AR 72201
501.378.0878 office
501.372.7629 fax

509 W. SPRING STREET,
SUITE 150
FAYETTEVILLE, AR 72701
479.444.0473 office
473.251.7216 fax

www.polkstanley.com

CONSULTANTS:

CIVIL ENGINEER:
MCCLELLAND ENGINEERS

LANDSCAPE ARCHITECT:
LARSON BURNS SMITH

STRUCTURAL ENGINEER:
CROMWELL ENGINEERS INC.

MECH., ELEC., PLUMB. ENGINEER:
CROMWELL ENGINEERS INC.

GLOBAL VILLAGE CONSULTANT
CAMBRIDGE SEVEN ASSOCIATES

INTERIOR DESIGNER:
POLK STANLEY ROWLAND
CURZON PORTER ARCHITECTS

GENERAL CONTRACTOR:
CDI CONTRACTORS, INC.

NOTES:

ISSUE DATE:
17 SEPTEMBER 2007

REVISIONS:

#	DATE:	DESCRIPTION:
1	02/27/09	ASI #37

MURPHY - KELLER
EDUCATIONAL CENTER

HEIFER
INTERNATIONAL
CENTER

LITTLE ROCK, ARKANSAS

PSRCP JOB NUMBER:
431E

CONTENTS:
ENLARGED PLAN

SHEET NUMBER:
P101K

CERTIFICATE OF AUTHORIZATION
CROMWELL ENGINEERS #55
ARKANSAS - ENGINEER

STATE OF ARKANSAS
REGISTERED PROFESSIONAL ENGINEER
No. 8400
4/17/07