

CONSULTANTS:

CIVIL ENGINEER:  
MCLELLAND ENGINEERS

LANDSCAPE ARCHITECT:  
LARSON BURNS SMITH

STRUCTURAL ENGINEER:  
CROMWELL ENGINEERS INC.

MECH., ELEC., PLUMB ENGINEER:  
CROMWELL ENGINEERS INC.

GLOBAL VILLAGE CONSULTANT  
CAMBRIDGE SEVEN ASSOCIATES

INTERIOR DESIGNER:  
POLK STANLEY ROWLAND  
CURZON PORTER ARCHITECTS

GENERAL CONTRACTOR:  
CDI CONTRACTORS, INC.

NOTES:

|  |
|--|
|  |
|  |
|  |
|  |
|  |
|  |
|  |
|  |
|  |
|  |

ISSUE DATE:  
17 SEPTEMBER 07

REVISIONS:

| # | DATE       | DESCRIPTION |
|---|------------|-------------|
| 1 | 14 APR 08  | ASI 09      |
| 2 | 19 JUNE 08 | ASI 16      |
|   |            |             |
|   |            |             |
|   |            |             |
|   |            |             |

MURPHY KELLER  
EDUCATION CENTER


HEIFER  
INTERNATIONAL  
CENTER

LITTLE ROCK, ARKANSAS


PSRCP JOB NUMBER:  
431E

CONTENTS:  
SECTIONS AND  
DETAILS


SHEET NUMBER: **S505**

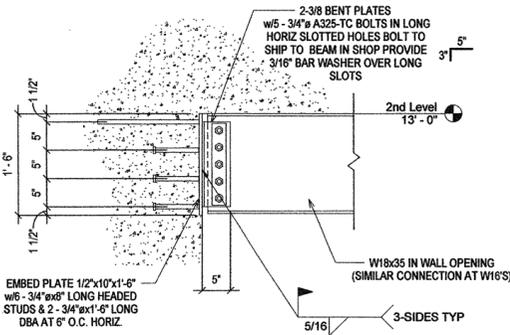


**1** SECTION THRU BEAM IN WALL  
1" = 1'-0"

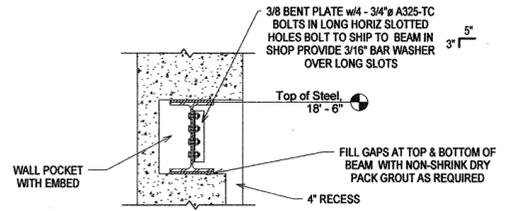

**2** SECTION AT BEAM IN WALL POCKET  
3/4" = 1'-0"

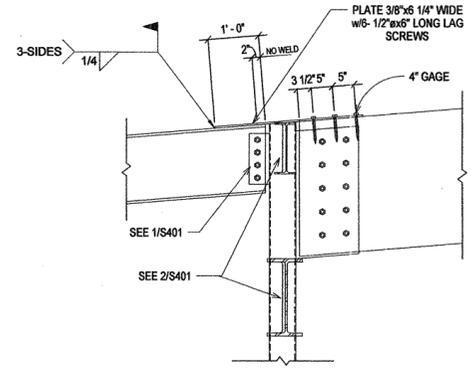

**3** CONNECTION DETAIL  
3/4" = 1'-0"

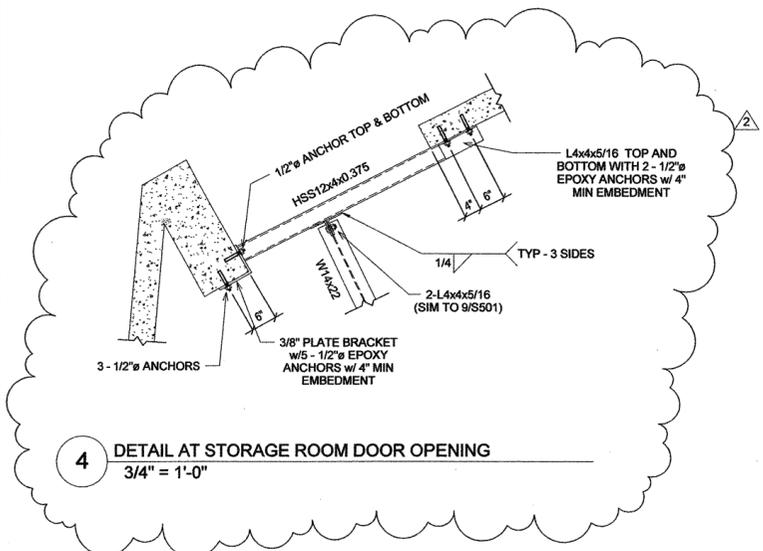

**4** DETAIL AT STORAGE ROOM DOOR OPENING  
3/4" = 1'-0"

