

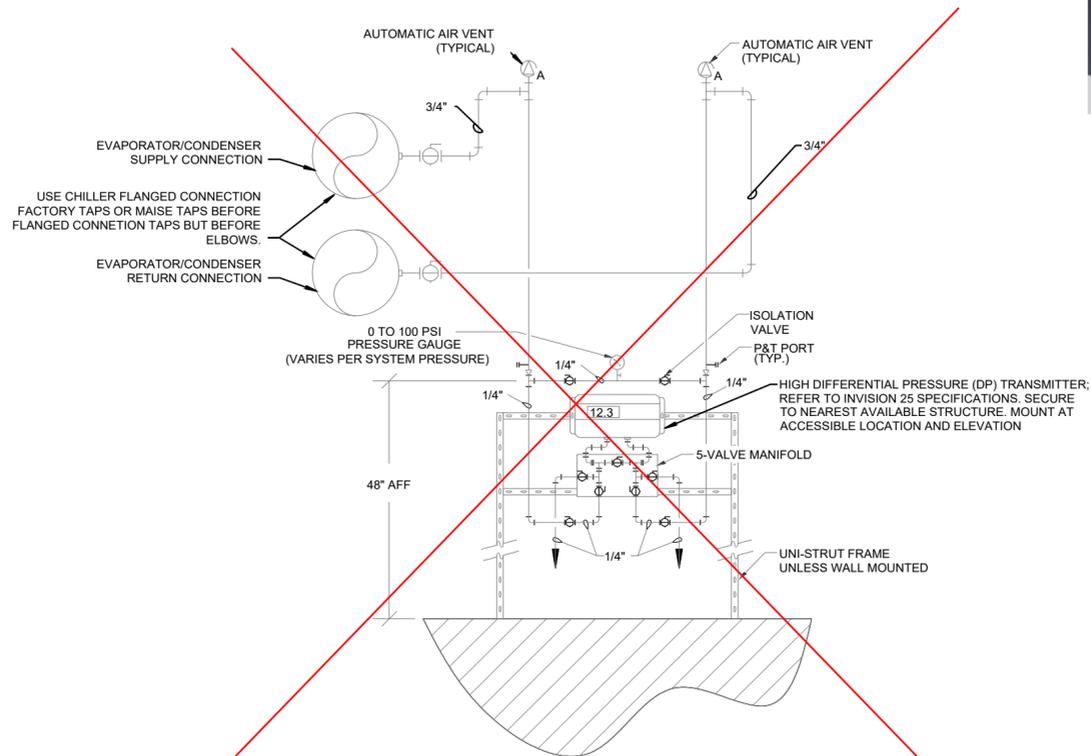


- Chiller connections: 8" groove
- CHW Pump connections: 6" flange
- HWP Pump connections: 4" flange
- xx-Mesh Strainer:
- Flow meter:
- Isolation Valves:
- Check Valve:

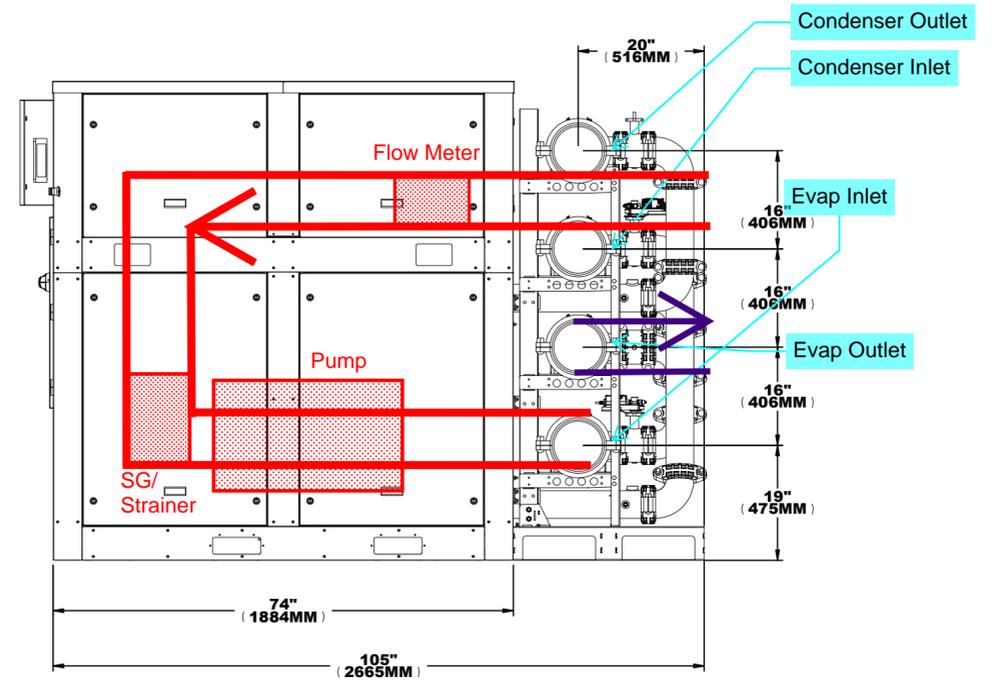

16 CHILLER DIFFERENTIAL PRESSURE TRANSMITTER NOT TO SCALE.

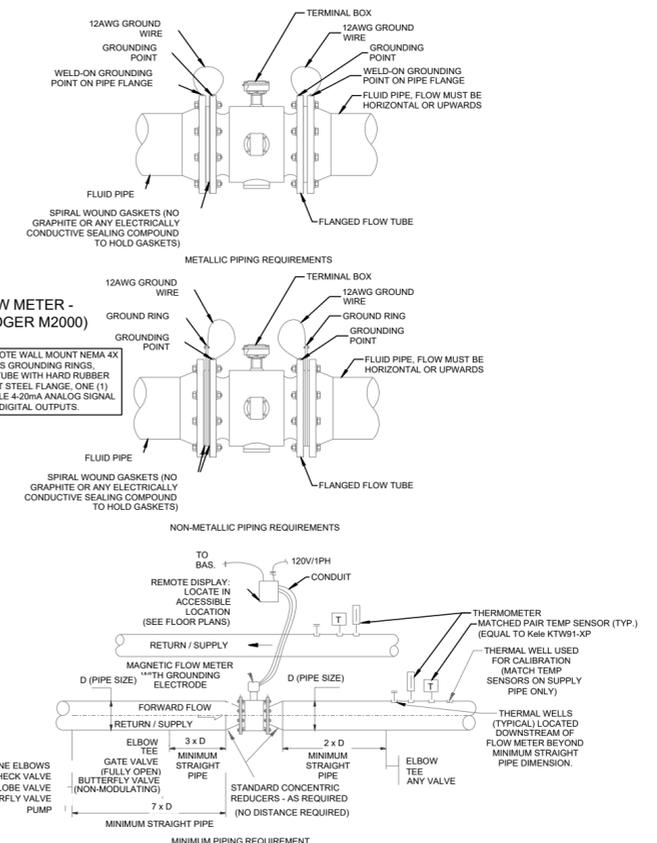

**MAGNETIC FLOW METER - HYDRONIC (BADGER M2000)**  
**REMARKS:**  
 JUNCTION BOX WITH REMOTE WALL MOUNT NEMA 4X AMPLIFIER, NSF LISTED, SS GROUNDING RINGS, 316-SS MAGNETIC FLOW TUBE WITH HARD RUBBER LINER, CLASS 150 RF CAST STEEL FLANGE, ONE (1) PROGRAMMABLE/SCALABLE 4-20mA ANALOG SIGNAL OUTPUT, FOUR (4) TOTAL DIGITAL OUTPUTS.

1 MAGNETIC FLOW METER - HYDRONIC NOT TO SCALE.