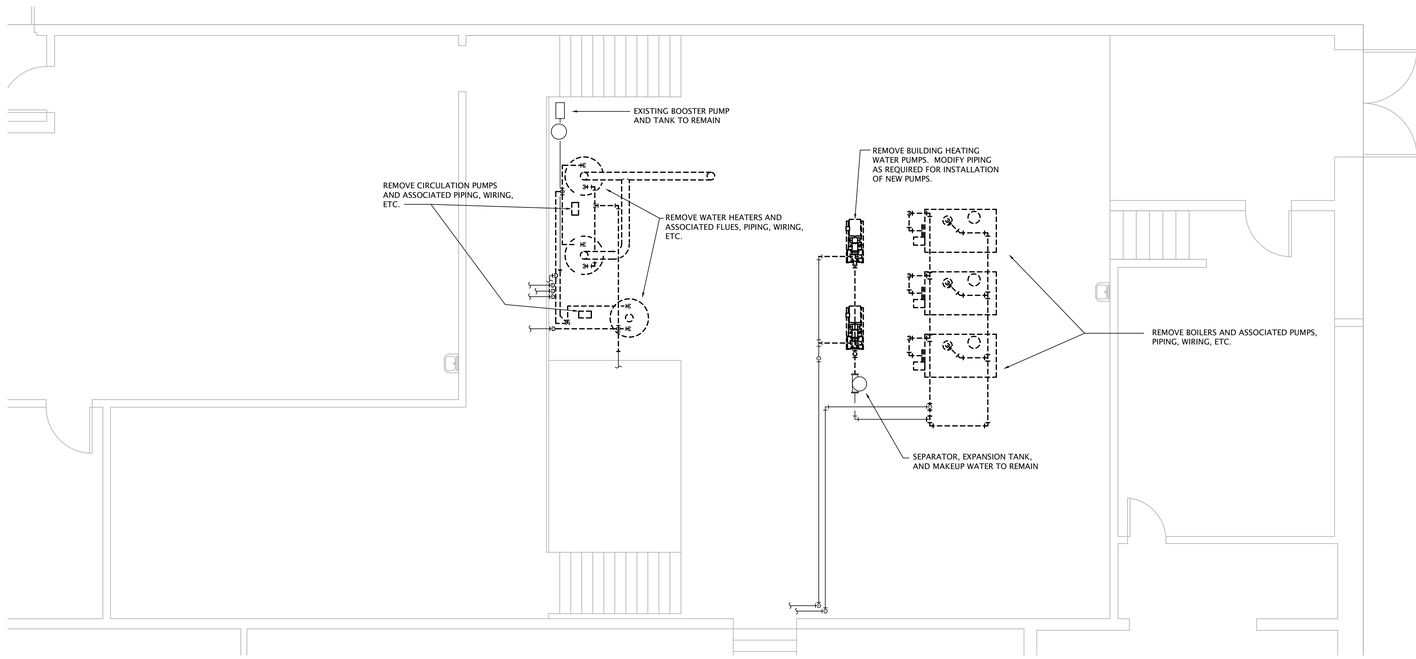

1 BOILER ROOM DEMOLITION PLAN
1/4" = 1'-0"

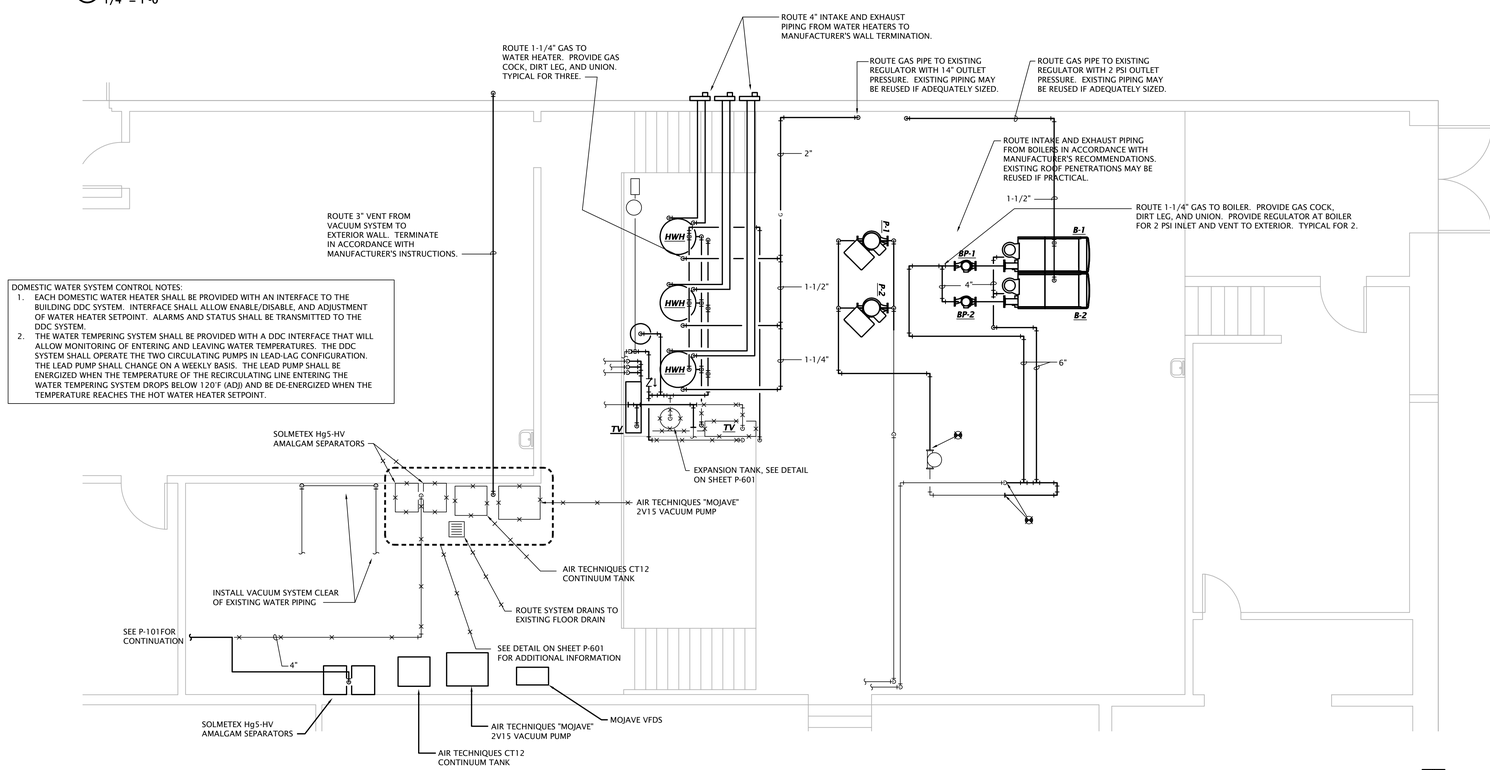

2 BOILER ROOM MECHANICAL PLAN
1/4" = 1'-0"

US Army Corps of Engineers ®
Little Rock District

MARK	DESCRIPTION	DATE	APPR.
	RECORD DRAWINGS AS-BUILT	01 AUG 2016	
	65% REVIEW	10 DEC 2015	

DESIGNED BY: S. L.
DRAWN BY: LST
CKD BY: JFLS
SUBMITTED BY: Zieson Engineers, PA.
DATE: 10 NOVEMBER 2015
SOLICITATION NO.: W912T8-15-R-0005
CONTRACT NO.: W912T8-16-C-0002
FILE NUMBER:
PLOT SCALE: 1/4" = 1'-0"
PLOT DATE: 10 DEC 2015
FILE NAME:
ARCH. EX

U.S. ARMY CORPS OF ENGINEERS
LITTLE ROCK DISTRICT

ZIESON

REPAIR OF BUILDING INFRASTRUCTURE SYSTEMS
19th MEDICAL GROUP
(WORKING) DRIVE
LITTLE ROCK AIR FORCE BASE, AR 72099-5057

BOILER ROOM MECHANICAL PLAN

SHEET IDENTIFICATION
M-401
SHEET OF

RECORD DRAWINGS AS-BUILT