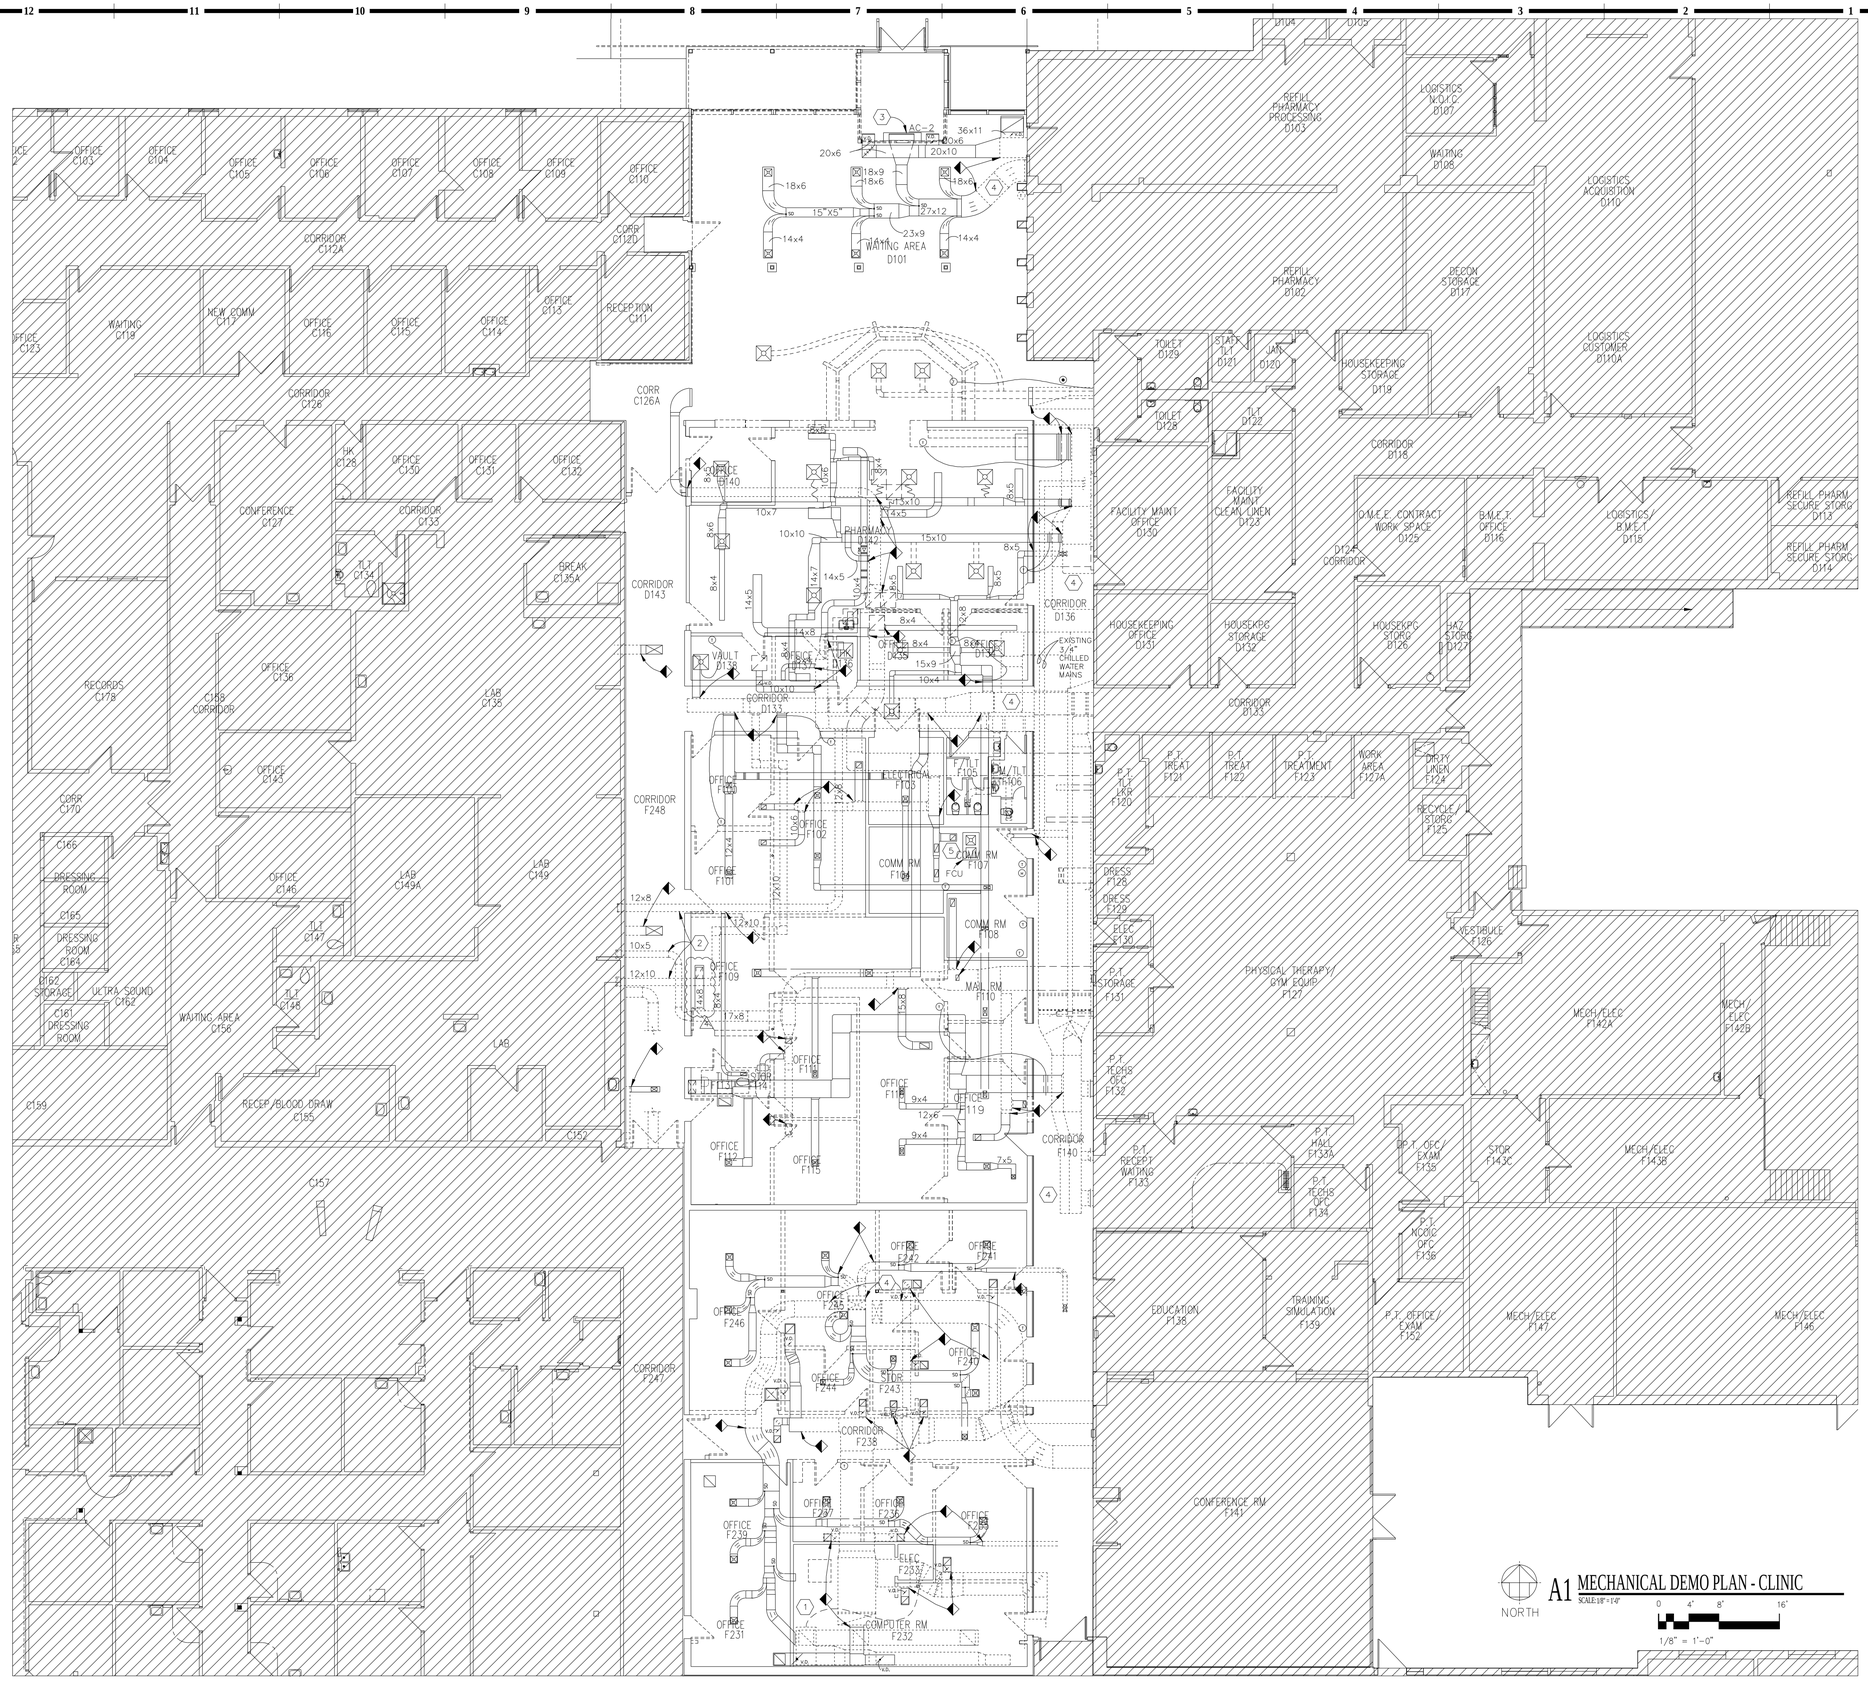

1. REFER SHEET M0.01 FOR SYMBOLS, LEGENDS AND GENERAL NOTES.
2. THE MAJORITY OF THE DUCT MAIN FOR THE SUPPLY AND RETURN DUCTWORK WILL BE REUSED WHERE POSSIBLE.
3. REMOVE ALL EXISTING DUAL DUCT BOXES, DIFFUSERS, RA GRILLES, AND EXHAUST GRILLES TO ALLOW NEW WORK.

1. THE EXISTING CRAC UNIT AND ASSOCIATED DUCTWORK WILL REMAIN IN PLACE.
2. EXHAUST, SUPPLY, AND RETURN AIR DUCT ARE TO REMAIN IN OPERATION TO SERVE UN-RENOVATED AREAS DURING CONSTRUCTION. EXISTING PENETRATIONS SHALL BE CAPPED AND SEALED AIR TIGHT PRIOR TO START OF DEMOLITION AND REMAIN SEALED UNTIL DUST IS UNDER CONTROL, AND NEW CONNECTIONS CAN BE MADE. ADJUST FAN SPEED AS REQUIRED TO MAINTAIN "AS BUILT" DRAWING AIRFLOWS.
3. REMOVE AIR CURTAIN AC-2 TO BE RE-INSTALLED IN RENOVATED VESTIBULE
4. CONDUCT PRE-DEMOLITION DUCT TRAVERSE AIR FLOW TEST TO VERIFY EXISTING SYSTEM CAPACITIES.
5. DEMO EXISTING FAN COIL UNIT AND CAP EXISTING CHILLED WATER LINES

HWA
HOEFER WYSOCKI ARCHITECTS, LLC
MEGROUP design
3101 BROADWAY, SUITE 570
KANSAS CITY, MO 64111
T: 816.531.2121
F: 816.531.1838
www.megroup.com
Job #: 601.019
High Performance Building Consultants

LITTLE ROCK AFB-CLINIC & WAREHOUSE

19TH MEDICAL GROUP-CLINIC BLDG. 1090
JACKSONVILLE, AR

100% CONSTRUCTION DOCUMENTS

COPYRIGHT © BY HOEFER WYSOCKI ARCHITECTS, LLC

REVISION DATES:
RECORD DRAWINGS-1/6/2012
1 ASI #004 6-24-2011

Alutiiq Diversified Services, LLC
A Wholly Owned Subsidiary of Afognak Native Corporation

RECORD DRAWINGS

MD1.11

ISSUE DATE: 6 January 2012
PROJECT #: 04281

MECHANICAL DEMO PLAN - CLINIC