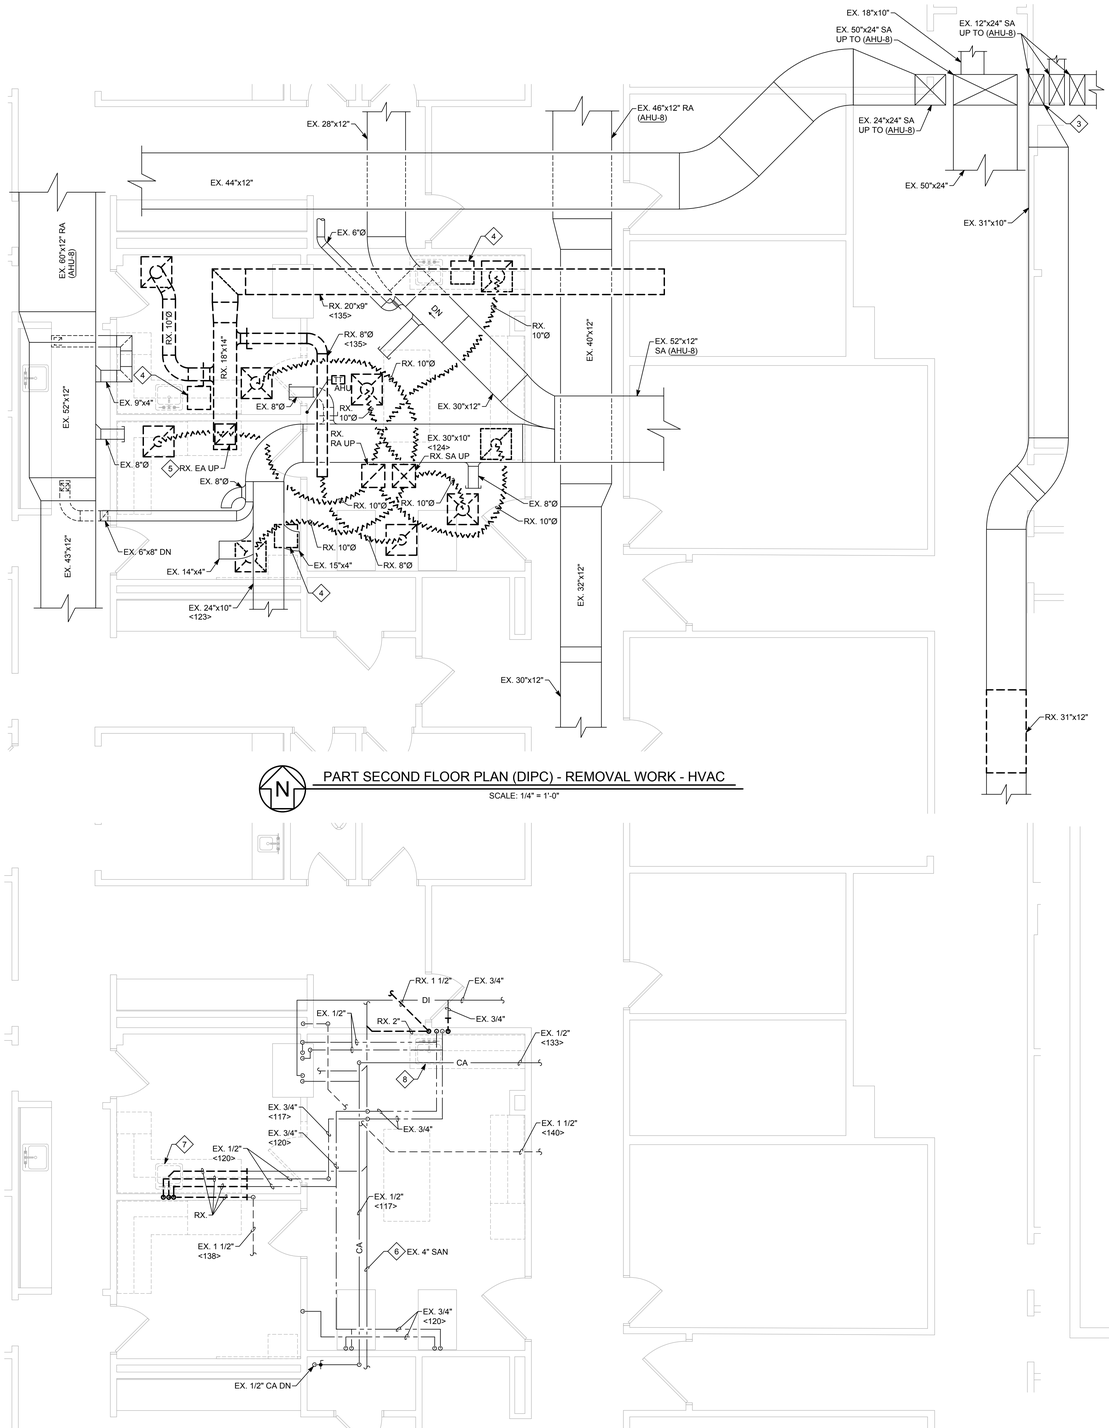

PART SECOND FLOOR PLAN (DIPC) - REMOVAL WORK - HVAC

SCALE: 1/4" = 1'-0"

PART SECOND FLOOR PLAN (DIPC) - REMOVAL WORK - PLUMBING

SCALE: 1/4" = 1'-0"

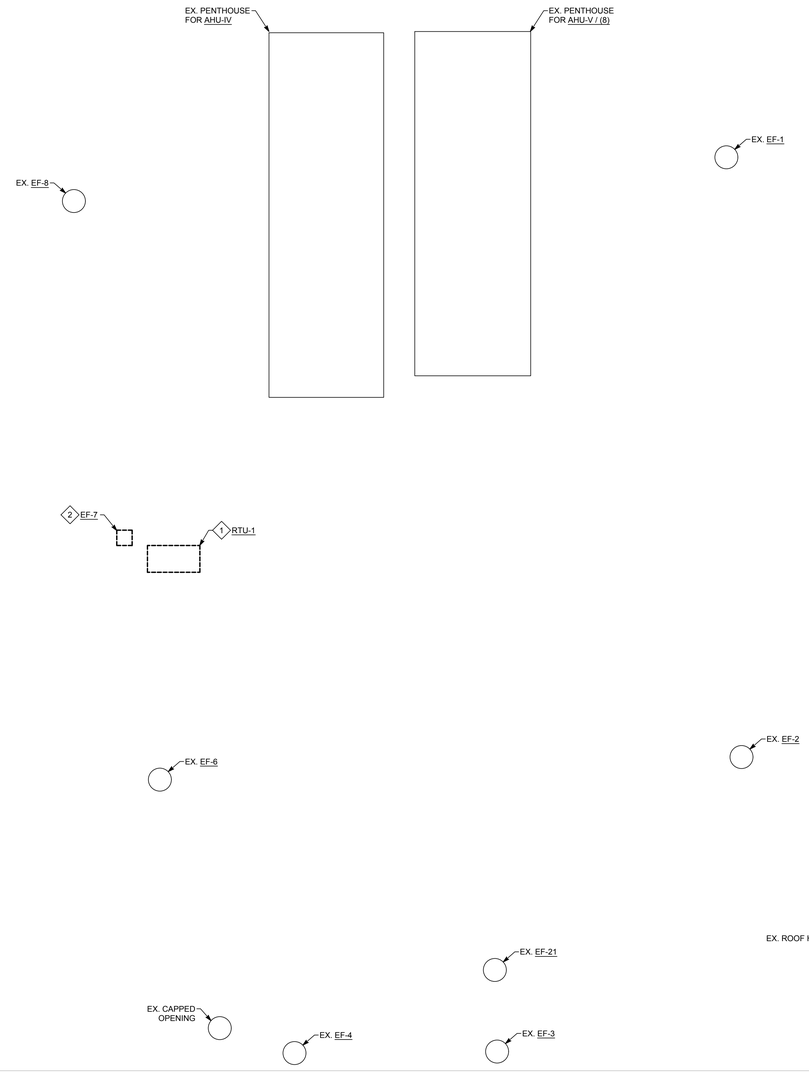

PART SECOND FLOOR ROOF PLAN - REMOVAL WORK - HVAC

SCALE: 1/8" = 1'-0"

GENERAL NOTES:

G1. EXISTING SENSAPHONE REMOTE MONITORING TEMPERATURE AND HUMIDITY SENSORS SHALL REMAIN.

G2. MODIFY EXISTING SPRINKLER BRANCH PIPING/HEADS IN THE RENOVATED AREA AS REQUIRED TO ACCOMMODATE THE NEW ARCHITECTURAL LAYOUT/CEILING INSTALLATION.

DRAWING NOTES:

1. REMOVE EXISTING ROOFTOP AIR HANDLING UNIT AND ALL ASSOCIATED CONTROLS, DUCTWORK AND PIPING. CAP AND SEAL EXISTING ROOF CURB TO REMAIN.
2. REMOVE EXISTING EXHAUST FAN AND ALL ASSOCIATED CONTROLS AND DUCTWORK. ROOF CURB SHALL REMAIN FOR INSTALLATION OF NEW FAN.
3. EXISTING SUPPLY DUCT UP TO SUPPLY AIR TERMINAL UNIT, SERVING ZONE 4. UNIT IS LOCATED IN THE PENTHOUSE ABOVE. REMOVE EXISTING UNIT AND ALL ASSOCIATED CONTROLS AND PIPING BACK TO MAINS. RETAIN UNIT FOR RELOCATION. PATCH AND SEAL EXISTING DUCTWORK SECTION.
4. REMOVE EXISTING PORTABLE DEHUMIDIFIER AND ALL ASSOCIATED PIPING. RETURN UNIT TO OWNER.
5. REMOVE EXHAUST DUCT UP TO 12" BELOW SLAB.
6. PIPING LOCATED IN CEILING OF FLOOR BELOW.
7. REMOVE EXISTING PLUMBING FIXTURE AND ALL ASSOCIATED SANITARY, VENT, AND DOMESTIC WATER PIPING TO THE EXTENT INDICATED.
8. REMOVE EXISTING PLUMBING FIXTURE AND ALL ASSOCIATED VENT AND DOMESTIC WATER PIPING BACK TO MAINS. REMOVE EXISTING SANITARY AND DI WATER PIPING TO THE EXTENT INDICATED.

AS-BUILT DOCUMENTS

AREA OF WORK

KEYPLAN

SES ELECTRICAL LLC (SEL)
1006 FLOYD CULLER CT,
OAK RIDGE, TN 37830
P: 865-481-7837
www.ses-grp.com

SPECPRO ENVIRONMENTAL SERVICES LLC (SES)
1006 FLOYD CULLER CT,
OAK RIDGE, TN 37830
P: 865-481-7837
www.ses-grp.com

KEZLO GROUP, LLC
PO BOX 419
COCHRANVILLE, PA 19330
P: 610-457-9715
WWW.KEZLO.COM

Leach Wallace Associates, Inc.
Consulting Engineers
6522 Meadowridge Road
Elkridge, MD 21075
(410) 579-8100 FAX (410) 540-9041

MAINSTAY
ENGINEERING GROUP, INC.
212 North Main Street, Suite 300;
North Wales, PA 19454
(215) 646-5595 FAX (215) 857-0540

REVISIONS:

#	DESCRIPTION:	DATE:
	65% DESIGN SUBMISSION	12/28/2018
	95% DESIGN SUBMISSION	02/22/2019
	100% DESIGN SUBMISSION	08/16/2019

SEAL:

PROJECT TITLE:
VET CLINIC & DIPC RENOVATIONS / REPAIR VETERINARY TREATMENT FACILITY

ISSUE DATE:	DRAWN BY:	CHECKED BY:
8/16/19	JSF	TJM

DRAWING TITLE:
PART SECOND FLOOR PLANS (DIPC) - REMOVAL WORK - MECHANICAL

PROJECT NUMBER: 18-390-00

DRAWING NUMBER: M102

FILENAME: P:\2018\18390\00\BIM\M-18-RAFB-01090-MP-F2-M102.DWG LAST SAVED BY: (RCHANEY PLOTTED BY: (JFLOWERS) ON Aug 16, 2019 - 1:52pm