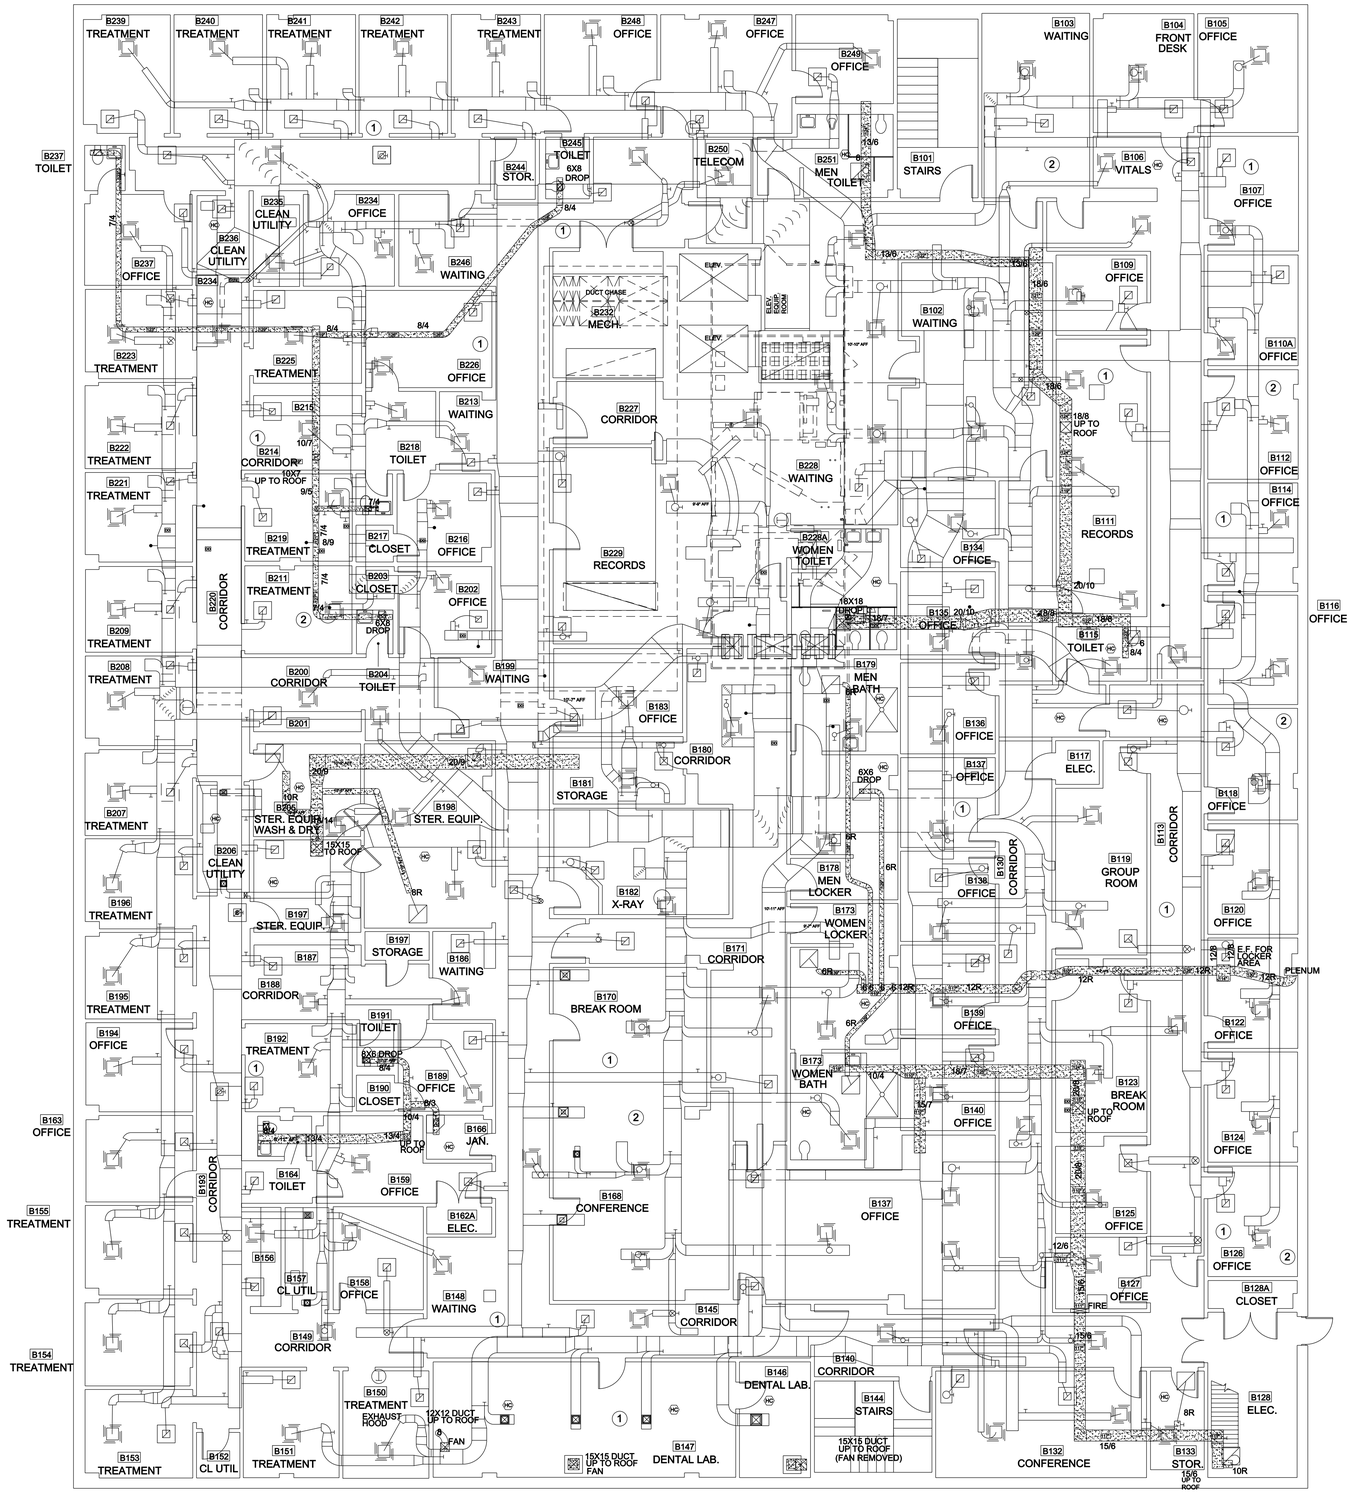

SECOND FLOOR MECHANICAL PLAN - EXHAUST DUCT

0 5' 10' 25'

SCALE: 1/8" = 1'-0"

KEYED NOTES:

1. SEE SHEETS M-305 AND M-306 FOR AIR BALANCE DATA FOR SUPPLY, RETURN AND EXHAUST SYSTEMS. NOTE THAT AFTER EXISTING ROOF MOUNTED UNITS HAVE BEEN REPLACED PROVIDE AIR BALANCE. PROVIDE COMPLETE AIR BALANCE DATA FOR REVIEW. NOTE THAT PRESSURE RELATIONSHIPS AS INDICATED ON THE SCHEDULES MUST BE BALANCED.
2. NOTE THAT THE DUCT ROUTING AND SIZE AS INDICATED ON THIS DRAWING HAS BEEN FIELD VERIFIED.

LEGEND
EXHAUST GRILLE
RETURN GRILLE
SUPPLY GRILLE
HARD CEILING AREA
DAMPER LOCATION (BY COLOR)
ABOVE FINISHED FLOOR HEIGHT (BY COLOR)
SMOKE DAMPER LOCATION
DUCT DETECTOR LOCATION
EXHAUST DUCT
SUPPLY DUCT
RETURN DUCT
HEAT DUCT
FLEX DUCT (BY COLOR)
THERMOSTAT LOCATION
DIGITAL CONTROLLER
FIRE DAMPER
PICTURE LOCATION

AS-BUILT

AIR EDUCATION & TRAINING COMMAND
LITTLE ROCK A.F.B.
ARKANSAS

MIKE TRUSTY ENGINEERING
PHONE: (501)224-9013
FAX: (501)421-0151
miketrusty@msn.com

No.	Revision/Issue	Date	BY	APP'D

PROJECT TITLE
REPAIR & RENOVATE MEDICAL CLINIC PH V
LITTLE ROCK AIR FORCE BASE
JACKSONVILLE, ARKANSAS
CHANGE ORDER TO PHASE V - 100% SUBMITTAL

SHEET TITLE
SECOND FLOOR MECHANICAL PLAN EXHAUST DUCT

DRAWN BY GMT	LEAD DESIGNER GMT
TECH REVIEWER	PROJECT NUMBER NKAK#06-8006-5
DESIGNED BY GMT	SHEET M-303
DATE DEC. 3, 2010	
SCALE AS SHOWN	13 OF 21