WALL TYPES

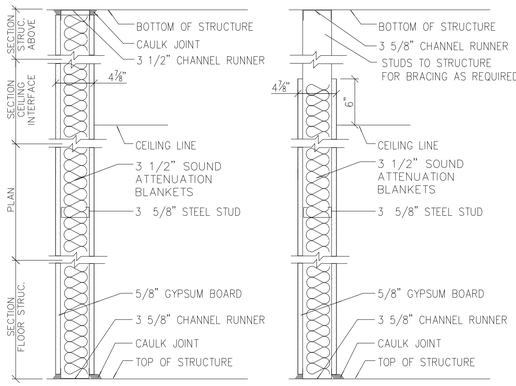

FIRE RESISTANCE RATING : NONE
STC RATING : 45-50

PARTITION TYPE 1

FIRE RESISTANCE RATING : NONE
STC RATING : 40

PARTITION TYPE 1B

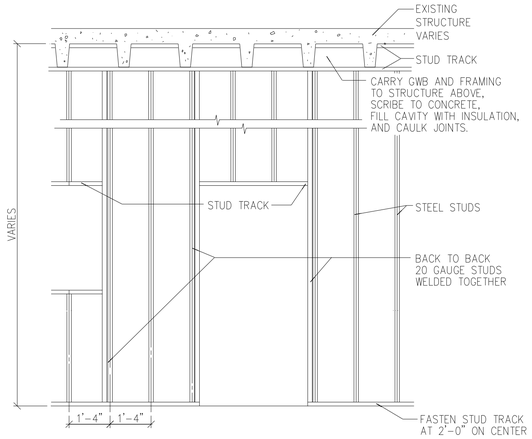

NOTE: PROVIDE BACK TO BACK CASING BEADS FROM DOOR HEAD TO STRUCTURE ON BOTH SIDES OF WALL

TYPICAL INTERIOR STUD WALL CONSTRUCTION

N.T.S.

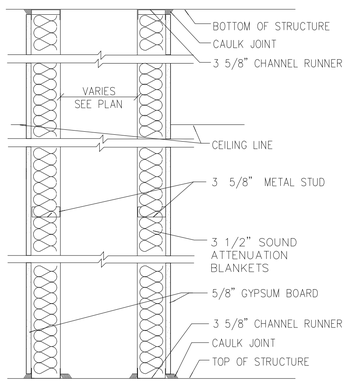

FIRE RESISTANCE RATING : NONE
STC RATING : 50

PARTITION TYPE 5

N.T.S.

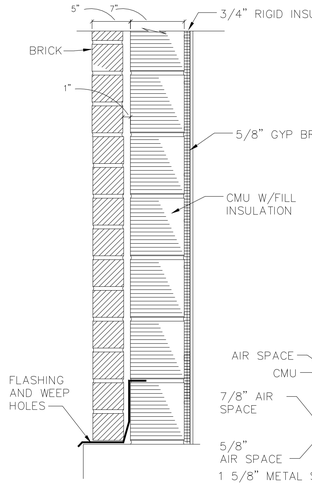

EXISTING WALL 6

N.T.S.

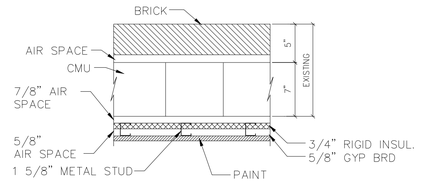

NEW WALL 7

GENERAL NOTES:

1. FIRE RESISTANCE RATING SHOWN FOR ONE HOUR PARTITIONS APPLY WHERE NOTED ON FLOOR/FIRE CODE PLANS. IF PARTITION IS NON-RATED CONSTRUCTION FROM FLOOR TO STRUCTURE ABOVE THIS IS TO PROVIDE ACOUSTICAL CONTROL. SEE "PARTITION TYPE 1" DETAIL.
2. WATER RESISTANT BOARD SUBSTITUTED FOR LAYER OF GYPSUM BOARD DIRECTLY BENEATH CERAMIC TILE WALL FINISH.
3. ALL PARTITION TYPES TO BE FIRE TAPED AND SEALED TO STRUCTURE ABOVE WHERE FIRE RATINGS ARE REQUIRED.
4. FOLLOW UL ASSEMBLY REQUIREMENTS AS NOTED.
5. NEW HOLLOW METAL DOOR FRAMES SHALL BE TERMINATED STOP TYPE TO MATCH EXISTING DOOR FRAMES.

LITTLE ROCK A.F.B.
ARKANSAS

FPM

804 West Curtis Drive, Suite H
Midwest City, OK 73110
phone: 405.869.9212
fax: 405.869.9222
www.fpm-group.com

RECORD DRAWINGS MARCH 2007

DOOR/OPENING TYPES

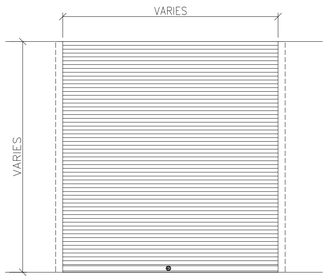

1 SHUTTER ELEVATION A

SCALE 1/2"=1'-0"

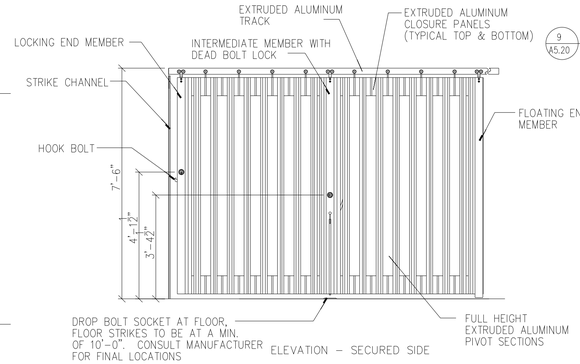

1B SHUTTER ELEVATION B

N.T.S.

NOTE:
CONSULT MANUFACTURER FOR CUSTOM CURVED TRACK AND CLOSURES. DIAGRAMS SHOWN FOR CONCEPT. MANUFACTURER TO ISSUE WORKING DRAWINGS AND ADDITIONAL SPECIFICATIONS

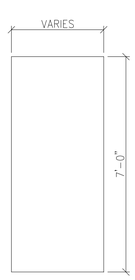

2 DOOR ELEVATION A

SCALE 1/2"=1'-0"

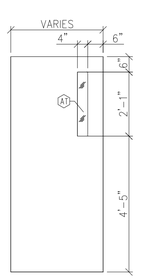

3 DOOR ELEVATION B

SCALE 1/2"=1'-0"

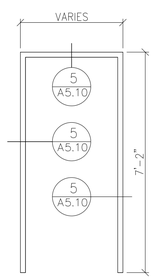

4 DOOR FRAME A

SCALE 1/2"=1'-0"

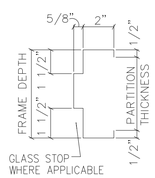

5 BUCK PROFILE

N.T.S.

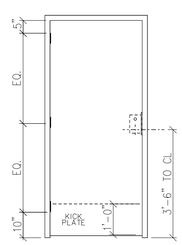

6 MORTISE LOCK

SCALE 1/2"=1'-0"

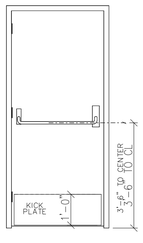

7 PANIC BAR

SCALE 1/2"=1'-0"

8 NOT USED

SCALE N.T.S.

9 NOT USED

SCALE N.T.S.

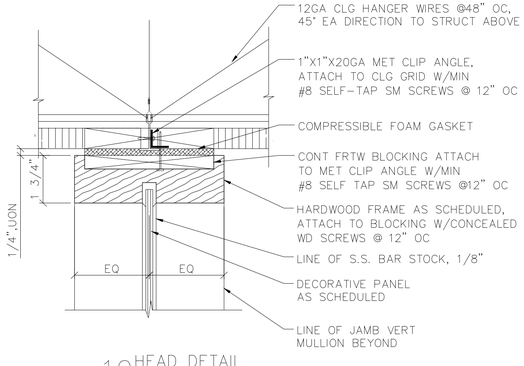

10 HEAD DETAIL

SCALE N.T.S.

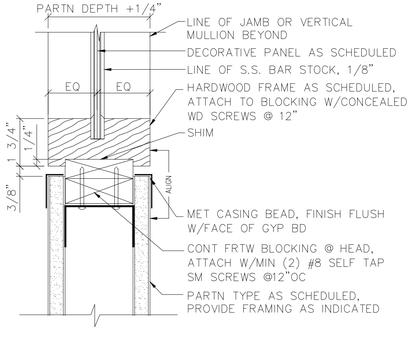

11 SILL DETAIL

SCALE N.T.S.

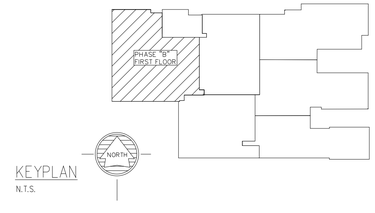

KEYPLAN
N.T.S.

No.	Revision/Issue	Date	BY	APP'D

PROJECT TITLE
REPAIR MEDICAL CENTER PH B
LITTLE ROCK AFB, ARKANSAS

SHEET TITLE
DOORS, FRAMES, PARTITION TYPES

DRAWN BY RJR	LEAD DESIGNER AM
TECH REVIEWER AM	PROJECT NUMBER NKAK 05-8004A
DESIGNED BY AM	SHEET A5.10
DATE 1-21-08	
SCALE AS NOTED	15 OF 39