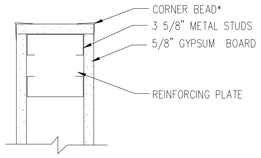

1 PARTITION END
3"=1'-0"

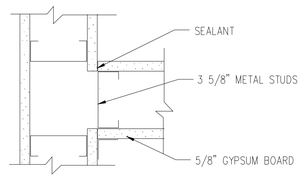

2 PARTITION INTERSECTION
3"=1'-0"

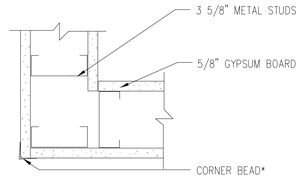

3 PARTITION CORNER FRAMING
3"=1'-0"

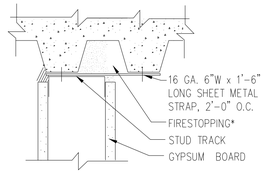

4 PARTITION TERMINATION AT METAL DECK-TRANSVERSE TO FLUTES
3"=1'-0"
* OR SOUND ATTENUATION MATERIAL AT NON-RATED PARTITIONS

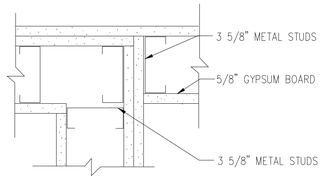

5 PARTITION INTERSECTION
3"=1'-0"

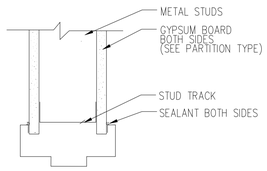

6 HEAD AT TYPICAL PARTITION
3"=1'-0"

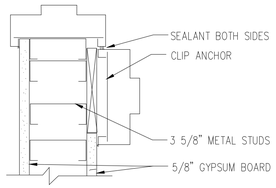

7 ADJOINING DOOR JAMBS
3"=1'-0"

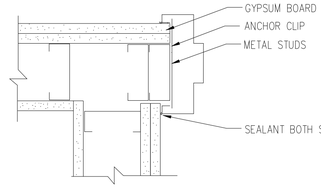

8 JAMB AT PARTITION INTERSECTION
3"=1'-0"

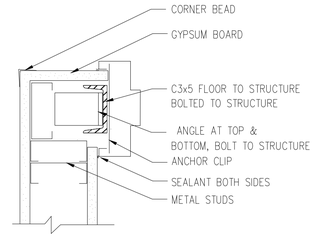

9 JAMB AT END OF PARTITION
3"=1'-0"

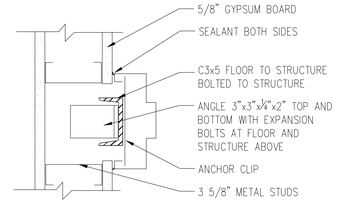

10 JAMB DETAIL AT NON-RATED PART.
3"=1'-0"

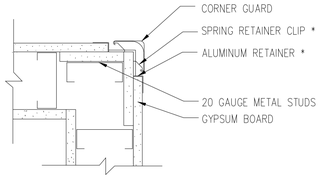

* EXISTING SPRING CLIP AND ALUMINUM RETAINER MAY BE REUSED IN PLACE IF THE CORNER GUARD FACE PIECE CAN BE REPLACED INDEPENDENTLY.

11 CORNER GUARD IN TYPICAL PARTITION
A6012
3"=1'-0"

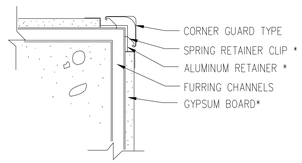

* EXISTING SPRING CLIP AND ALUMINUM RETAINER MAY BE REUSED IN PLACE IF THE CORNER GUARD FACE PIECE CAN BE REPLACED INDEPENDENTLY.

12 CORNER GUARD AT FURRED CORNER
A6012
3"=1'-0"

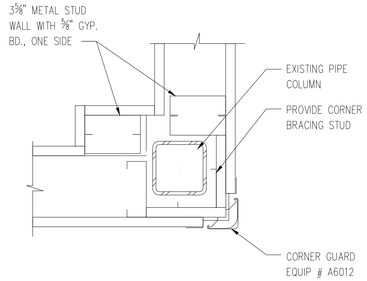

** HOLD CORRIDOR SIDE

13 RECESSED END CORNER GUARD
3"=1'-0"

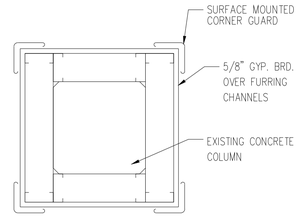

** HOLD CORRIDOR SIDE

14 FURRING AT COLUMN
N.T.S.

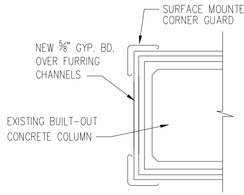

** HOLD CORRIDOR SIDE

15 FURRING AT COLUMN
N.T.S.

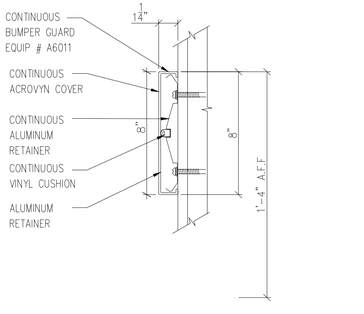

16 BUMPER GUARD SECTION
A6011
SCALE 3"=1'-0"

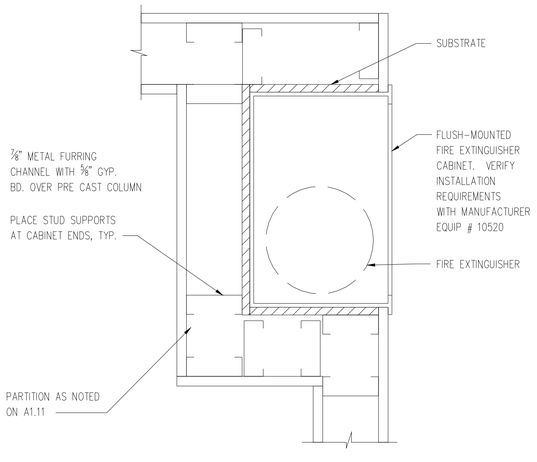

17 FIRE EXTINGUISHER CABINET
N.T.S.

* EXISTING FIRE EXTINGUISHER CABINET MAY REMAIN IF IN GOOD CONDITION. FINISH METAL TO MATCH NEW DOOR FRAME FINISH.

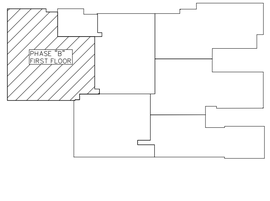

KEYPLAN
N.T.S.

AIR EDUCATION & TRAINING COMMAND

LITTLE ROCK A.F.B.
ARKANSAS

FPM

804 West Curtis Drive, Suite H
Midwest City, OK 73110
phone: 405.869.9212
fax: 405.869.9222
www.fpm-group.com

RECORD DRAWINGS MARCH 2007

No.	Revision/Issue	Date	BY	APP'D

PROJECT TITLE
REPAIR MEDICAL CENTER PH B
LITTLE ROCK AFB, ARKANSAS

SHEET TITLE
ARCHITECTURAL DETAILS

DRAWN BY RJR	LEAD DESIGNER AM
TECH REVIEWER AM	PROJECT NUMBER NKAK 05-8004A
DESIGNED BY AM	SHEET A5.11
DATE 1-21-08	16 OF 39
SCALE AS NOTED	