LEGENDS

FIRE CODE SYMBOLS

1 HOUR FIRE/SMOKE WALL WITH 20 MINUTE DOORS UL DESIGN NO. U465

EXISTING 1 HOUR RATING

EXISTING 2 HOUR RATING

fec — FIRE EXTINGUISHER CABINET EXISTING CABINETS DESIGNATED AS **EXIST** SEE G1.00 LIFE SAFETY PLAN FOR FURTHER INFORMATION.

CEILING LEGEND

- 1X4 FLUORESCENT TROFFER OR WALL WASHER
- 2X4 FLUORESCENT TROFFER
- 2X2 FLUORESCENT TROFFER
- INCANDESCENT OR FLUORESCENT FIXTURE - RECESSED
- INCANDESCENT OR FLUORESCENT EMERGENCY OR NIGHT LIGHT FIXTURE- WALL MOUNTED
- EXIT LIGHT
- UNIVERSAL-MOUNTED DIRECTIONAL ARROWS AS SHOWN ON DRAWINGS
- PENDANT FLUORESCENT FIXTURE
- SEMI-RECESSED HALOGEN DOWN LIGHT FIXTURE
- PENDANT LIGHT FIXTURE
- RADIAL DIMENSION CENTER MARK
- INDICATES A CHANGE IN CURVE DIMENSION
- CEILING MOUNTED LIGHT M7405
- SUPPLY DIFFUSERS 2' X 2' OR 1' X 1'
- EXHAUST DIFFUSERS 2' X 2' OR 1' X 1'
- GYPSUM BOARD
- CURTAIN TRACK A5180. REFER TO CEILING DETAIL •3 ON SHEET A5.20
- SIDE FOLDING SECURITY GATE TRACK
- FIBER OPTIC LIGHT STRIP - LOCATED AT EDGE OF SUSPENDED METAL CEILING
- TELEVISION BRACKET, CEILING MOUNTED A5215
- SPEAKER
- OPEN CELL CEILING SYSTEM, W/ 8"x8" LAY-IN PANEL CELLS
- EGG CRATE LENS
- SUSPENDED ACOUSTICAL CEILING SYSTEM

FLOORING LEGEND

- CPT–1
- CPT–2
- CPT–3
- CPT–4
- (7) CERAMIC FLOOR TILE BY KEY NOTE (7) INDICATOR
- VCT
- SV
- INDICATES MARBLE TRANSITION
- INDICATES TRANSITION SEE SPEC SECTION 09650

HOLLOW METAL DOOR FRAME

1½" MARBLE TRANSITION LOCATED

ABBREVIATIONS

@	AT
A.F.F.	ABOVE FINISHED FLOOR
ACT	ACOUSTICAL TILE
ADMIN	ADMINISTRATION
ALT	ALTERNATE
APPOINT	APPOINTMENT
BIO	BIOLOGICAL
CFT	CERAMIC FLOOR TILE
COLL	COLLECTION
COMM	COMMUNICATION
CPT	CARPET
DIA	DIAMETER
DIV.	DIVISION
E	ELECTRICAL
EIFS	EXTERIOR INSULATION FINISH SYSTEM
ELEC	ELECTRIC
ENG	ENGINEERS
ENT	EAR, NOSE AND THROAT
ENVIR	ENVIRONMENTAL
EQ.	EQUAL
ETC	ETCETERA
EXT.	EXTERIOR
F	FEMALE
GWB	GYPSUM WALL BOARD
GYP BD	GYPSUM BOARD
HM	HOLLOW METAL
IMMUN	IMMUNIZATION
INT.	INTERIOR
LG	LONG
M	MALE
M	MECHANICAL
N/A	NOT APPLICABLE
NCOIC	NON-COMMISSIONED OFFICER IN CHARGE
NFPA	NATIONAL FIRE PROTECTION AGENCY
O.C.	ON CENTER
OPP.	OPPOSITE
P	PAINT
P	PLUMBING
PED	PEDIATRIC
PREP	PREPARE
RCP	REFLECTED CEILING PLAN
REQ'D	REQUIRED
SIM.	SIMILAR
SPEC	SPECIFICATION
STC	SOUND TRANSMISSION COEFFICIENT
SV	SHEET VINYL
TYP.	TYPICAL
VCT	VINYL COMPOSITION TILE
W/	WITH
WD	WOOD

MATERIAL SYMBOLS

MATERIAL	SYMBOL
FACE BRICK	
FACE BRICK - ELEVATION	
CONCRETE	
PRECAST CONCRETE	
CONCRETE BLOCK	
DIMENSION LUMBER	
DRAIN BOARD	
FINISH LUMBER	
PLYWOOD	
WOOD (ELEVATION)	
BATT INSULATION	
RIGID INSULATION	
ACOUSTICAL TILE	
GYPSUM WALL BOARD /PLASTER	
METAL (SECTION)	
METAL (ELEVATION)	
METAL (EXTRUSIONS)	
ALUMINUM	
GLAZING (PLAN)	
GLAZING (ELEVATION)	
COMPACTED EARTH	
UNDISTURBED EARTH	
ASPHALT	
GRANULAR FILL	

ARCHITECTURAL SYMBOLS

NORTH / W / E / S

NORTH REFERENCE

5 NORTH EAST SOUTH WEST TITLE — ⅛"=1'-0"

INTERIOR ELEVATION

DETAIL NUMBER — 10 / A5.12 — AREA DETAILED — SHEET DETAIL IS DRAWN ON

DETAIL REFERENCE (ON PLAN)

DESIGNATES ADDITIONAL INFORMATION ABOUT PARTITION

DESIGNATES PARTITION TYPE

PARTITION TYPE IDENTIFICATION

1718Z1 / 1718Z2

DOORS ARE TO RECEIVE THE NUMBER OF ROOM WHICH IT SERVES. IF MORE THAN ONE DOOR SERVES A ROOM A LETTER DESIGNATION FOLLOWS THE DOOR NUMBER.

NEW DOOR

ROOM NAME — ROOM NUMBER

ROOM IDENTIFICATION

5 TITLE — ⅛"=1'-0"

DETAIL, SECTION OR ELEVATION

5 / 5.12 — SECTION NUMBER — SHEET SECTION IS DRAWN ON

SECTION REFERENCE (ON PLAN)

DARKEN POINTS TO INDICATE WHICH ELEVATIONS ARE ACTUALLY DRAWN

6 / 7.08 — ELEVATION NUMBER — SHEET ELEVATION IS DRAWN ON

ELEVATION REFERENCE (ON PLAN)

ZONE A | ZONE B — AREA DESIGNATION — MATCH LINE — BUILDING LINE

MATCH LINE

15 — GRIDS FOR EXISTING CONSTRUCTION

1 - 17 ARE NORTH/SOUTH COLUMN GRID LINES.

AA - QQ DESIGNATES EAST/WEST CONCRETE COLUMN GRID LINES.

A-Q DESIGNATES EAST/WEST STEEL TUBE COLUMN GRID LINES.

STRUCTURAL GRIDS

(8'-6") — CEILING ELEVATION HEIGHT ABOVE FINISHED FLOOR — POINT OF ELEVATION

ELEVATION MARKS

FINISH LEGEND

FLOOR	CPT-1	MOHAWK COMMERCIAL, ELITE CHOICE MC031, COLOR: 503 KING'S BLUE, 12' ROLLED GOODS
	CPT-2	MOHAWK COMMERCIAL, CLASSIC IMAGE MC031, COLOR: 503 KING'S BLUE, 12' ROLLED GOODS
	CPT-3	DURKAN COMMERCIAL, LA BOUCLE, COLOR: 555 KOHL
	CPT-4	DURKAN COMMERCIAL, LA BOUCLE, COLOR: 729 MINERAL
	SV	MANNINGTON, BIOSPEC, COLOR: 15140 COOL BEIGE
	VCT	TOLI, SOLID VINYL TILE, LINOTESTA, COLOR: 516
	CFT-1	DAL-TILE, NATURAL HUES, QH08 CINDER, 6" X 6", •36 FINISH
	WM	MOHAWK COMMERCIAL, LUXOR MODULAR TILE, COLOR: 266 CHARCOAL
WALL	P-1	SHERWIN WILLIAMS, 7071SW GRAY SCREEN
	P-1E	SHERWIN WILLIAMS, SW7071 GRAY SCREEN, EPOXY FINISH
	P-2	SHERWIN WILLIAMS, SW6100 PRACTICAL BEIGE
	VWC	D.L. COUCH, SOURCE ONE, MELANGE, 2VNG-25 PEBBLE BEACH
	CT-1	DAL-TILE, 0182 SUEDE GRAY, 6" X 6", SEMI-GLOSS FINISH
	CT-2	DAL-TILE, 0136 FAWN, 6" X 6", SEMI-GLOSS FINISH
	CT-3	DAL-TILE, K-189 NAVY, 6" X 6", SEMI-GLOSS FINISH
BASE	R	ARMSTRONG, 93 GUNMETAL, 4" COVED
	IV	INTEGRAL MANNINGTON, BIOSPEC, 15112 STERLING BLUE
	CTB	DAL-TILE, NATURAL HUES, QH04 BEIGE PINPOINT, 6" X 6", COVED BASE
CEILING	AP-1	ACOUSTICAL PANEL 2' X 2'
	AP-2	ACOUSTICAL PANEL 2' X 2', FOR WET AREAS
	AP-3	ACOUSTICAL PANEL 2' X 4'
	P-1	SHERWIN WILLIAMS, SW7071 GRAY SCREEN, LRV 61½, SATIN FINISH
MILLWORK	QTZ	DUPONT, ZODIAQ, QUARTZ SURFACING, ECLIPSE BLUE
	A-1	DUPONT, CORIAN, OYSTER
	A-2	DUPONT, CORIAN, PEARL GRAY
	PL-1	PIONITE, SAGE CORAL, AV781, SUEDE FINISH
	PL-2	PIONITE, MILLWORK CHERRY, WC-431-H HI BRITE FINISH
	PL-3	PIONITE, BEIGE LINEN, AT301, SUEDE FINISH
	WD-1	STAINED WOOD VENEER TO MATCH PIONITE, MILLWORK CHERRY WC-4314-H
EXISTING	EX	EXISTING CONDITION
WAINSCOT	WS	FOR HEIGHTS REFER TO A3.20 INTERIOR TOILET ROOM ELEVATIONS

TYPICAL DOOR

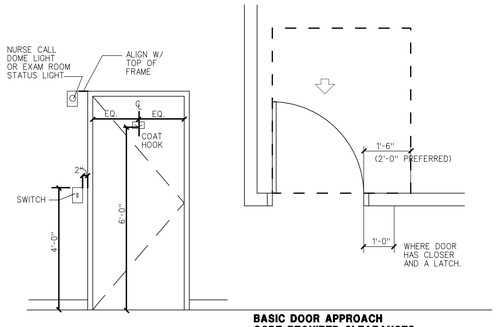

BASIC DOOR APPROACH
CODE REQUIRED CLEARANCES

US Army Corps of Engineers Huntsville Alabama

SYMBOL	AMENDMENT DESCRIPTION	DATE APPROVED
1	REVISIONS AS-BUILT	8/01/2005
2	ISSUED FOR FINAL WORK PLAN	10/31/2003
3	ISSUED FOR BID	10/01/2003

DESIGNED BY: -
DRAWN BY: -
CHECKED BY: -
REVIEWED BY: -
DATE: 10/10/2003
PROJECT NO.: 61503
DRAWING CODE: -
SOLICITATION NUMBER: -

U.S. ARMY ENGINEERING AND SUPPORT CENTER
CORPS OF ENGINEERS
HUNTSVILLE, ALABAMA

HLM DESIGN
EARTH TECH
203 Bowman Rd. • Ste Mount P. 29483 • (843) 971-2000

RENOVATE CLINIC
BUILDING 1090
LITTLE ROCK AFB, ARKANSAS

ARCHITECTURAL SYMBOLS AS-BUILT

SHEET REFERENCE NUMBER:
A0.00
SHEET X OF XX

prf
$drawn table$
dgn
$date$