1 REFLECTED CEILING PLAN

SCALE: 1/8" = 1'-0"

## CEILING LEGEND

- F5: 1X4 FLUORESCENT TROFFER OR WALL WASHER
- F2: 2X4 FLUORESCENT TROFFER
- 2X2 FLUORESCENT TROFFER
- F8: INCANDESCENT OR FLUORESCENT FIXTURE – RECESSED
- F10: INCANDESCENT OR FLUORESCENT LIGHT FIXTURE– WALL MOUNTED
- EXIT LIGHT
- UNIVERSAL–MOUNTED DIRECTIONAL ARROWS AS SHOWN ON DRAWINGS
- PENDANT FLUORESCENT FIXTURE
- SEMI–RECESSED DOWN LIGHT FIXTURE
- SUPPLY DIFFUSERS 2' X 2' OR 1' X 1'
- EXHAUST DIFFUSERS 2' X 2' OR 1' X 1'
- GYPSUM BOARD
- CURTAIN TRACK A5180. REFER TO CEILING DETAIL #3 ON SHEET A5.20
- SIDE FOLDING SECURITY GATE TRACK
- SPEAKER
- OPEN CELL CEILING SYSTEM, W/ 8"x8" LAY–IN PANEL CELLS
- EGG CRATE LENS
- SUSPENDED ACOUSTICAL CEILING SYSTEM
- SPRINKLERS

## GENERAL REFLECTED CEILING PLAN NOTES:

1. SOLID LINES INDICATE NEW CONSTRUCTION.
2. CONTRACTORS SHALL FIELD VERIFY ALL EXISTING CONSTRUCTION AND RELATED CONDITIONS PRIOR TO FABRICATION OR STARTING NEW CONSTRUCTION.
3. ALL ACOUSTIC CEILING PANELS TO BE NEW. ACOUSTIC CEILING TILES ARE TO BE FIELD CUT FROM STANDARD PANELS OF THE SAME PATTERN, TEXTURE & COLOR AS THE ADJACENT TILES. CAREFULLY CUT THESE PANELS TO THE REQUIRED LENGTHS & THEN CAREFULLY FABRICATE A REVEAL EDGE TO ALL CUT SIDES OF THESE TILES AND SPRAY PAINT THESE NEW REVEAL EDGES TO MATCH THE TILES.
4. ALL LIGHTS, DIFFUSERS, EXIT SIGNS, AND SMOKE DETECTORS SHALL BE CENTERED IN TILE OR PANEL, UNLESS OTHERWISE NOTED. SPRINKLER HEADS SHALL BE CENTERED FROM ENTRANCE A100 RUNNING SOUTH THROUGH LOBBY A103 ENDING IN WAITING AREA A196. REMAINING EXISTING SPRINKLER HEADS DO NOT HAVE TO BE CENTERED IN TILE AND SHALL BE ACCOMMODATED BY NEW ACOUSTICAL CEILING GRID.
5. ALL CEILING EXPANSION JOINTS TO BE CONTINUOUS FROM WALL JOINT TO WALL JOINT.
6. SEE FINISH SCHEDULES A4.11 FOR REQUIRED CEILING MATERIALS FOR EACH AREA.
7. INSTALL PRIVACY CURTAINS @ TREATMENT ROOM ENTRANCES. SEE DETAIL 3/A5.20.
8. SEE DIVISIONS M, P, AND E FOR COORDINATION OF MECHANICAL AND ELECTRICAL ITEMS.
9. ALL SOFFIT HEIGHTS ARE 7'–6" UNLESS NOTED OTHERWISE.
10. CENTER RECESSED LIGHTS IN CEILING TILES, AND/OR SOFFIT, UNLESS NOTED OTHERWISE.
11. ALL CEILING HEIGHTS ARE 8'–0" UNLESS NOTED OTHERWISE.
12. NOT USED
13. GYPSUM BOARD CEILINGS ARE EXISTING EXCEPT IN BATHROOMS A238 & A121.
14. EXISTING HVAC CHASE ABOVE ROOM A244. GYPSUM BOARD IS EXISTING.
15. NOT USED
16. REPLACE EXISTING ACOUSTIC CEILING PANELS AND GRID @ EXISTING HEIGHT A.F.F. UNLESS NOTED OTHERWISE.
17. NOT USED
18. REFER TO DIVISION 09120 OPEN CELL CEILING SYSTEM FOR INFORMATION ABOUT 8" SUSPENDED METAL GRID.
19. SUSPEND ACOUSTICAL CEILING SYSTEM SHALL EXTEND ABOVE OPEN CELL CEILING SYSTEM.
20. OPEN CELL CEILING GRID TO BE AT 7'–8" AFF UNLESS NOTED OTHERWISE.
21. ALL GYP BD SOFFITS TO BE PAINTED P–1 UNLESS NOTED OTHERWISE.

## KEYED NOTES:

1 RADIUS OF CEILING GRID AND GYP BD CEILING TO ALIGN WITH RADIUS OF CARPET FLOOR FINISH. REFER TO FLOOR PATTERN PLAN. OPEN CELL CEILING GRID @ 7'–8" AFF.

2 RADIUS OF GYP BD SOFFIT TO ALIGN WITH THE INSIDE RADIUS OF TRANSACTION COUNTERTOP AND WORKSURFACE. GYP BD SOFFIT @ 7'–6" AFF. PAINT GYP BD SOFFIT P–1.

3 BOTTOM OF GYP BD SOFFIT IS @ 7'–6" AFF.

4 NOT USED.

5 BOTTOM OF GYP BD SOFFIT IS @ 8'–0" AFF.

6 BOTTOM OF CEILING IS @ 8'–0" AFF.

7 BOTTOM OF GYP BD SOFFIT IS @ 8'–6" AFF. REFER TO DETAIL 15/A–5.20

8 24" X 24" ACCESS PANEL

9 18" X 18" ACCESS PANEL

10 12" X 12" ACCESS DOOR

KEYPLAN
N.T.S.
NORTH
0 4' 8' 16'
SCALE

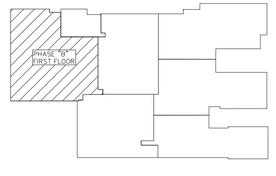


AIR EDUCATION & TRAINING COMMAND
LITTLE ROCK A.F.B.
ARKANSAS

FPM

804 West Curtis Drive, Suite H
Midwest City, OK 73110
phone: 405.869.9212
fax: 405.869.9222
www.fpm-group.com

RECORD DRAWINGS MARCH 2007

| No. | Revision/Issue | Date | BY | APP'D |
|---|---|---|---|---|

PROJECT TITLE: REPAIR MEDICAL CENTER PH B
LITTLE ROCK AFB, ARKANSAS

SHEET TITLE: REFLECTED CEILING PLAN

| | |
|---|---|
| DRAWN BY: RJR | LEAD DESIGNER: AM |
| TECH REVIEWER: AM | PROJECT NUMBER: NKAK 05–8004A |
| DESIGNED BY: KF & BL | SHEET: A2.11 |
| DATE: 1–21–08 | 7 OF 39 |
| SCALE: 1/8"=1'–0" | |