ROOM FINISH SCHEDULE

ROOM NUMBER	NAME	FLOOR		BASE		NORTH WALL		SOUTH WALL		EAST WALL		WEST WALL		CEILING			REMARKS
		MAT'L	COLOR	MAT'L	COLOR	MAT'L	COLOR	MAT'L	COLOR	MAT'L	COLOR	MAT'L	COLOR	MAT'L	COLOR	CEILING HEIGHT	
B-100	CORR	CPT	CPT-3	RB	RB-1	GYP	VWC-1	GYP	VWC-1	GYP	VWC-1	GYP	VWC-1	EX	EX	---	
B-102	FAMILY ADVOCACY WAITING ROOM	CPT	CPT-1,3	RB	RB-1	GYP	VWC-1	GYP	VWC-1	GYP	VWC-1	GYP	VWC-1	ACT	ACT-1	9'-0"	
B-103	LIFE SKILLS WAITING ROOM	CPT	CPT-1,3	RB	RB-1	GYP	VWC-1	GYP	VWC-1	GYP	VWC-1	GYP	VWC-1	ACT	ACT-1	9'-0"	
B-104	LIFE SKILLS RECEPT/TECH	CPT	CPT-1	RB	RB-1	GYP	P-1	GYP	P-1	GYP	P-1	GYP	P-1	ACT	ACT-1	8'-0"	
B-105	LIFE SKILLS TECH	CPT	CPT-2	RB	RB-1	GYP	P-1	GYP	P-4	GYP	P-4	GYP	P-1	ACT	ACT-1	8'-0"	
B-106	VITALS	CPT	CPT-1	RB	RB-1	GYP	P-1	GYP	P-1	GYP	P-1	GYP	P-1	GYP	P-3	8'-0"	
B-107	LIFE SKILLS PSYCH TESTING	CPT	CPT-2	RB	RB-1	GYP	P-1	GYP	P-4	GYP	P-4	GYP	P-1	ACT	ACT-1	9'-0"	
B-108	CORR	CPT	CPT-1	RB	RB-1	GYP	VWC-1	GYP	VWC-1	GYP	VWC-1	GYP	VWC-1	ACT	ACT-1	8'-0"	
B-109	A.D.P. OFFICE	CPT	CPT-2	RB	RB-1	GYP	P-1	GYP	P-4	GYP	P-1	GYP	P-4	ACT	ACT-1	8'-0"	
B-110	LIFE SKILLS TECH	CPT	CPT-2	RB	RB-1	GYP	P-1	GYP	P-4	GYP	P-4	GYP	P-1	ACT	ACT-1	9'-0"	
B-111	LIFE SKILLS RECORDS	CPT	CPT-1	RB	RB-1	GYP	P-1	GYP	P-1	GYP	P-1	GYP	P-1	ACT	ACT-1	9'-0"	
B-112	LIFE SKILLS NCOIC	CPT	CPT-2	RB	RB-1	GYP	P-1	GYP	P-4	GYP	P-4	GYP	P-1	ACT	ACT-1	9'-0"	
B-113	FAM ADVOC RECORDS	CPT	CPT-1	RB	RB-1	GYP	P-1	GYP	P-1	GYP	P-1	GYP	P-1	ACT	ACT-1	9'-0"	
B-114	LIFE SKILLS PLT/CC	CPT	CPT-2	RB	RB-1	GYP	P-1	GYP	P-4	GYP	P-4	GYP	P-1	ACT	ACT-1	9'-0"	
B-115	UNISEX TOILET	CT	CT-1	CTB	CTB-1	CT/GYP	CT-2,3/P-3	CT/GYP	CT-2,3/P-3	CT/GYP	CT-2,3/P-3	CT/GYP	CT-2,3/P-3	GYP	P-3	8'-0"	See note 4
B-116	LIFE SKILLS PSYCH	CPT	CPT-2	RB	RB-1	GYP	P-1	GYP	P-4	GYP	P-4	GYP	P-1	ACT	ACT-1	9'-0"	
B-117	ELEC	EX	---	RB	RB-1	GYP	P-3	GYP	P-3	GYP	P-3	GYP	P-3	ACT	ACT-1	8'-0"	
B-118	LIFE SKILLS PSYCH	CPT	CPT-2	RB	RB-1	GYP	P-1	GYP	P-4	GYP	P-4	GYP	P-1	ACT	ACT-1	9'-0"	
B-119	GROUP THERAPY	CPT	CPT-2	RB	RB-1	GYP	P-1	GYP	P-1	GYP	P-1	GYP	P-1	ACT	ACT-1	8'-0"	
B-120	LIFE SKILLS SOCIAL WORKER	CPT	CPT-2	RB	RB-1	GYP	P-1	GYP	P-4	GYP	P-4	GYP	P-1	ACT	ACT-1	9'-0"	
B-121	GROUP THERAPY	CPT	CPT-2	RB	RB-1	GYP	P-1	GYP	P-1	GYP	P-1	GYP	P-1	ACT	ACT-1	8'-0"	
B-122	LIFE SKILLS SOCIAL WORKER	CPT	CPT-2	RB	RB-1	GYP	P-1	GYP	P-4	GYP	P-4	GYP	P-1	ACT	ACT-1	9'-0"	
B-123	LIBRARY	CPT	CPT-2	RB	RB-1	GYP	P-1	GYP	P-1	GYP	P-1	GYP	P-1	ACT	ACT-1	8'-0"	
B-124	LIFE SKILLS COUNCELOR	CPT	CPT-2	RB	RB-1	GYP	P-1	GYP	P-4	GYP	P-4	GYP	P-1	ACT	ACT-1	9'-0"	
B-125	LIFE SKILLS PSYCH	CPT	CPT-2	RB	RB-1	GYP	P-1	GYP	P-4	GYP	P-1	GYP	P-4	ACT	ACT-1	8'-0"	
B-126	LIFE SKILLS INTAKE	CPT	CPT-2	RB	RB-1	GYP	P-1	GYP	P-4	GYP	P-4	GYP	P-1	ACT	ACT-1	9'-0"	
B-127	LIFE SKILLS NURSE	CPT	CPT-2	RB	RB-1	GYP	P-1	GYP	P-4	GYP	P-1	GYP	P-4	ACT	ACT-1	8'-0"	
B-128	MECH	EX	---	RB	RB-1	GYP	P-3	GYP	P-3	GYP	P-3	GYP	P-3	ACT	ACT-1	8'-0"	
B-128A	COMM	EX	---	RB	RB-1	GYP	P-3	GYP	P-3	GYP	P-3	GYP	P-3	ACT	ACT-1	8'-0"	
B-130	CORR	CPT	CPT-1	RB	RB-1	GYP	VWC-1	GYP	VWC-1	GYP	VWC-1	GYP	VWC-1	ACT/GYP	ACT-1/P-3	8'-0"	
B-130A	CORR	CPT	CPT-1	RB	RB-1	GYP	VWC-1	GYP	VWC-1	GYP	VWC-1	GYP	VWC-1	ACT	ACT-1	8'-0"	
B-131	CORR	CPT	CPT-1	RB	RB-1	GYP	VWC-1	GYP	VWC-1	GYP	VWC-1	GYP	VWC-1	ACT/GYP	ACT-1/P-3	8'-0"	
B-132	OUTREACH EDUCATION CLASSROOM	CPT	CPT-2	RB	RB-1	GYP	P-1	GYP	P-1	GYP	P-1	GYP	P-1	ACT	ACT-1	9'-0"	
B-133	STOR	SV	SV-1	RB	RB-1	GYP	P-3	GYP	P-3	GYP	P-3	GYP	P-3	ACT	ACT-1	9'-0"	See note 17
B-134	FAM ADVOC RECEPT/TECH	CPT	CPT-2	RB	RB-1	GYP	P-1	GYP	P-4	GYP	P-1	GYP	P-4	ACT	ACT-1	8'-0"	
B-135	FAM ADVOC TECH	CPT	CPT-2	RB	RB-1	GYP	P-1	GYP	P-4	GYP	P-1	GYP	P-4	ACT	ACT-1	8'-0"	
B-136	FAM ADVOC TECH	CPT	CPT-2	RB	RB-1	GYP	P-1	GYP	P-4	GYP	P-1	GYP	P-4	ACT	ACT-1	8'-0"	
B-137	FAM ADVOC SOCIAL WORKER	CPT	CPT-2	RB	RB-1	GYP	P-1	GYP	P-4	GYP	P-1	GYP	P-4	ACT	ACT-1	8'-0"	
B-138	FAM ADVOC SOCIAL WORKER	CPT	CPT-2	RB	RB-1	GYP	P-1	GYP	P-4	GYP	P-1	GYP	P-4	ACT	ACT-1	8'-0"	
B-139	FAM ADVOC SOCIAL WORKER	CPT	CPT-2	RB	RB-1	GYP	P-1	GYP	P-4	GYP	P-1	GYP	P-4	ACT	ACT-1	8'-0"	
B-140	FAM ADVOC NURSE	CPT	CPT-2	RB	RB-1	GYP	P-1	GYP	P-4	GYP	P-1	GYP	P-4	ACT	ACT-1	8'-0"	
B-141	CORR	CPT	CPT-1	RB	RB-1	GYP	VWC-1	GYP	VWC-1	GYP	VWC-1	GYP	VWC-1	EX	EX	8'-0"	

COLOR LEGEND

CARPET		
CPT-1	MOHAWK COMMERCIAL	ELITE CHOICE MC031, 503 KINGS BLUE, 12' BROADLOOM
CPT-2	MOHAWK COMMERCIAL	CLASSIC IMAGE MC031, 503 KINGS BLUE, 12' BROADLOOM
CPT-3	DURKAN COMMERCIAL	LA BOUCLE, 555 KOHL, 12' BROADLOOM
PAINT		
P-1	SHERWIN WILLIAMS	PRACTICAL BEIGE, SW6100 (TYPICAL WALL)
P-2	NOT USED	NOT USED
P-3	BENJAMIN MOORE	INTENSE WHITE, OC-51
P-4	SHERWIN WILLIAMS	GRAY SCREEN, SW7071
WALLCOVERING		
VWC-1	EYKON	SOURCE ONE EXCLUSIVE, MELANGE #2VNG-25, PEBBLE BEACH
CERAMIC TILE		
CT-1	DALTILE	NATURAL HUES, QH08 CINDER, 6" X 6"
CT-2	DALTILE	K189 NAVY, 6" X 6" SEMI-GLOSS
CT-3	DALTILE	0182 SUEDE GRAY, 6" X 6" SEMI-GLOSS
SOLID SURFACE		
SS-1	DUPONT	ZODIAQ, QUARTZ SURFACES, ECLIPSE BLUE
SS-2	DUPONT	CORIAN, PEARL GRAY (B) - WINDOW SILLS
SS-3	DUPONT	CORIAN, OYSTER (F)
PLASTIC LAMINATE		
PL-1	PIONITE	MILLWORK CHERRY, WC-431-H, HI BRITE FINISH
CERAMIC TILE BASE		
CTB-1	DALTILE	0182 SUEDE GRAY, 6" X 6" SEMI-GLOSS
RESILIENT BASE		
RB-1	JOHNSONITE	92 BLUE LAGOON, 4" H
GROUT		
G-1	CUSTOM BLDG PRODUCTS	NATURAL GRAY #9
G-2	CUSTOM BLDG PRODUCTS	WINTER GRAY #335
SHEET VINYL		
SV-1	MANNINGTON	BIOSPEC, 15140 COOL BEIGE
ACOUSTICAL TILE		
ACT-1	ARMSTRONG	CORTEGA TEGULAR, ITEM 704, 2'X2'X$\frac{5}{8}$" TILE, $\frac{15}{16}$" GRID

GENERAL NOTES

1. CT-1 TO RECEIVE G-1
2. CT-2, CT-3 AND CTB-1 TO RECEIVE G-2
3. CRASH RAIL AND CORNER GUARDS TO MATCH KOROGARD, K-16, PEWTER. RECESSED CORNER GUARD, 2" MODEL R100. RECESSED END CAP, AS NEEDED, MODEL R110. CRASH RAIL, 8" MODEL C870.
4. CERAMIC TILE WAINSCOT IN UNISEX TOILET B-115 TO EXTEND 5'-6" A.F.F.
5. ALL HM DOOR FRAMES AND TRIM TO BE P-4.
6. UNISEX TOILET B-115, MECH B-128, COMM B-128A, ELEC B-117 TO RECEIVE EPOXY PAINT FINISH.
7. WALL AND CEILING PAINT TO BE SATIN FINISH. DOOR FRAME AND TRIM TO BE SEMI-GLOSS.
8. CARPET TO CERAMIC TILE TRANSITION TO BE 2" WIDE, GRAY MARBLE, WITH DOUBLE BEVELED EDGES.
9. CARPET TO VINYL THRESHOLD TO BE SOLID METAL STRIP.
10. SOFFIT PAINT TO MATCH WALL UNLESS NOTED OTHERWISE
11. WOOD DOORS TO RECEIVE STAIN. H.M. DOORS TO RECEIVE PAINT.
12. ALL EXTERIOR WINDOWS AND LIFE SKILLS WAITING ROOM B-103 INTERIOR WINDOW ARE TO RECEIVE BALI SNOWCAP WHITE 386 MINI BLINDS.
13. WINDOW SILLS: SS-2 TO MATCH EXISTING.
14. RECEPTION DESK MILLWORK: VERTICAL SURFACE TO RECEIVE PL-1, HORIZONTAL SURFACE TO RECEIVE SS-1 AND SS-3.
15. FLOOR TO RECEIVE CLEAR SEALER IN MECH B-128 & COMM B-128A.
16. REFER TO I-101 FOR FLOOR PATTERNS AND WALL PROTECTION PLACEMENT.
17. SHEET VINYL TO HAVE HEATED WELDED SEAMS AND INTEGRAL COVE BASE.

MATERIALS LEGEND

CPT	CARPET
P	PAINT
CT	CERAMIC TILE
CTB	CERAMIC TILE BASE
VWC	VINYL WALLCOVERING
RB	RESILIENT BASE
SS	SOLID SURFACE
GYP	GYPSUM WALL BOARD
G	GROUT
ACT	ACOUSTICAL CEILING TILE
EX	EXISTING
PL	PLASTIC LAMINATE
SV	SHEET VINYL
---	NONE OR NOT APPLICABLE

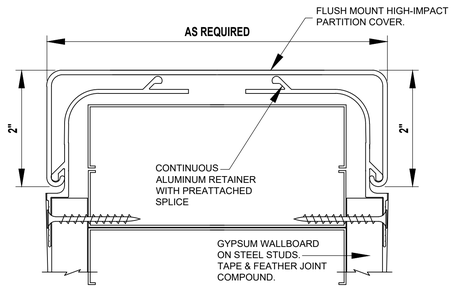

4 / A-601 FLUSH MOUNT END WALL PROTECTOR
NTS

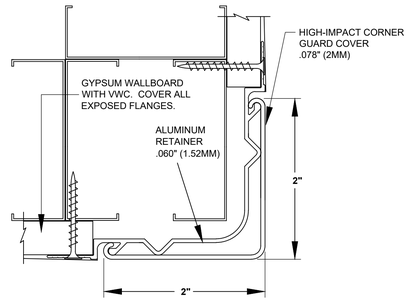

5 / A-601 FLUSH MOUNT CORNER GUARD
NTS

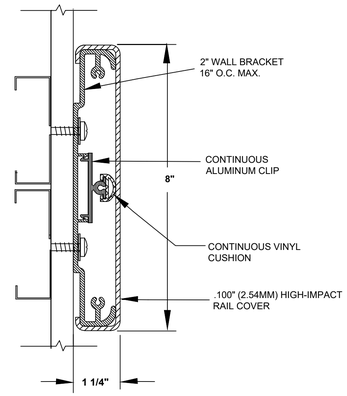

6 / A-601 CRASH RAIL WALL GUARD
NTS

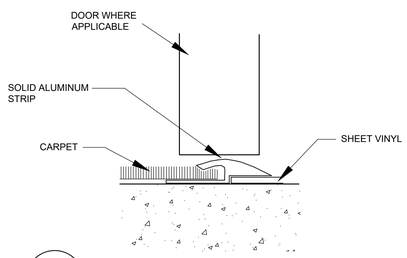

1 / A-601 CARPET TO SHEET VINYL
NTS

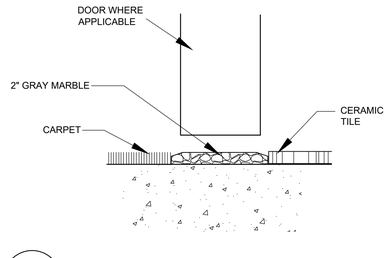

2 / A-601 CARPET TO CERAMIC TILE
NTS

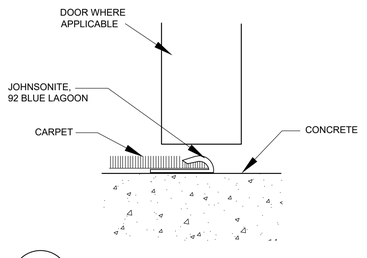

3 / A-601 CARPET TO CONCRETE
NTS

LITTLE ROCK A.F.B.
ARKANSAS

GARVER | ENGINEERS
1010 BATTERY STREET
LITTLE ROCK, ARKANSAS 72202
www.garverengineers.com
(501) 376-3633

CROMWELL
ARCHITECTS ENGINEERS
101 SOUTH SPRING ST
LITTLE ROCK AR 72201
TELEPHONE 501-372-2900
FACSIMILE 501-372-0482

No.	Revision/Issue	Date	BY	APP'D

PROJECT TITLE
REPAIR & RENOVATE MEDICAL CLINIC PH V
LITTLE ROCK AIR FORCE BASE
JACKSONVILLE, ARKANSAS
100% SUBMITTAL

SHEET TITLE
FINISH SCHEDULE

DRAWN BY: M. DEES	LEAD DESIGNER: K. TAYLOR
TECH REVIEWER: PJL	PROJECT NUMBER: NKAK#06-8006-5
DESIGNED BY: M. DEES	SHEET: A-601
DATE: 7 MAY 2008	
SCALE: 1/8"=1'-0"	9 OF 27