ARCHITECTURAL SYMBOLS

NORTH REFERENCE

NORTH EAST SOUTH WEST
5 TITLE

INTERIOR ELEVATION

5 / 5.07 — DETAIL NUMBER; SHEET DETAIL IS DRAWN ON

DETAIL REFERENCE (ON PLAN)

5 TITLE

DETAIL, SECTION OR ELEVATION

5 / 5.12 — SECTION NUMBER; SHEET SECTION IS DRAWN ON

SECTION REFERENCE (ON PLAN)

6 / 7.05 — DARKEN POINTS TO INDICATE WHICH ELEVATIONS ARE ACTUALLY DRAWN; ELEVATION NUMBER; SHEET ELEVATION IS DRAWN ON

ELEVATION REFERENCE (ON PLAN)

A — GRIDS FOR EXISTING CONSTRUCTION

STRUCTURAL GRIDS

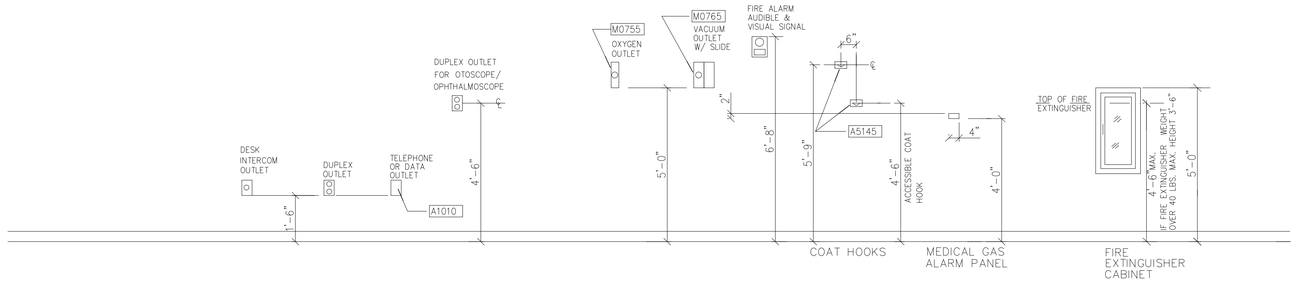

GENERAL NOTES

1. THE HEIGHTS SHOWN ON THESE DRAWINGS ARE TYPICAL AND DO NOT NECESSARILY SHOW ALL THE DEVICES THAT ARE LOCATED ON THE WALLS.
2. THE OBJECT OF THESE ELEVATIONS IS TO ESTABLISH GUIDELINES FOR THE VERTICAL LOCATION OF WALL MOUNTED DEVICES GENERALLY THROUGHOUT THE PROJECT.
3. SEE ENLARGED TOILET PLANS A3.10 FOR ADDITIONAL TOILET ACCESSORIES AND ACTUAL ROOM DIMENSIONS.
4. REFER TO A3.10 ACCESSORIES LEGEND FOR ITEM IDENTIFICATION.

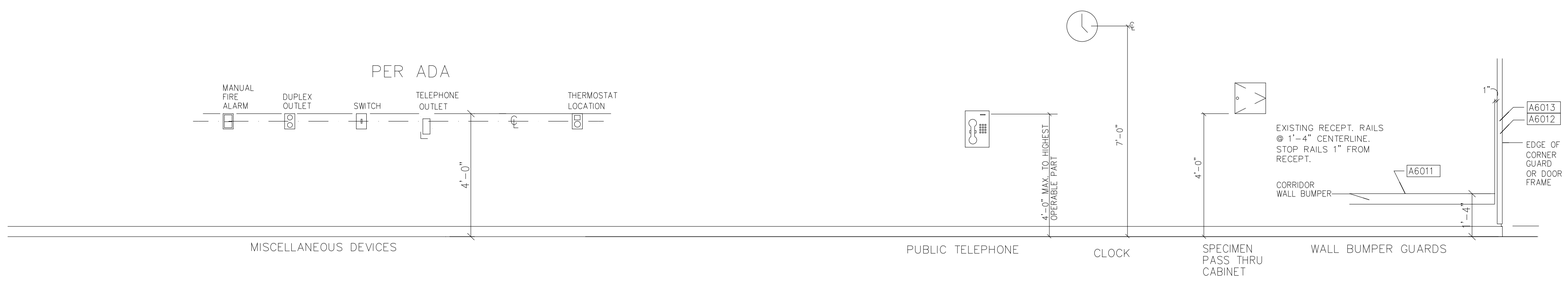

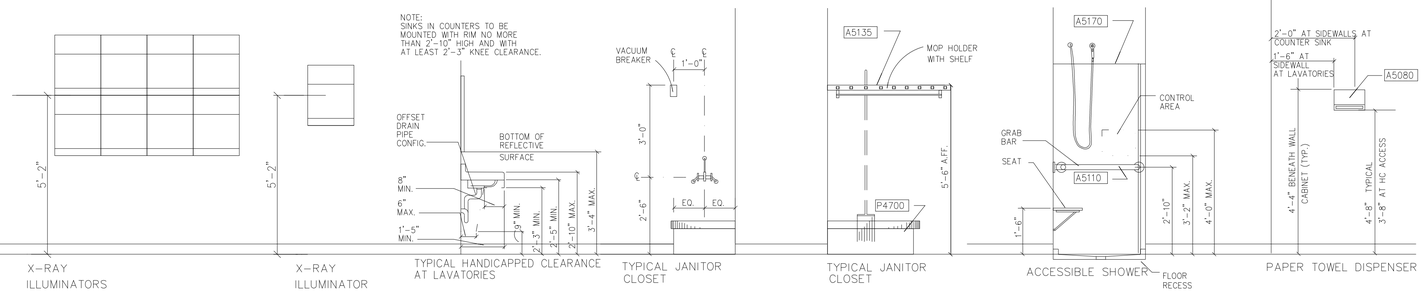

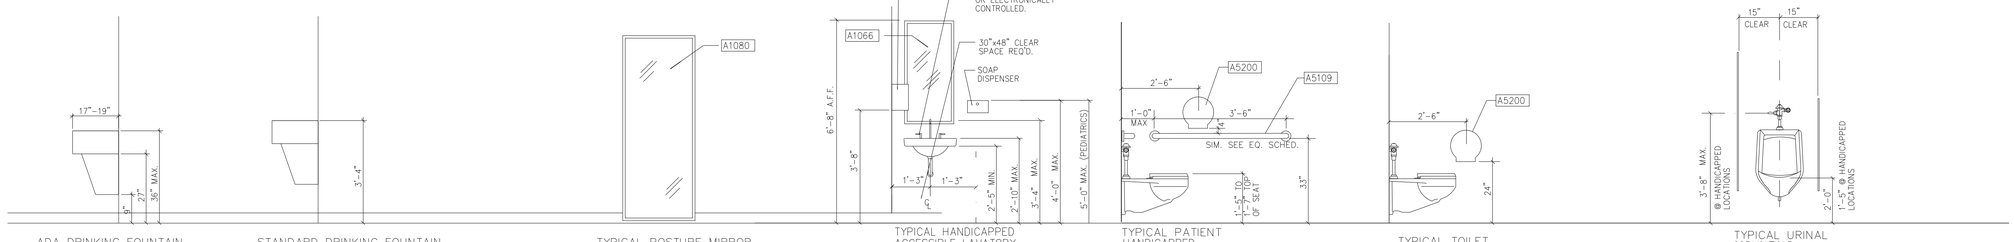

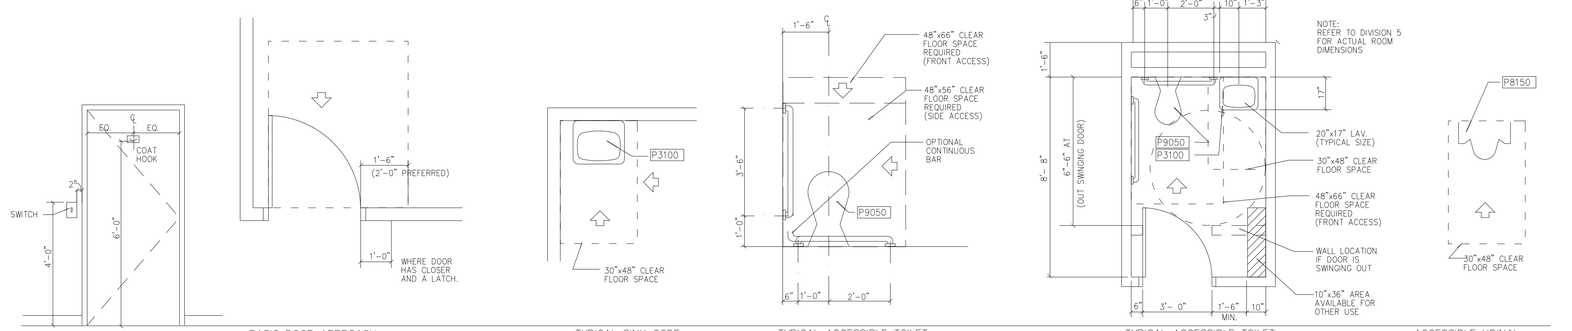

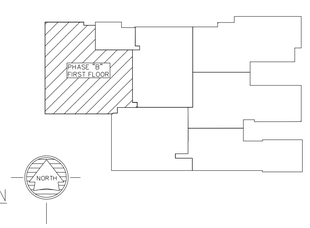

LITTLE ROCK A.F.B.
ARKANSAS

FPM

804 West Curtis Drive, Suite H
Midwest City, OK 73110
phone: 405.869.9212
fax: 405.869.9222
www.fpm-group.com

RECORD DRAWINGS MARCH 2007

No.	Revision/Issue	Date	BY	APP'D

PROJECT TITLE: REPAIR MEDICAL CENTER PH B
LITTLE ROCK AFB, ARKANSAS

SHEET TITLE: TYPICAL MOUNTING HEIGHTS

DRAWN BY: RJR	LEAD DESIGNER: AM
TECH REVIEWER: AM	PROJECT NUMBER: NKAK 05-8004A
DESIGNED BY: AM	SHEET: Q0.00
DATE: 1-21-08	18 OF 39
SCALE: N/A	