DOOR AND FRAME SCHEDULE

DR. NO.	DOOR						FRAME					FIRE RATING	HDW SET	REMARKS
							TYPE	MAT'L	DETAILS					
	TYPE	WIDTH	HEIGHT	THK.	MAT'L	GLAZING			HEAD	JAMB	THRESHOLD			
01	A	3'-0"	7'-0"	1 3/4"	WD	--	A	HM	5/A501SIM	5/A501	--	--	--	EXIT HARDWARE
02	B	3'-0"	7'-0"	1 3/4"	WD	--	A	HM	5/A501SIM	5/A501	--	--	--	ELECTRIC STRIKE/EXIT HARDWARE
03	B	3'-0"	7'-0"	1 3/4"	WD	--	A	HM	6/A501SIM	6/A501	--	--	--	CARD SWIPE ACCESS
04	A	3'-0"	7'-0"	1 3/4"	WD	--	A	HM	6/A501SIM	6/A501	--	--	--	--
05	A	3'-0"	7'-0"	1 3/4"	WD	--	A	HM	5/A501SIM	5/A501	--	--	--	--
06	A	3'-0"	7'-0"	1 3/4"	WD	--	A	HM	5/A501SIM	5/A501	--	--	--	--
07	A	3'-0"	7'-0"	1 3/4"	WD	--	A	HM	5/A501SIM	5/A501	--	--	--	SMOKE RESISTIVE
08	A	3'-0"	7'-0"	1 3/4"	WD	--	A	HM	5/A501SIM	5/A501	--	--	--	--
09	A	3'-0"	7'-0"	1 3/4"	WD	--	A	HM	5/A501SIM	5/A501	--	--	--	--
10	A	3'-0"	7'-0"	1 3/4"	WD	--	A	HM	5/A501SIM	5/A501	--	--	--	--
11	A	3'-0"	7'-0"	1 3/4"	WD	--	A	HM	5/A501SIM	5/A501	--	--	--	--
12	B	3'-0"	7'-0"	1 3/4"	WD	--	A	HM	5/A501SIM	5/A501	--	--	--	CARD SWIPE ACCESS BOTH SIDES/ GEN NOTE 6
13	A	3'-0"	7'-0"	1 3/4"	WD	--	A	HM	6/A501SIM	6/A501	--	--	--	--
14	A	3'-0"	7'-0"	1 3/4"	WD	--	A	HM	5/A501SIM	5/A501	--	--	--	--
15	A	3'-0"	7'-0"	1 3/4"	WD	--	A	HM	5/A501SIM	5/A501	--	--	--	--
16	A	3'-0"	7'-0"	1 3/4"	WD	--	A	HM	6/A501SIM	6/A501	--	--	--	--
17	A	3'-0"	7'-0"	1 3/4"	WD	--	A	HM	5/A501SIM	5/A501	--	--	--	--
18	A	3'-0"	7'-0"	1 3/4"	WD	--	A	HM	5/A501SIM	5/A501	--	--	--	--
19	A	3'-0"	7'-0"	1 3/4"	WD	--	A	HM	6/A501SIM	6/A501	--	--	--	--
20	A	3'-0"	7'-0"	1 3/4"	WD	--	A	HM	5/A501SIM	5/A501	--	--	--	--
21	A	3'-0"	7'-0"	1 3/4"	WD	--	A	HM	6/A501SIM	6/A501	--	--	--	--
22	C	5'-0"	7'-0"	1 3/4"	WD	--	B	HM	7/A501	6/A501	--	--	--	--
23	A	3'-0"	7'-0"	1 3/4"	WD	--	A	HM	5/A501SIM	5/A501	--	--	--	--
24	A	3'-0"	7'-0"	1 3/4"	WD	--	A	HM	5/A501SIM	5/A501	--	--	--	--
25	B	3'-0"	7'-0"	1 3/4"	WD	--	A	HM	5/A501SIM	5/A501	--	--	--	CARD SWIPE ACCESS/EXIT HARDWARE
26	B	3'-6"	7'-0"	1 3/4"	WD	--	A	HM	6/A501SIM	6/A501	--	--	--	EXIT HARDWARE/VERIFY & MATCH (E) DR SIZE
27	A	3'-0"	7'-0"	1 3/4"	WD	--	A	HM	5/A501SIM	5/A501	--	--	--	--
28	A	3'-0"	7'-0"	1 3/4"	WD	--	A	HM	5/A501SIM	5/A501	--	--	--	--
29	A	3'-0"	7'-0"	1 3/4"	WD	--	A	HM	6/A501SIM	6/A501	--	--	--	--
30	A	3'-0"	7'-0"	1 3/4"	WD	--	A	HM	6/A501SIM	6/A501	--	--	--	--
31	A	3'-0"	7'-0"	1 3/4"	WD	--	A	HM	5/A501SIM	5/A501	--	--	--	--
32	A	3'-0"	7'-0"	1 3/4"	WD	--	A	HM	5/A501SIM	5/A501	--	--	--	--
33	A	3'-0"	7'-0"	1 3/4"	WD	--	A	HM	--	--	--	--	--	CARD SWIPE ACCESS
34	A	3'-0"	7'-0"	1 3/4"	WD	--	A	HM	5/A501SIM	5/A501	--	--	--	--
35	A	3'-0"	7'-0"	1 3/4"	WD	--	A	HM	5/A501SIM	5/A501	--	--	--	--
36	A	3'-0"	7'-0"	1 3/4"	WD	--	A	HM	--	--	--	--	--	SMOKE RESISTIVE
37	B	3'-0"	7'-0"	1 3/4"	WD	--	A	HM	5/A501SIM	5/A501	--	--	--	CARD SWIPE ACCESS
38	B	3'-0"	7'-0"	1 3/4"	WD	--	A	HM	5/A501SIM	5/A501	--	--	--	ELECTRIC STRIKE/EXIT HARDWARE
39	A	3'-0"	7'-0"	1 3/4"	WD	--	A	HM	5/A501SIM	5/A501	--	--	--	EXIT HARDWARE
40	D	10'-0"	8'-0"	1 3/4"	--	--	--	--	10/A501	11/A501	--	--	--	MANUAL ACCORDIAN DOOR
41	A	3'-0"	7'-0"	1 3/4"	WD	--	A	HM	6/A501SIM	6/A501	--	--	--	--
42	B	3'-0"	7'-0"	1 3/4"	WD	--	A	HM	5/A501SIM	5/A501	--	--	--	CARD SWIPE ACCESS/ EXIT HARDWARE
43	A1	3'-6"	7'-0"	1 3/4"	HM	--	A1	HM	6/A501SIM	6/A501	--	1 HR	--	EXIT HARDWARE/ VERIFY & MATCH (E) DR SIZE

GENERAL DOOR SCHEDULE NOTES:

1. ALL DOORS SHALL HAVE ADJUSTABLE CLOSERS WITH STOP SET CAPABILITY.
2. ALL DOORS SHALL HAVE AUTOMATIC DROP SEAL DOOR BOTTOMS U.N.O.
3. ALL HARDWARE SHALL BE ADA ACCESSIBLE LEVER TYPE TO MATCH EXISTING FACILITY. SEE SPECIFICATIONS.
4. CONTRACTOR SHALL FURNISH & INSTALL TEMPORARY CONSTRUCTION LOCK CORES. PERMENANT LOCK CORES SHALL BE CONTRACTOR FURNISHED & GOVERNMENT INSTALLED.
5. EMPLOYEE CARD SWIPES & PROGRAMMING SHALL BE CONTRACTOR FURNISHED & CONTRACTOR INSTALLED. CONTRACTOR SHALL PROVIDE ALL HARDWARE PREPARATION & UTILITIES REQUIRED FOR AN OPERATIONAL SYSTEM COMPATIBLE WITH THE EXISTING FACILITIES SECURITY SYSTEM.
6. PROVIDE MIN 2" HIGH TEXT ON BOTH SIDES OF DOOR THAT READS "NOT AN EXIT".
7. ALL H.M. DOOR FRAMES SHALL HAVE "TERMINATED" STOPS. EXCEPTIONS: FIRE & SMOKE DOORS.

DOOR TYPES

1/4"

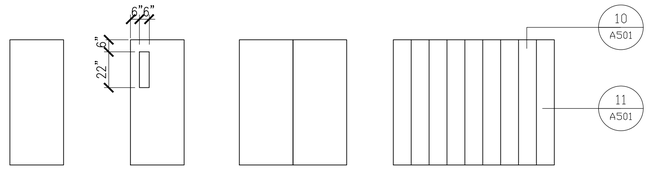

A — SOLID CORE WOOD
MIN STC=44
A1 — HOLLOW METAL

B — SOLID CORE WOOD W/ ¼" CLEAR TEMPERED VISION PANEL.
MIN STC=44

C — PAIR-SOLID CORE WOOD
MIN STC=44

D — MANUAL OPERATED ACCORDIAN DOOR. MIN STC=39 FABRIC COVERED PANELS

DOOR FRAME TYPES

1/4"

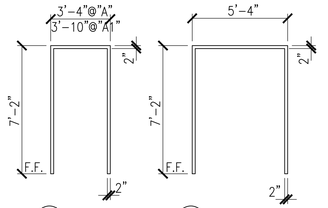

A HM
A1 HM

B HM

WINDOW TYPES

1/4"

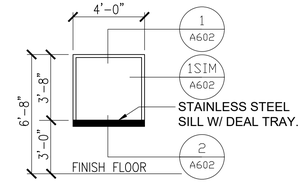

A BULLET RESISTANT WINDOW
STEEL FRAME (FACTORY PRIMED/FIELD PAINTED TO MATCH DOOR FRAMES) WITH STAINLESS STEEL SILL/DEAL TRAY & VOICE TRANSMISSION DEVICE. BULLET RESISTANT GLAZING.UL LISTED LEVEL 2 BALLISTICS.

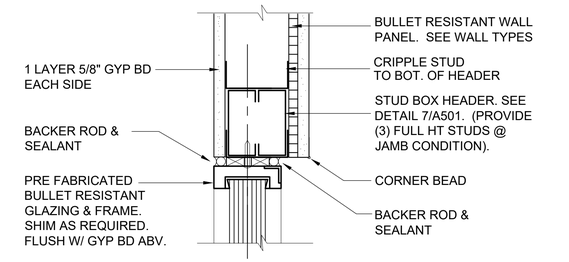

1 HEAD— BULLET RESISTANT WINDOW
1-1/2"=1'-0"

JAMB SIMILAR

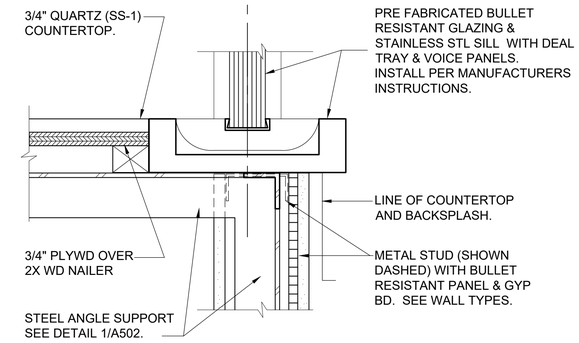

2 SILL— BULLET RESISTANT WINDOW
1-1/2"=1'-0"

LITTLE ROCK A.F.B.
ARKANSAS

GARVER | ENGINEERS
1010 BATTERY STREET
LITTLE ROCK, ARKANSAS 72202
www.garverengineers.com
(501) 376-3633

CROMWELL
ARCHITECTS ENGINEERS
101 SOUTH SPRING ST
LITTLE ROCK AR 72201
TELEPHONE 501-372-2900
FACSIMILE 501-372-0482

No.	Revision/Issue	Date	BY	APP'D

PROJECT TITLE
REPAIR & RENOVATE MEDICAL CLINIC PH V
LITTLE ROCK AIR FORCE BASE
JACKSONVILLE, ARKANSAS
100% SUBMITTAL

SHEET TITLE
DOOR SCHEDULE, DOOR & WINDOW TYPES, DETAILS

DRAWN BY: PJL	LEAD DESIGNER: K. TAYLOR
TECH REVIEWER: PJL	PROJECT NUMBER: NKAK#06-8006-5
DESIGNED BY: P. LEDFORD	SHEET: A-602
DATE: 7 MAY 2008	10 OF 27
SCALE: AS NOTED	