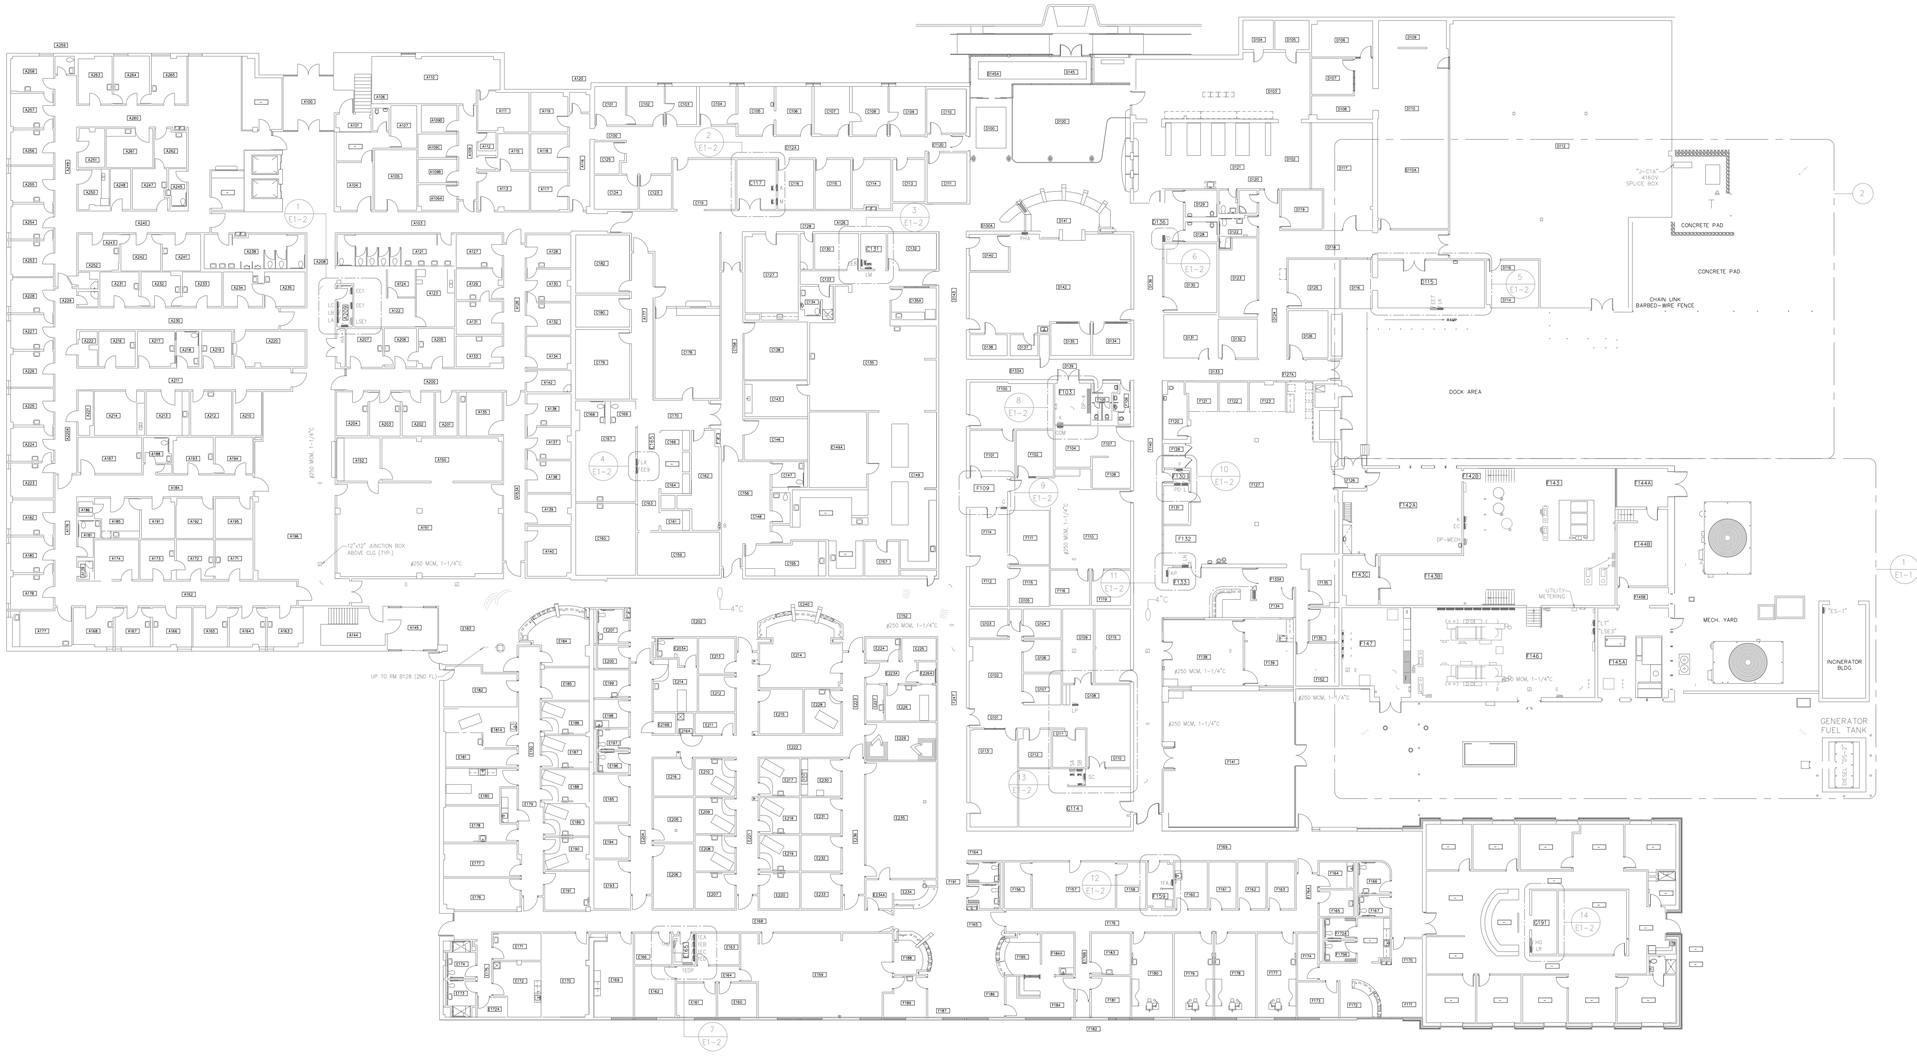

1 FIRST FLOOR ELECTRICAL REFERENCE PLAN
SCALE: 1/16" = 1'-0"

2 SERVICE YARD PLAN
SCALE: 1/16" = 1'-0"

GENERAL NOTES:

1. HEAVY TONE LINEWORK AND TEXT DENOTE NEW WORK. LIGHT TONE LINEWORK AND TEXT DENOTES EXISTING CONDITIONS TO REMAIN. DASHED LINEWORK DENOTES CONDUIT/WIRE RUN UNDERGROUND.
2. REFER TO SHEET E-1 FOR SYMBOL LIST, ABBREVIATIONS AND GENERAL NOTES.
3. REFER TO SHEETS E4-1 & E4-2 FOR RISER DIAGRAMS.
4. REFER TO SHEET E6-1 FOR GROUNDING DETAILS.

NOTICE: THIS IS THE PERSONAL PROPERTY OF KROESCHELL ENGINEERING CO. AND ALL USE IS FORBIDDEN EXCEPT UPON WRITTEN CONSENT.

CAD Filename: K\\Air Force Bases\Little Rock\11599	DATE REVISED
ORIGINAL P-No. 10796	
ADDITIONS AND REVISIONS	
65% DESIGN REVIEW	12/23/09
ISSUED FOR 100% SUBMITTAL	4/9/10
AS-BUILTS	10/4/10

DRAWN BY:	JP
CHECKED BY:	RPK
APPROVED BY:	WAM
SCALE:	1/16" = 1'-0"
DATE	NOV 2009

JOB No.

Sheet No.

AS-BUILTS 10/4/10