LIGHT FIXTURE SCHEDULE

TYPE	DESCRIPTION	MANUFACTURER CATALOG NUMBER	LAMPS NO.	LAMPS WATTS	LAMPS TYPE	VOLTAGE	REMARKS
A	2x4 RECESSED LENSED FLUORESCENT TROFFER	LSI	3	32	F32TB/	277	
		LA125-332-SD-SSOR-LM735-UE			SPX41		
A1	2x4 RECESSED LENSED FLUORESCENT TROFFER	LSI	3	32	F32TB/	277	FIXTURE SHALL HAVE EMERGENCY POWER BATTERY PACK WITH 1200 LUMEN MINIMUM
		LA125-332-SD-SSOR-LM735-UE-EM			SPX41		
B	2x4 RECESSED PARABOLIC FLUORESCENT TROFFER	LSI	3	32	F32TB/	277	
		N2PG-12-332-FD-SSOR-LM735-UE			SPX41		
B1	2x4 RECESSED PARABOLIC FLUORESCENT TROFFER	LSI	3	32	F32TB/	277	FIXTURE SHALL HAVE EMERGENCY POWER BATTERY PACK WITH 1200 LUMEN MINIMUM
		N2PG-12-332-FD-SSOR-LM735-UE-EM			SPX41		
C	200 SERIES INDUSTRIAL STRIP	LSI	2	32	F32TB/	277	
		F-20-2-T8-32-SSOL-277			SPX41		
C1	200 SERIES INDUSTRIAL STRIP	LSI	2	32	F32TB/	277	FIXTURE SHALL HAVE EMERGENCY POWER BATTERY PACK WITH 1200 LUMEN MINIMUM
		F-20-2-T8-32-SSOL-277-EM			SPX41		
D	200 SERIES INDUSTRIAL STRIP	LSI	4	32	F32TB/	277	
		F-20-4-T8-32-SSOL-277			SPX41		
D1	200 SERIES INDUSTRIAL STRIP	LSI	4	32	F32TB/	277	FIXTURE SHALL HAVE EMERGENCY POWER BATTERY PACK WITH 1200 LUMEN MINIMUM
		F-20-4-T8-32-SSOL-277-EM			SPX41		
E	2x2 RECESSED LENSED FLUORESCENT TROFFER	LSI	2	32	F32TB/	277	
		2TG-A125-2U32-SD-SSOR-LM735-UE			SPX41/U/6		
F	RECESSED FLUORECENT 6" CAN LIGHT	LSI	1	32	F32TB/	277	
		206VCFL-132T-UNIV-C27/206VCL			SPX41		
G	1x4 RECESSED DIRECT/INDIRECT	LITHONIA	2	32	F32TB/	277	
		AV-G-2-32-MDR-ASY-MVOLT-GEB10RS			SPX41		
G1	1x4 RECESSED DIRECT/INDIRECT	LITHONIA	2	32	F32TB/	277	FIXTURE SHALL HAVE EMERGENCY POWER BATTERY PACK WITH 1200 LUMEN MINIMUM
		AV-G-2-32-MDR-ASY-MVOLT-GEB10RS-EL			SPX41		
H	WALL MOUNTED FLUORESCENT SCONCE	NESSEN	1	32	F32TB/	277	
		NW680SB			SPX41		
I	CEILING MOUNTED STEM DOWNLIGHT	VELA	1	50		277	
		220085MC					
K	WALL MOUNTED FLASHING LED	EDWARDS	–	–	LED	120	FIXTURE SHALL HAVE EMERGENCY POWER BATTERY PACK
		102LS-FLEDA-N5					
X	WALL MOUNTED LED EXIT SIGN	EXITRONIX	–	–	LED	277	FIXTURE SHALL HAVE EMERGENCY POWER BATTERY PACK
		400U/WB/BL/G1-A1-EM					
X1	CEILING MOUNTED LED EXIT SIGN	EXITRONIX	–	–	LED	277	FIXTURE SHALL HAVE EMERGENCY POWER BATTERY PACK
		400U/WB/BL/G1-A1-EM					

1 FIXTURE SCHEDULE
E-600 SCALE: NONE

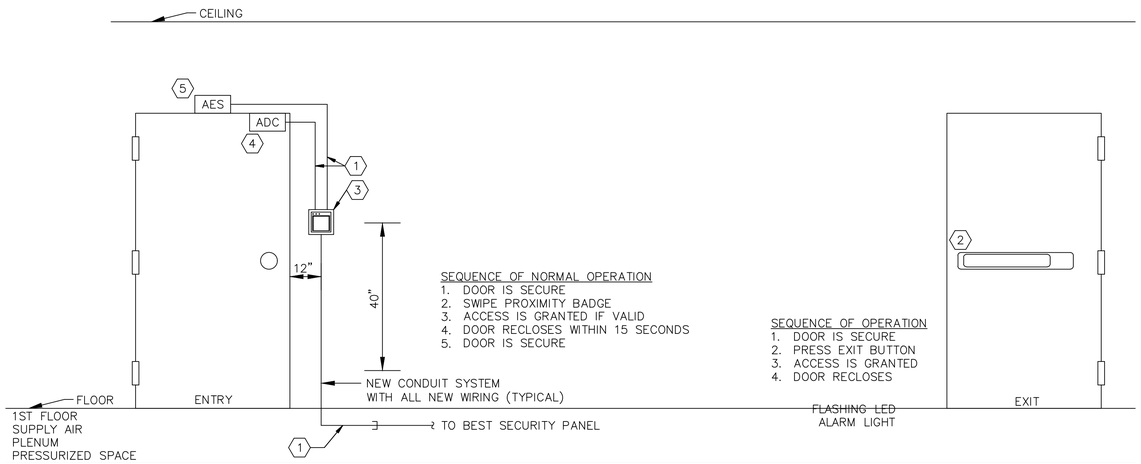

SECURITY KEYED NOTES:

1. INSTALL NEW BELDEN BANANA PEEL, PLENUM-RATED 4/C CABLE IN 3/4"C.
2. INSTALL NEW PANIC BAR DEVICE ON THE INSIDE OF THE DOOR.
3. INSTALL NEW ACCESS CONTROL PROXIMITY CARD READER DEVICE.
4. INSTALL NEW ACCESS CONTROL DOOR CONTACT.
5. INSTALL NEW ACCESS CONTROL ELECTRIC DOOR STRIKE.

2 DOORS – CARD READER ACCESS
E-600 SCALE: NONE

CONSTRUCTION NOTES:

1. THE SECURITY SYSTEM SHALL BE PROVIDED AND INSTALLED BY THE CONTRACTOR.
2. THE CONTRACTOR SHALL PROVIDE AND INSTALL 120V BRANCH CIRCUITS AND ALL CONDUIT AND BOXES TO SUPPORT THE SECURITY CABLING AND DEVICES FOR A COMPLETE INSTALLATION.

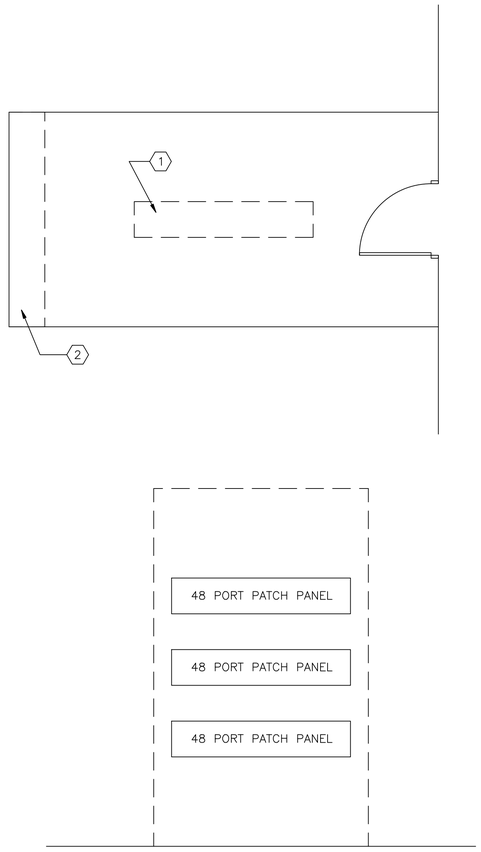

3 TELECOM ROOM F-107
E-600 SCALE: NONE

TELECOM KEYED NOTES:

1. INSTALL NEW 48 PORT PATCH PANELS.
2. INSTALL NEW TELECOM INPUT/OUTPUT BLOCKS.

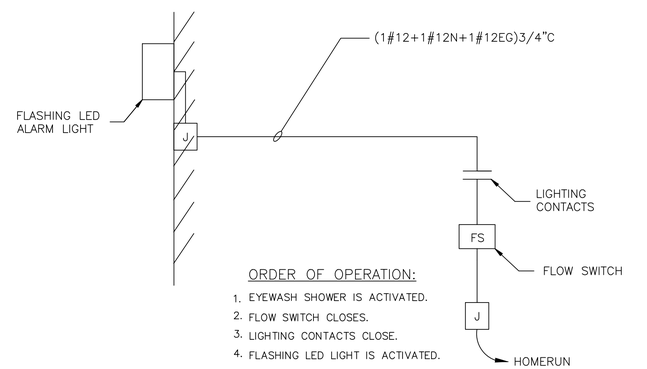

ORDER OF OPERATION:

1. EYEWASH SHOWER IS ACTIVATED.
2. FLOW SWITCH CLOSES.
3. LIGHTING CONTACTS CLOSE.
4. FLASHING LED LIGHT IS ACTIVATED.

4 EMERGENCY EYEWASH STATION ALARM LIGHT
E-600 SCALE: NONE

AIR EDUCATION & TRAINING COMMAND

LITTLE ROCK A.F.B.
ARKANSAS

GARVER | ENGINEERS
1010 BATTERY STREET
LITTLE ROCK, ARKANSAS 72202
www.garverengineers.com
(501) 376-3633

CROMWELL
ARCHITECTS ENGINEERS
101 SOUTH SPRING ST
LITTLE ROCK AR 72201
TELEPHONE 501-372-2900
FACSIMILE 501-372-0482

No.	Revision/Issue	Date	BY	APP'D

PROJECT TITLE
REPAIR & RENOVATE MEDICAL CLINIC PH IV
LITTLE ROCK AIR FORCE BASE
JACKSONVILLE, ARKANSAS
100% SUBMITTAL

SHEET TITLE
ELECTRICAL DETAILS I

DRAWN BY: MCL	LEAD DESIGNER: ECF
TECH REVIEWER: CAG	PROJECT NUMBER: NKAK#06-8006-4
DESIGNED BY:	SHEET: E-600
DATE: JULY 1, 2008	
SCALE: AS NOTED	49 OF