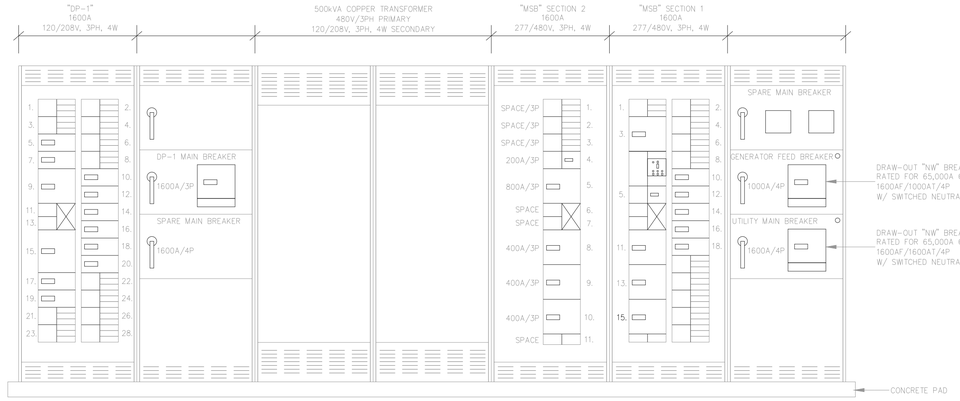

"DP-1"

1. SPACE/3P
2. SPACE/3P
3. SPACE/3P
4. SPACE/3P
5. 100A/3P-PANEL SB
6. SPACE/3P
7. 100A/3P-PANEL EE7
8. SPACE/3P
9. 800A/3P-PANEL DP-3
10. 125A/3P-PANEL L
11. SPACE/3P
12. 150A/3P-PANEL LN
13. SPACE/3P
14. 225A/3P-PANEL KP
15. 800A/3P-SWBD DP-4
16. 150A/3P-PANEL PD
17. 100A/3P-PANEL LP
18. 125A/3P-PANEL LSE3
19. 100A/3P-PANEL PANEL LT
20. 70A/3P-PANEL LR
21. SPACE
22. SPACE
23. SPACE
24. SPACE
25. DOES NOT EXIST
26. SPACE
27. DOES NOT EXIST
28. SPACE

"MSB" SECTION 2

1. SPACE/3P
2. SPACE/3P
3. SPACE/3P
4. PANEL DP-MECH
5. 500kVA TRANSFORMER
6. SPACE
7. SPACE
8. CHILLER 2
9. CHILLER 1
10. TEMP. CHILLER TAP BOX
11. SPACE

"MSB" SECTION 1

1. SPACE/3P
2. SPACE/3P
3. 800A/3P-PANEL DP-2
4. SPACE/3P
5. SURGE PROTECTION DEVICE
6. SPACE/3P
7. UNMARKED SPACE
8. SPACE/3P
9. UNMARKED SPACE
10. 40A/3P-AHU S2A
11. 400A/3P-PANEL MCC-A
12. 150A/3P-SPARE
13. 400A/3P-PANEL PEDP
14. 150A/3P SPARE
15. 300A/3P-PANEL X
16. 125A/3P-PANEL P2
17. UNMARKED SPACE
18. 100A/3P-PANEL HG
19. DOES NOT EXIST
20. UNMARKED SPACE
21. DOES NOT EXIST
22. UNMARKED SPACE
23. DOES NOT EXIST
24. UNMARKED SPACE
25. DOES NOT EXIST
26. UNMARKED SPACE
27. DOES NOT EXIST
28. UNMARKED SPACE

1 "MAIN SWITCHBOARD ELEVATION IN ROOM F147"
NOT TO SCALE

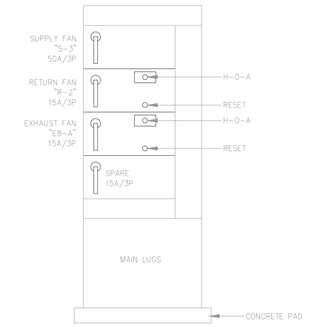

"MCC-C", 600V

2 "MCC-C" ELEVATION IN PENTHOUSE 2
NOT TO SCALE

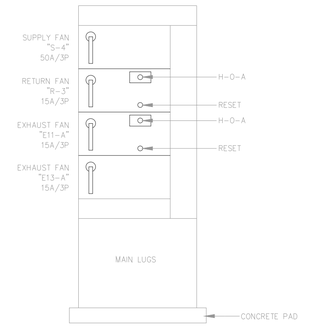

"MCC-D", 600V

3 "MCC-D" ELEVATION IN PENTHOUSE 3
NOT TO SCALE

NOTICE: THIS IS THE PERSONAL PROPERTY OF KROESCHELL ENGINEERING CO.
AND ALL USE IS FORBIDDEN EXCEPT UPON WRITTEN CONSENT.

CAD Filename: K\\Air Force Bases\Little Rock\11599	DATE REVISED
ORIGINAL P-No. 10796	
ADDITIONS AND REVISIONS	
65% DESIGN REVIEW	12/23/09
ISSUED FOR 100% SUBMITTAL	4/9/10
AS-BUILTS	10/4/10

DRAWN BY	JP
CHECKED BY	RPK
APPROVED BY	WAM
SCALE	NONE
DATE	NOV. 2009

JOB No.

Sheet No.

AS-BUILTS 10/4/10