GENERAL NOTES:

1. HEAVY TONE LINEWORK AND TEXT DENOTE NEW WORK. LIGHT TONE LINEWORK AND TEXT DENOTES EXISTING CONDITIONS TO REMAIN.
2. REFER TO SHEET E-1 FOR SYMBOL LIST, ABBREVIATIONS AND GENERAL NOTES.
3. REFER TO SHEETS E4-1 & E4-2 FOR RISER DIAGRAMS.
4. REFER TO SHEET E6-2 FOR "MCC-C" & "MCC-D" ELEVATIONS.

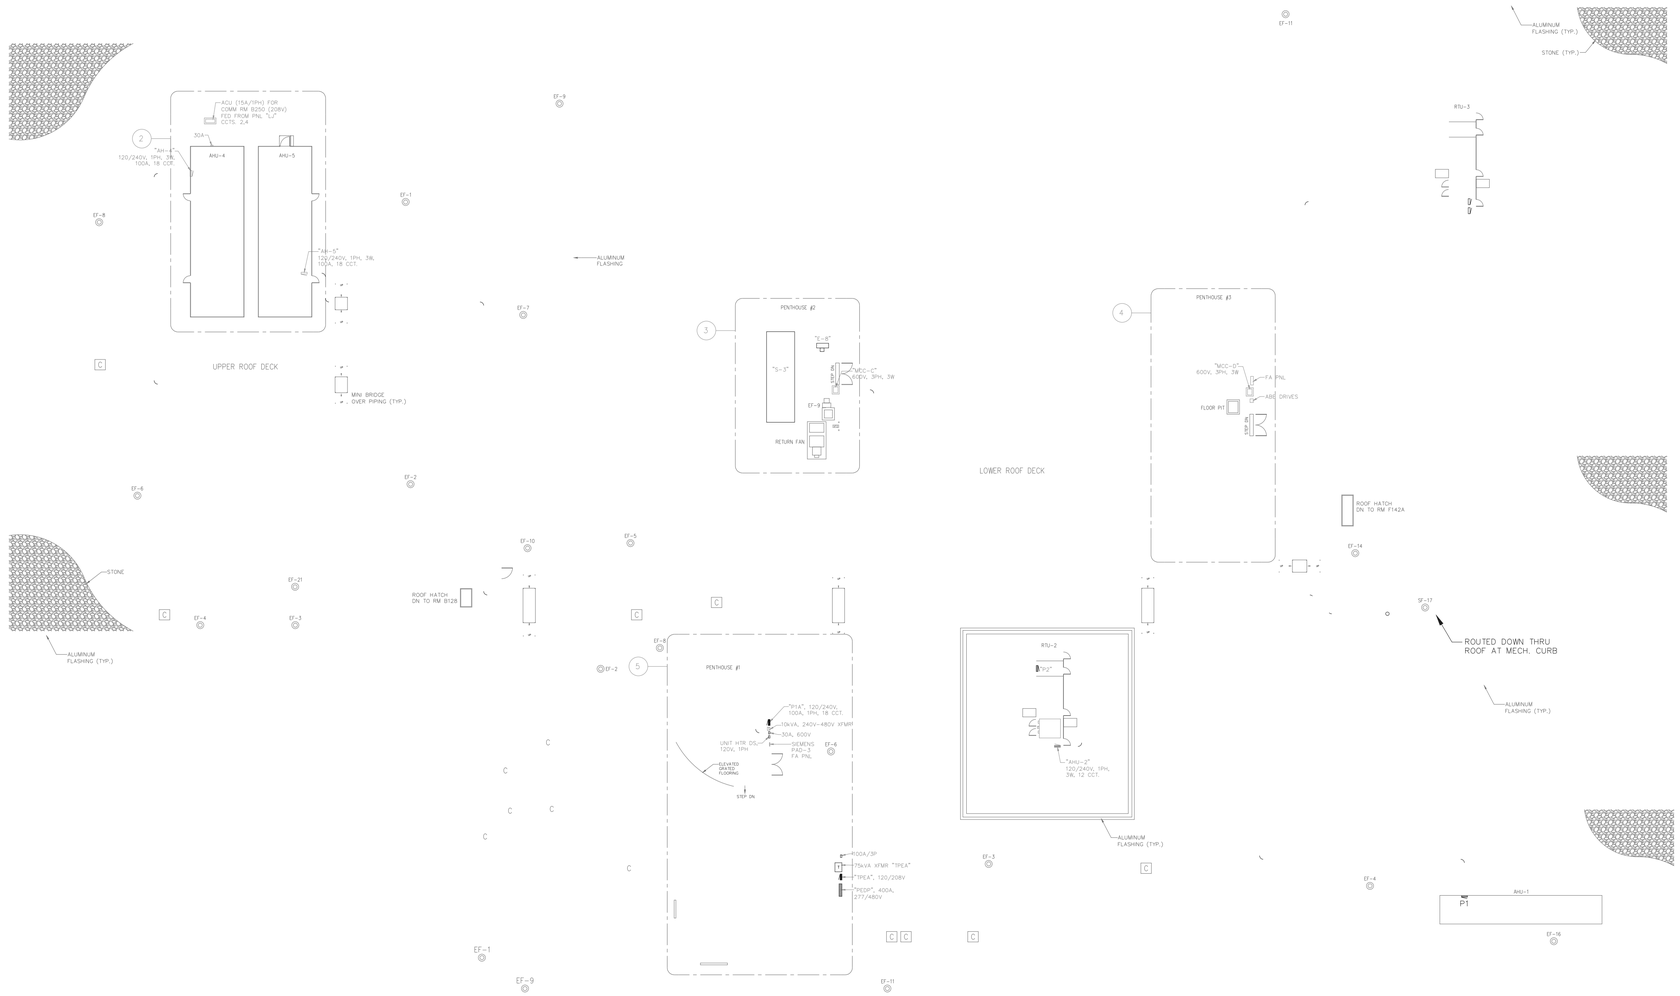

1 ROOF ELECTRICAL PLAN
SCALE: 1/16" = 1'-0"

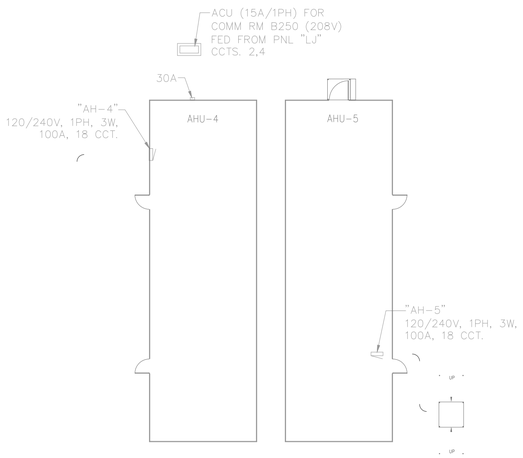

2 AHU-4 & AHU-5 ELECTRICAL PLAN
SCALE: 1/8" = 1'-0"

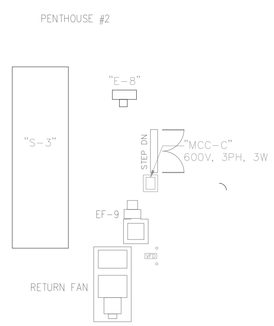

3 PENTHOUSE 2 ELECTRICAL PLAN
SCALE: 1/8" = 1'-0"

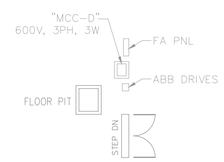

4 PENTHOUSE 3 ELECTRICAL PLAN
SCALE: 1/8" = 1'-0"

5 PENTHOUSE 1 ELECTRICAL PLAN
SCALE: 1/8" = 1'-0"

NORTH

NOTICE: THIS IS THE PERSONAL PROPERTY OF KROESCHELL ENGINEERING CO. AND ALL USE IS FORBIDDEN EXCEPT UPON WRITTEN CONSENT.

CAD Filename. K:\\Air Force Bases\Little Rock\11599	DATE REVISED
ORIGINAL P-No. 10796	
ADDITIONS AND REVISIONS	
65% DESIGN REVIEW	12/23/09
ISSUED FOR 100% SUBMITTAL	4/9/10
AS-BUILTS	10/4/10

DRAWN BY	JP	JOB No.	Sheet No.
CHECKED BY	RPK		
APPROVED BY	WAM		
SCALE	1/16" = 1'-0"		
DATE	NOV 2009		

AS-BUILTS 10/4/10