KEYED NOTES

1. INSTALL NEW CABLE TRAY SYSTEM.
2. INSTALL NEW PROJECTOR AND INSTALL TWO NEW CAT 6 DATA CABLES BACK TO SOURCE COMPUTER.
3. INSTALL NEW ELECTRIC DOOR STRIKE, DOOR CONTACT, AND PANIC EGRESS BAR (DISABLES DOOR STRIKE POWER).
4. INSTALL NEW SWITCH TO CONTROL THE PROJECTOR SCREEN.
5. INSTALL NEW CEILING MOUNTED MICROPHONE DEVICE. (TYPICAL). INSTALL MICROPHONE WIRING BACK TO SOURCE COMPUTER LOCATION. EXTEND AND RECONNECT TO EXISTING MICROPHONE CIRCUIT.
6. INSTALL SPEAKER WIRING BACK TO SOURCE COMPUTER LOCATION. EXTEND AND RECONNECT NEW SPEAKER DEVICES TO EXISTING SPEAKER CIRCUIT.
7. EACH OFFICE HAS A MINIMUM OF FOUR (4) COMMUNICATION CABLES THAT ARE SERIES CONNECTED TO EACH OF THE TELECOMM OUTLETS IN EACH ROOM.

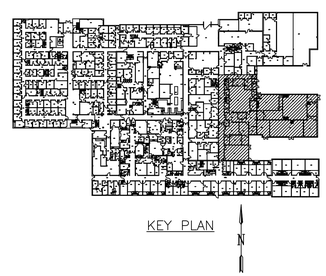

LITTLE ROCK A.F.B.
ARKANSAS

GARVER|ENGINEERS
1010 BATTERY STREET
LITTLE ROCK, ARKANSAS 72202
www.garverengineers.com
(501) 376-3633

CROMWELL
ARCHITECTS ENGINEERS
101 SOUTH SPRING ST
LITTLE ROCK AR 72201
TELEPHONE 501-372-2900
FACSIMILE 501-372-0482

No.	Revision/Issue	Date	BY	APP'D

PROJECT TITLE
REPAIR & RENOVATE MEDICAL CLINIC PH IV
LITTLE ROCK AIR FORCE BASE
JACKSONVILLE, ARKANSAS
100% SUBMITTAL

SHEET TITLE
ELECTRICAL FIRE ALARM/
COMM INSTALL PLAN AREA "B"

DRAWN BY: CAG
TECH REVIEWER:
DESIGNED BY:
DATE: JULY 1, 2008
SCALE: AS NOTED

LEAD DESIGNER: ECF
PROJECT NUMBER: NKAK#06-8006-4
SHEET: E-401
47 OF