SYMBOL LEGEND

208V EQUIPMENT, WIRING & TEXT

480V EQUIPMENT, WIRING & TEXT

GENERAL NOTES:

1. REFER TO SHEET E-1 FOR ELECTRICAL SPECS, AIR FORCE STANDARDS, SYMBOL LIST AND ABBREVIATIONS.
2. REFER TO SHEETS E5-1 THRU E5-8 FOR PANELBOARD SCHEDULES.

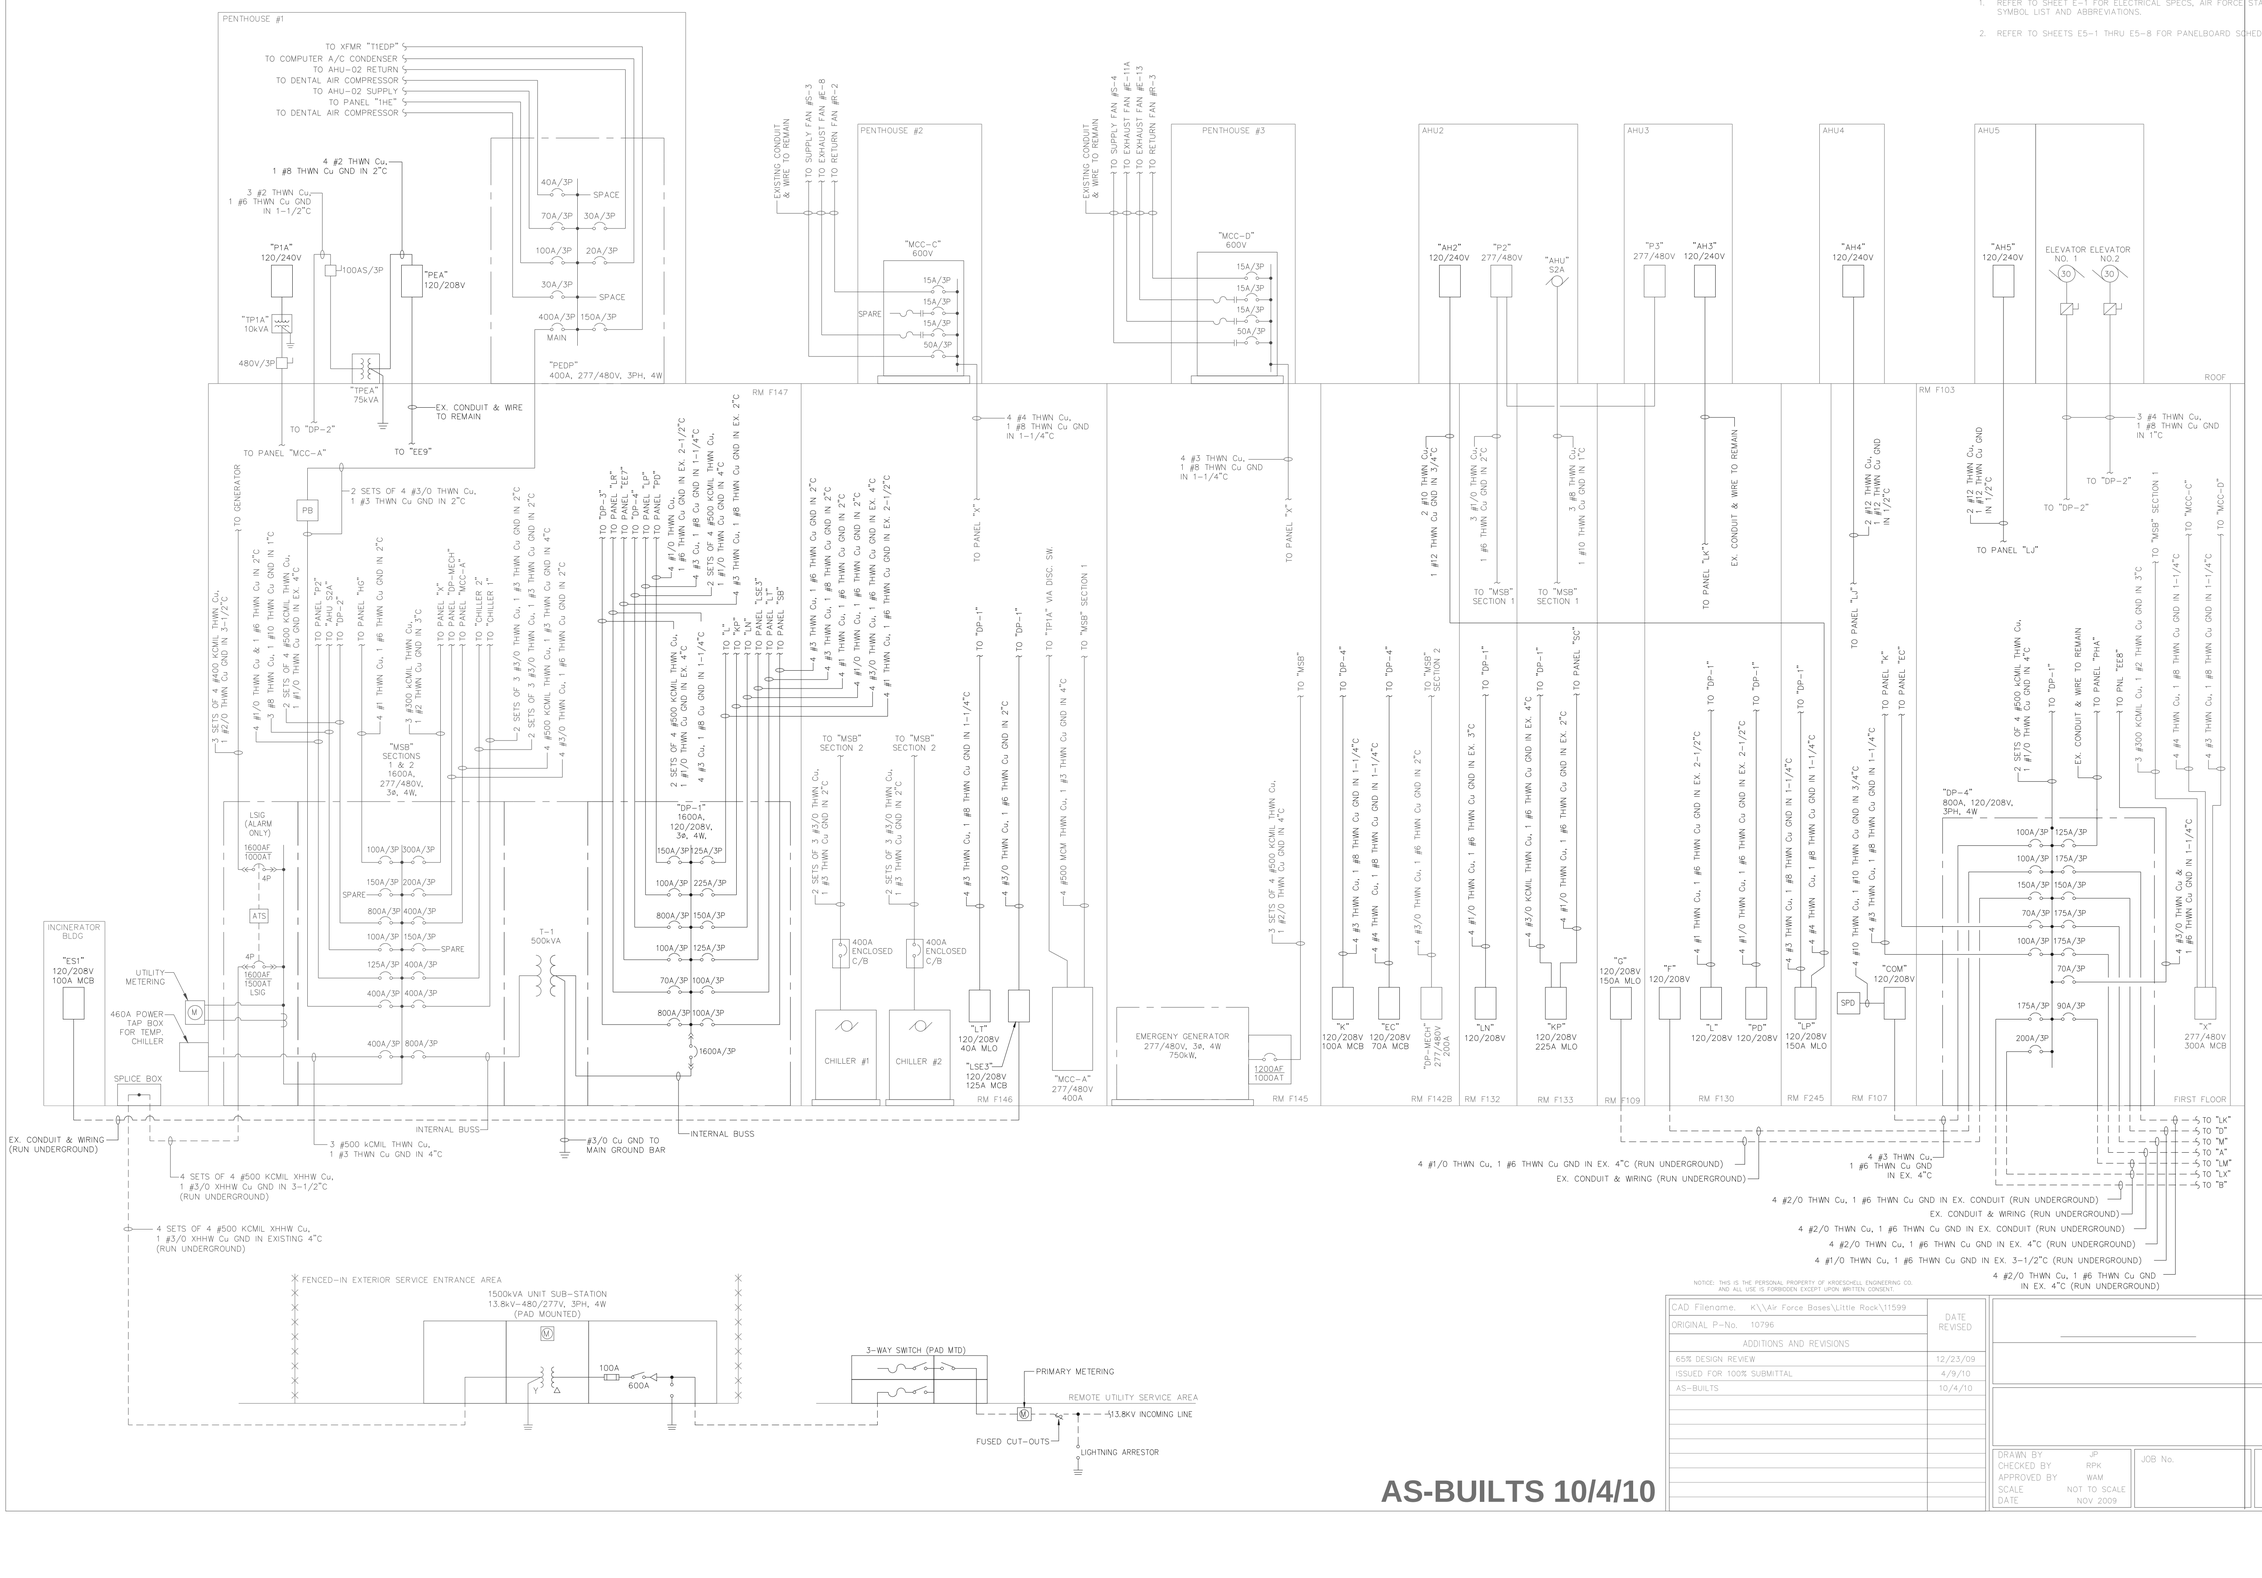


REFER TO SHEET E4-2 FOR CONTINUATION

NOTICE: THIS IS THE PERSONAL PROPERTY OF KROESCHELL ENGINEERING CO. AND ALL USE IS FORBIDDEN EXCEPT UPON WRITTEN CONSENT.

| CAD Filename: K:\\Air Force Bases\Little Rock\11599 | DATE REVISED |
|---|---|
| ORIGINAL P-No. 10796 | |
| ADDITIONS AND REVISIONS | |
| 65% DESIGN REVIEW | 12/23/09 |
| ISSUED FOR 100% SUBMITTAL | 4/9/10 |
| AS-BUILTS | 10/4/10 |

| | |
|---|---|
| DRAWN BY | JP |
| CHECKED BY | RPK |
| APPROVED BY | WAM |
| SCALE | NOT TO SCALE |
| DATE | NOV 2009 |

JOB No.

Sheet No.

**AS-BUILTS 10/4/10**