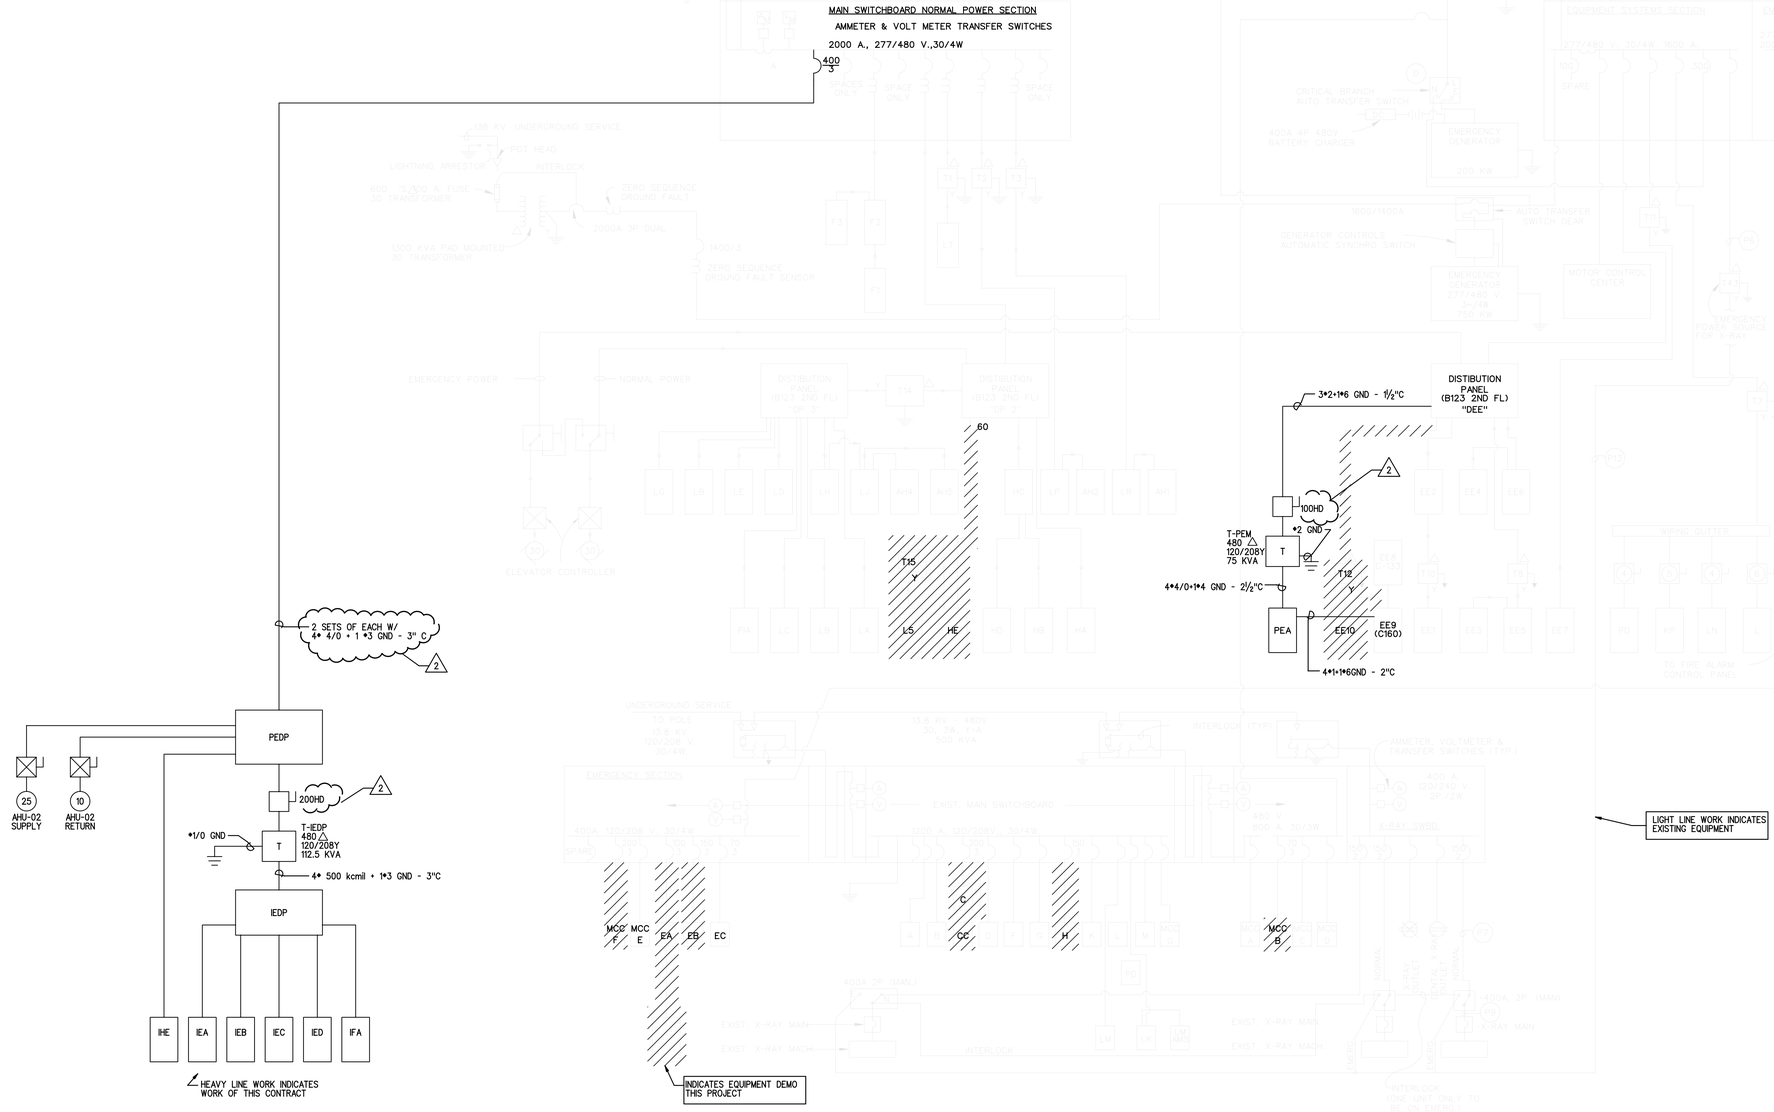


US Army Corps of Engineers
Huntsville
Alabama

| DATE | APPROVED | SYMBOL | AMENDMENT DESCRIPTION |
|---|---|---|---|
| 8/01/2005 | | | REVISIONS AS-BUILT |
| 10/31/2003 | | | ISSUED FOR FINAL WORK PLAN |
| 10/14/2003 | | | ADDENDUM 1 |
| 10/1/2003 | | | ISSUED FOR BID |

| | |
|---|---|
| DESIGNED BY: | DATE: 09/04/2003 |
| DRAWN BY: | PROJECT NO. 61503 |
| CHECKED BY: | DRAWING CODE: |
| REVIEWED BY: | SOLICITATION NUMBER: |

U.S. ARMY ENGINEERING AND SUPPORT CENTER
CORPS OF ENGINEERS
HUNTSVILLE, ALABAMA

H&M Design

EARTH TECH
2101 Airport Dr. - Ste 300 - N. Little Rock, AR 72114 - (501) 812-2000

RENOVATE CLINIC
BUILDING 1090
LITTLE ROCK AFB, ARKANSAS

# SINGLE LINE DIAGRAM
# AS-BUILT

SHEET REFERENCE NUMBER:
**E2.01**
SHEET X OF XX