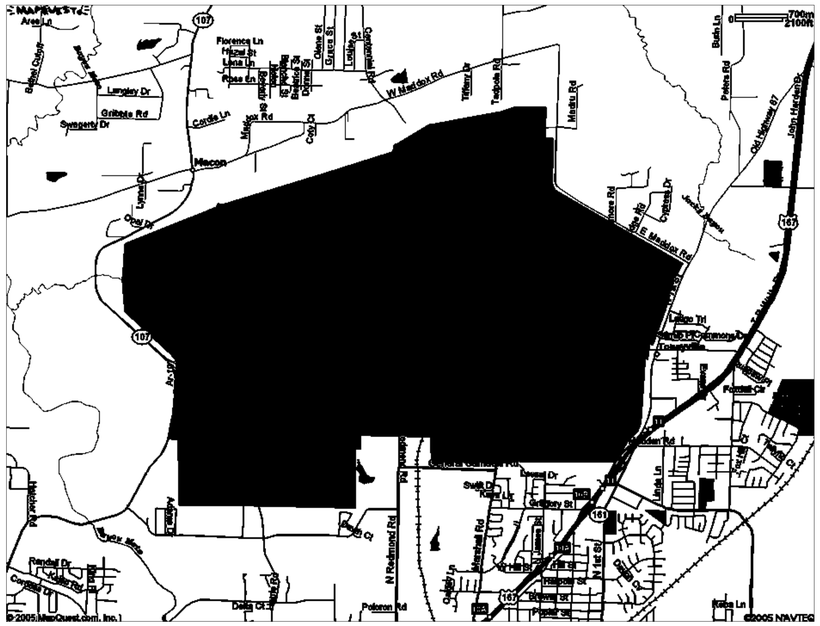

1 LOCATION MAP

NOT TO SCALE

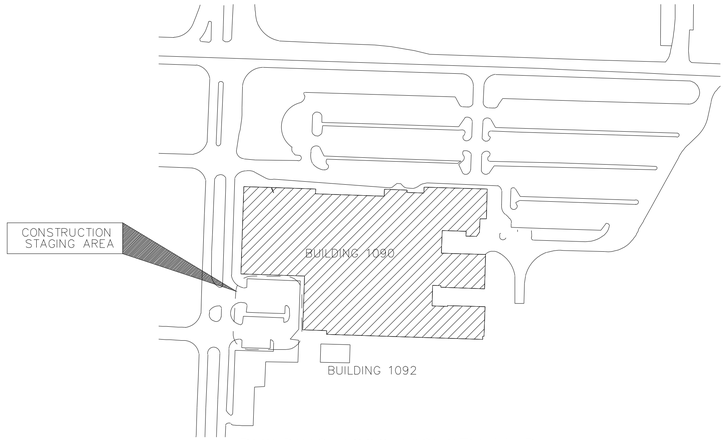

2 BUILDING 1090 VICINITY MAP

NOT TO SCALE

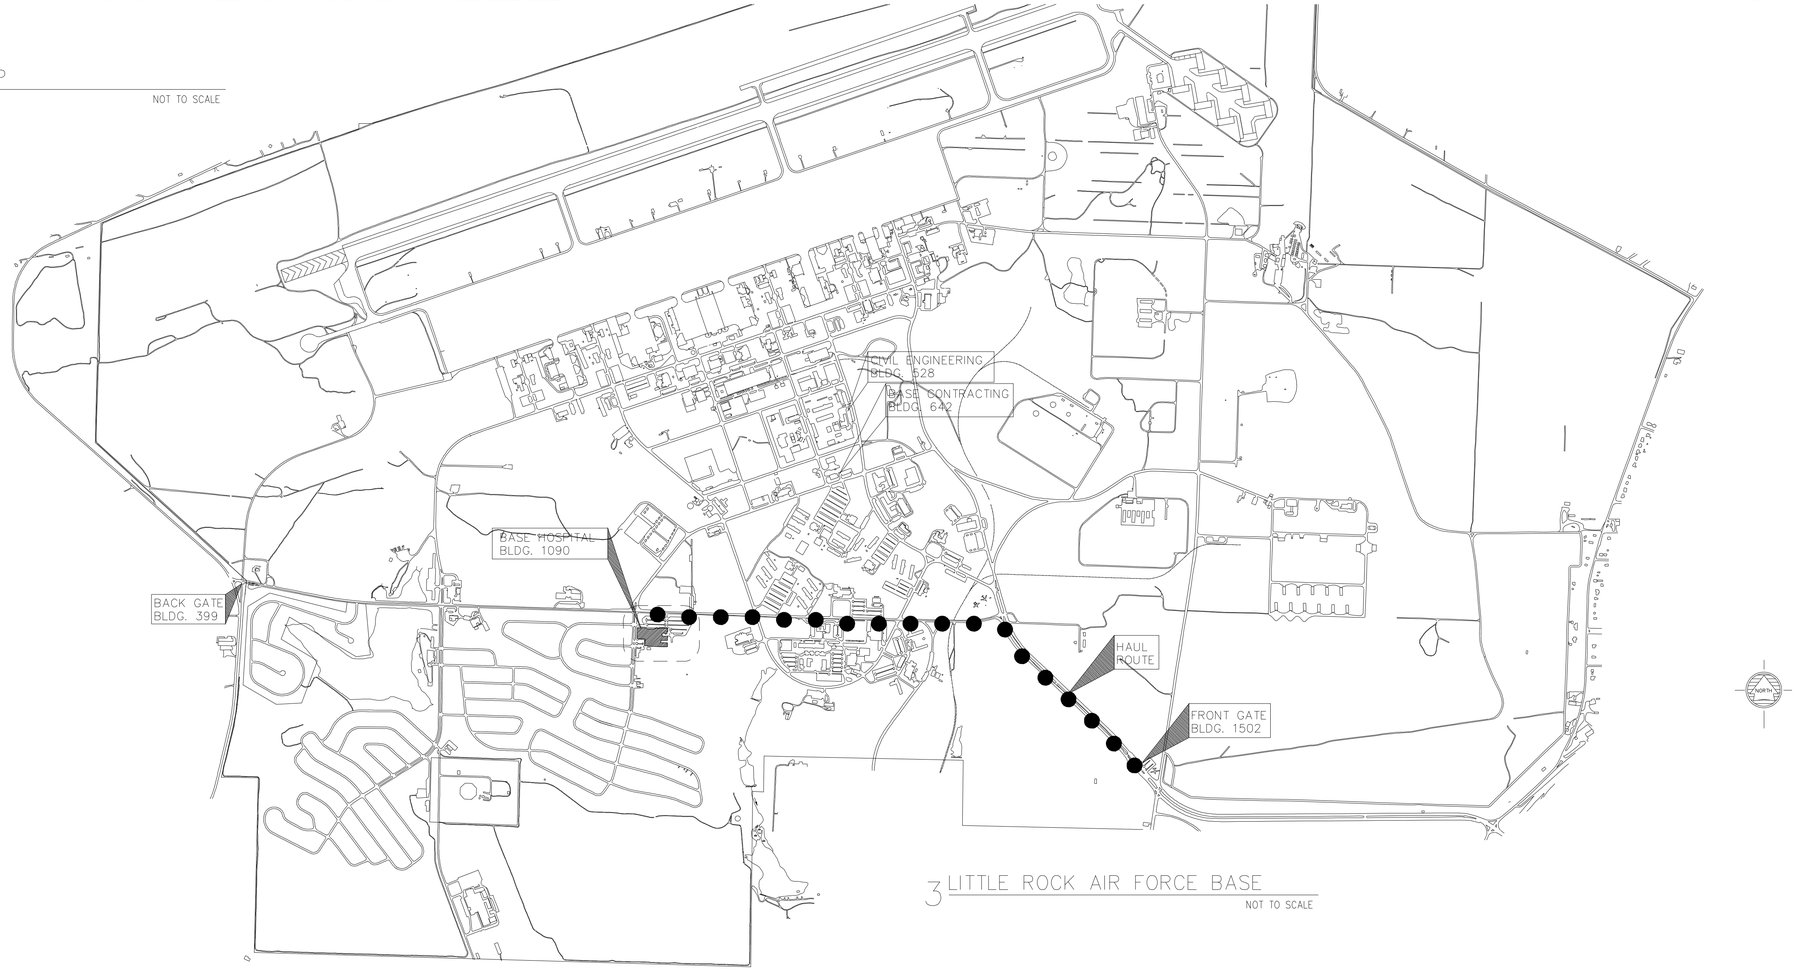

3 LITTLE ROCK AIR FORCE BASE

NOT TO SCALE

AIR EDUCATION & TRAINING COMMAND

LITTLE ROCK A.F.B.
ARKANSAS

FPM

804 West Curtis Drive, Suite H
Midwest City, OK 73110
phone: 405.869.9212
fax: 405.869.9222
www.fpm-group.com

RECORD DRAWINGS MARCH 2007

No.	Revision/Issue	Date	BY	APP'D

PROJECT TITLE
REPAIR MEDICAL CENTER PH B
LITTLE ROCK AFB, ARKANSAS

SHEET TITLE
PROJECT LOCATION PLAN

DRAWN BY R.J.R.	LEAD DESIGNER A.M.
TECH REVIEWER A.M.	PROJECT NUMBER NKAK 05-8004A
DESIGNED BY A.M.	SHEET G0.00
DATE 1-21-08	
SCALE	2 OF 39