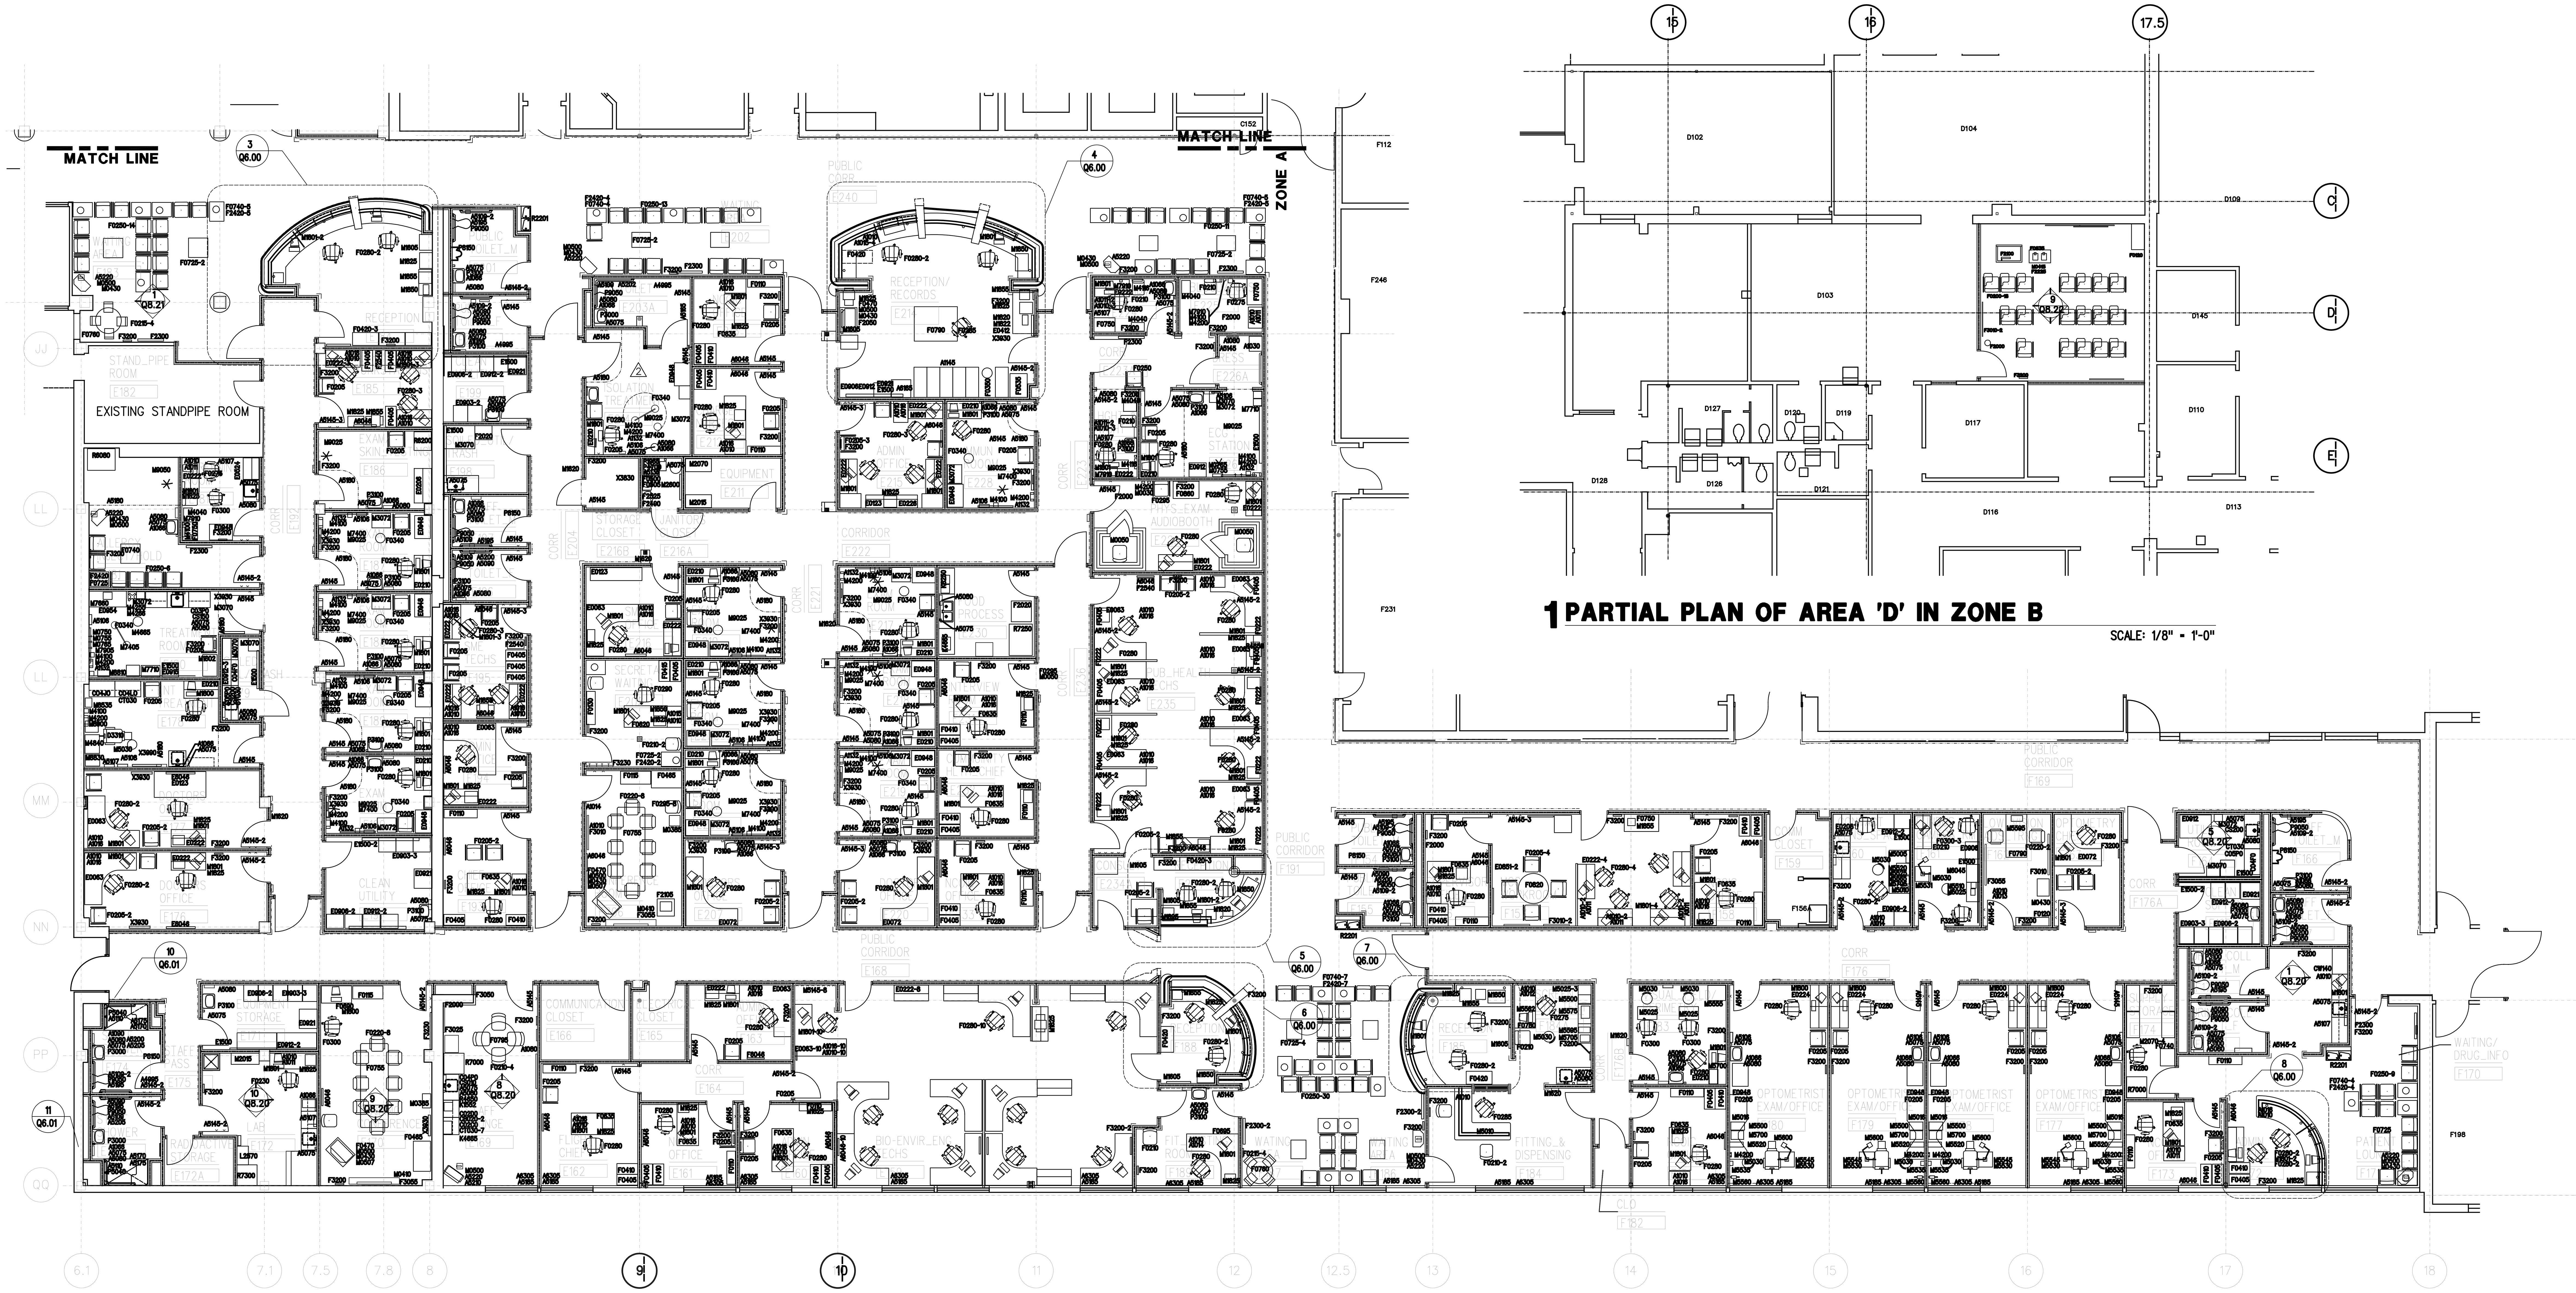

1 PARTIAL PLAN OF AREA 'D' IN ZONE B

SCALE: 1/8" = 1'-0"

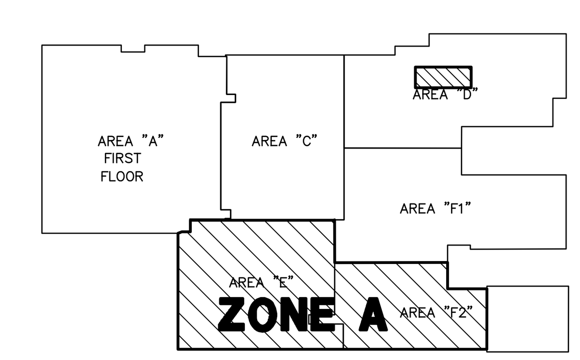

KEYPLAN

N.T.S.

SCALE

US Army Corps of Engineers Huntsville Alabama

SYMBOL	AMENDMENT DESCRIPTION	DATE	APPROVED
3	REVISIONS AS-BUILT	8/01/2005	
2	SD-5	9/27/2004	
1	ISSUED FOR BID	10/01/2003	

DESIGNED BY: - | DATE: 10/10/2003
DRAWN BY: - | PROJECT NO.: 61503
CHECKED BY: - | DRAWING CODE: -
REVIEWED BY: - | SOLICITATION NUMBER: -

U.S. ARMY ENGINEERING AND SUPPORT CENTER
CORPS OF ENGINEERS
HUNTSVILLE, ALABAMA

EARTH TECH
3121 Butterfield Rd. – Oak Brook, IL 60523 – (603) 574-2006

HLM Design

RENOVATE CLINIC
BUILDING 1090
LITTLE ROCK AFB, ARKANSAS

FURNITURE PLAN ZONE A
N.I.C. INFORMATION ONLY
AS-BUILT

SHEET REFERENCE NUMBER:

F1.11

SHEET X OF XX

prf
no pen table
dgn
$date$

$$PRF$$ $$DGN$$ $$DATE$$