ARCHITECTURAL SYMBOLS

NORTH REFERENCE

5 NORTH EAST SOUTH WEST
TITLE
1/8"=1'-0"

INTERIOR ELEVATION

5 — DETAIL NUMBER
5.02 — SHEET DETAIL IS DRAWN ON

DETAIL REFERENCE (ON PLAN)

5 TITLE
1/8"=1'-0"

DETAIL, SECTION OR ELEVATION

5 — SECTION NUMBER
5.12 — SHEET SECTION IS DRAWN ON

SECTION REFERENCE (ON PLAN)

DARKEN POINTS TO INDICATE WHICH ELEVATIONS ARE ACTUALLY DRAWN
6 — ELEVATION NUMBER
7.05 — SHEET ELEVATION IS DRAWN ON

ELEVATION REFERENCE (ON PLAN)

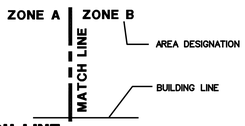

MATCH LINE

F.7 — GRIDS FOR EXISTING CONSTRUCTION

STRUCTURAL GRIDS

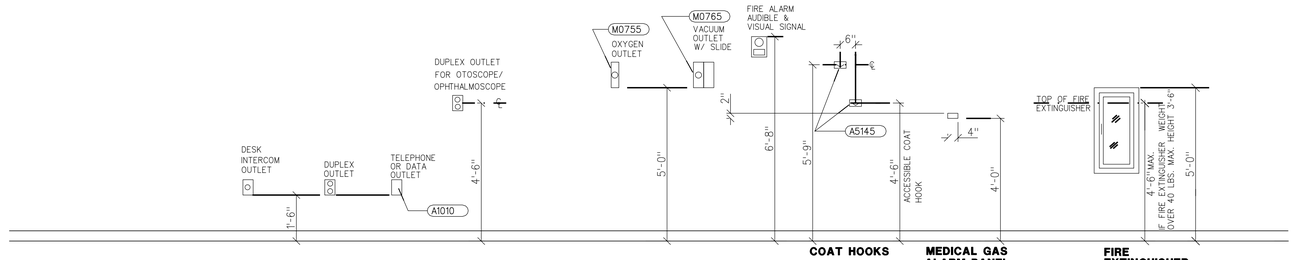

COAT HOOKS — MEDICAL GAS ALARM PANEL — FIRE EXTINGUISHER CABINET

GENERAL NOTES

1. THE HEIGHTS SHOWN ON THESE DRAWINGS ARE TYPICAL AND DO NOT NECESSARILY SHOW ALL THE DEVICES THAT ARE LOCATED ON THE WALLS.
2. THE OBJECT OF THESE ELEVATIONS IS TO ESTABLISH GUIDELINES FOR THE VERTICAL LOCATION OF WALL MOUNTED DEVICES GENERALLY THROUGHOUT THE PROJECT.
3. SEE ENLARGED TOILET PLANS Q6.01 FOR ADDITIONAL TOILET ACCESSORIES AND ACTUAL ROOM DIMENSIONS.
4. SEE EQUIPMENT SCHEDULE Q4.00 AND Q4.01 FOR EQUIPMENT INFORMATION

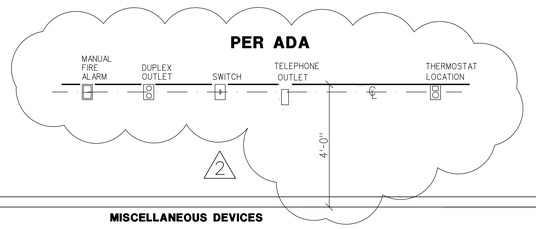

MISCELLANEOUS DEVICES

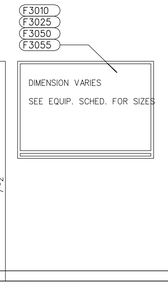

CHALKBOARD, TACKBOARD OR DRY MARKER BOARD

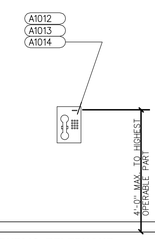

PUBLIC TELEPHONE

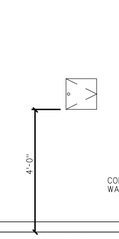

CLOCK — SPECIMEN PASS THRU CABINET

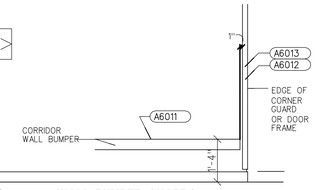

WALL BUMPER GUARDS

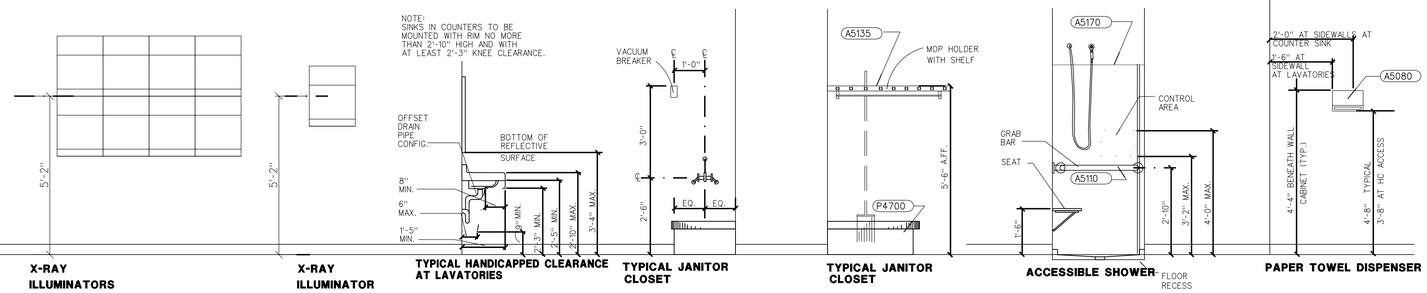

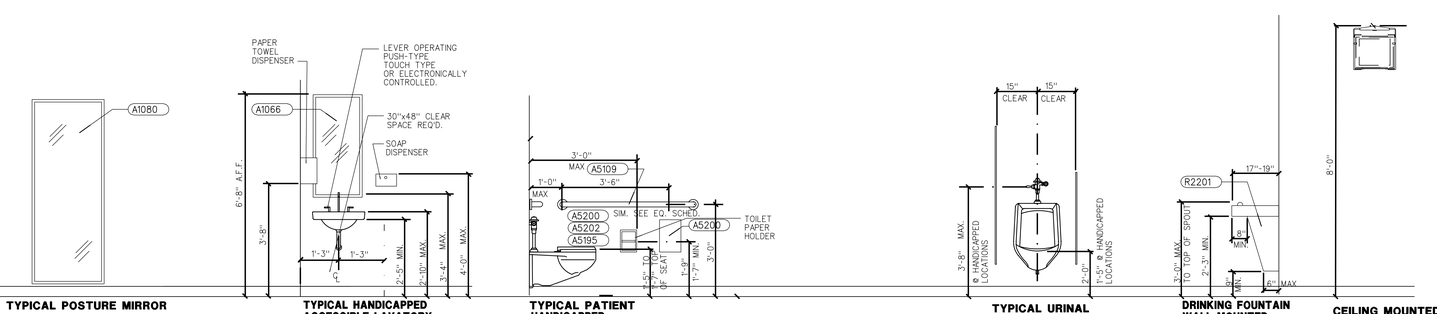

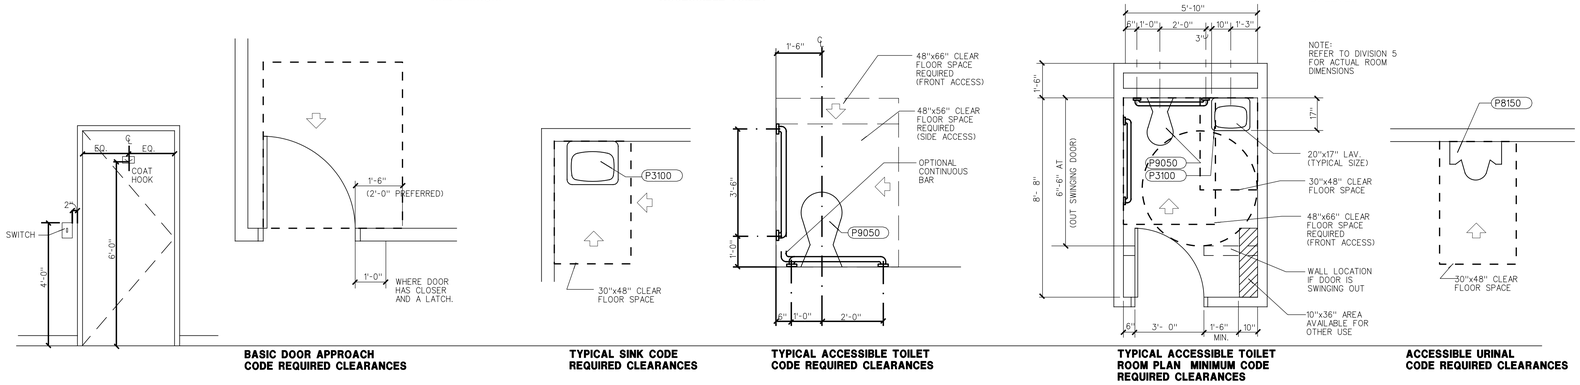

US Army Corps of Engineers
Huntsville
Alabama

SYMBOL	AMENDMENT DESCRIPTION	APPROVED	DATE APPROVED
1	REVISIONS AS-BUILT	8/01/2005	
0	ISSUED FOR BID	10/01/2003	

DESIGNED BY: -
DRAWN BY: -
CHECKED BY: -
REVIEWED BY: -
DATE: 10/10/2003
PROJECT NO.: 61503
DRAWING CODE: -
SOLICITATION NUMBER: -

U.S. ARMY ENGINEERING AND SUPPORT CENTER
CORPS OF ENGINEERS
HUNTSVILLE, ALABAMA

HLM Design
EARTH TECH
315 Wynfield Rd. • Little Rock, AR 72227 • (501) 374-4388

RENOVATE CLINIC
BUILDING 1090
LITTLE ROCK AFB, ARKANSAS

TYPICAL MOUNTING HEIGHTS AS-BUILT

SHEET REFERENCE NUMBER:
Q0.00
SHEET X OF XX

orf
no pen table
$date$
$plots$