DRAWING OF WORK AS-BUILT

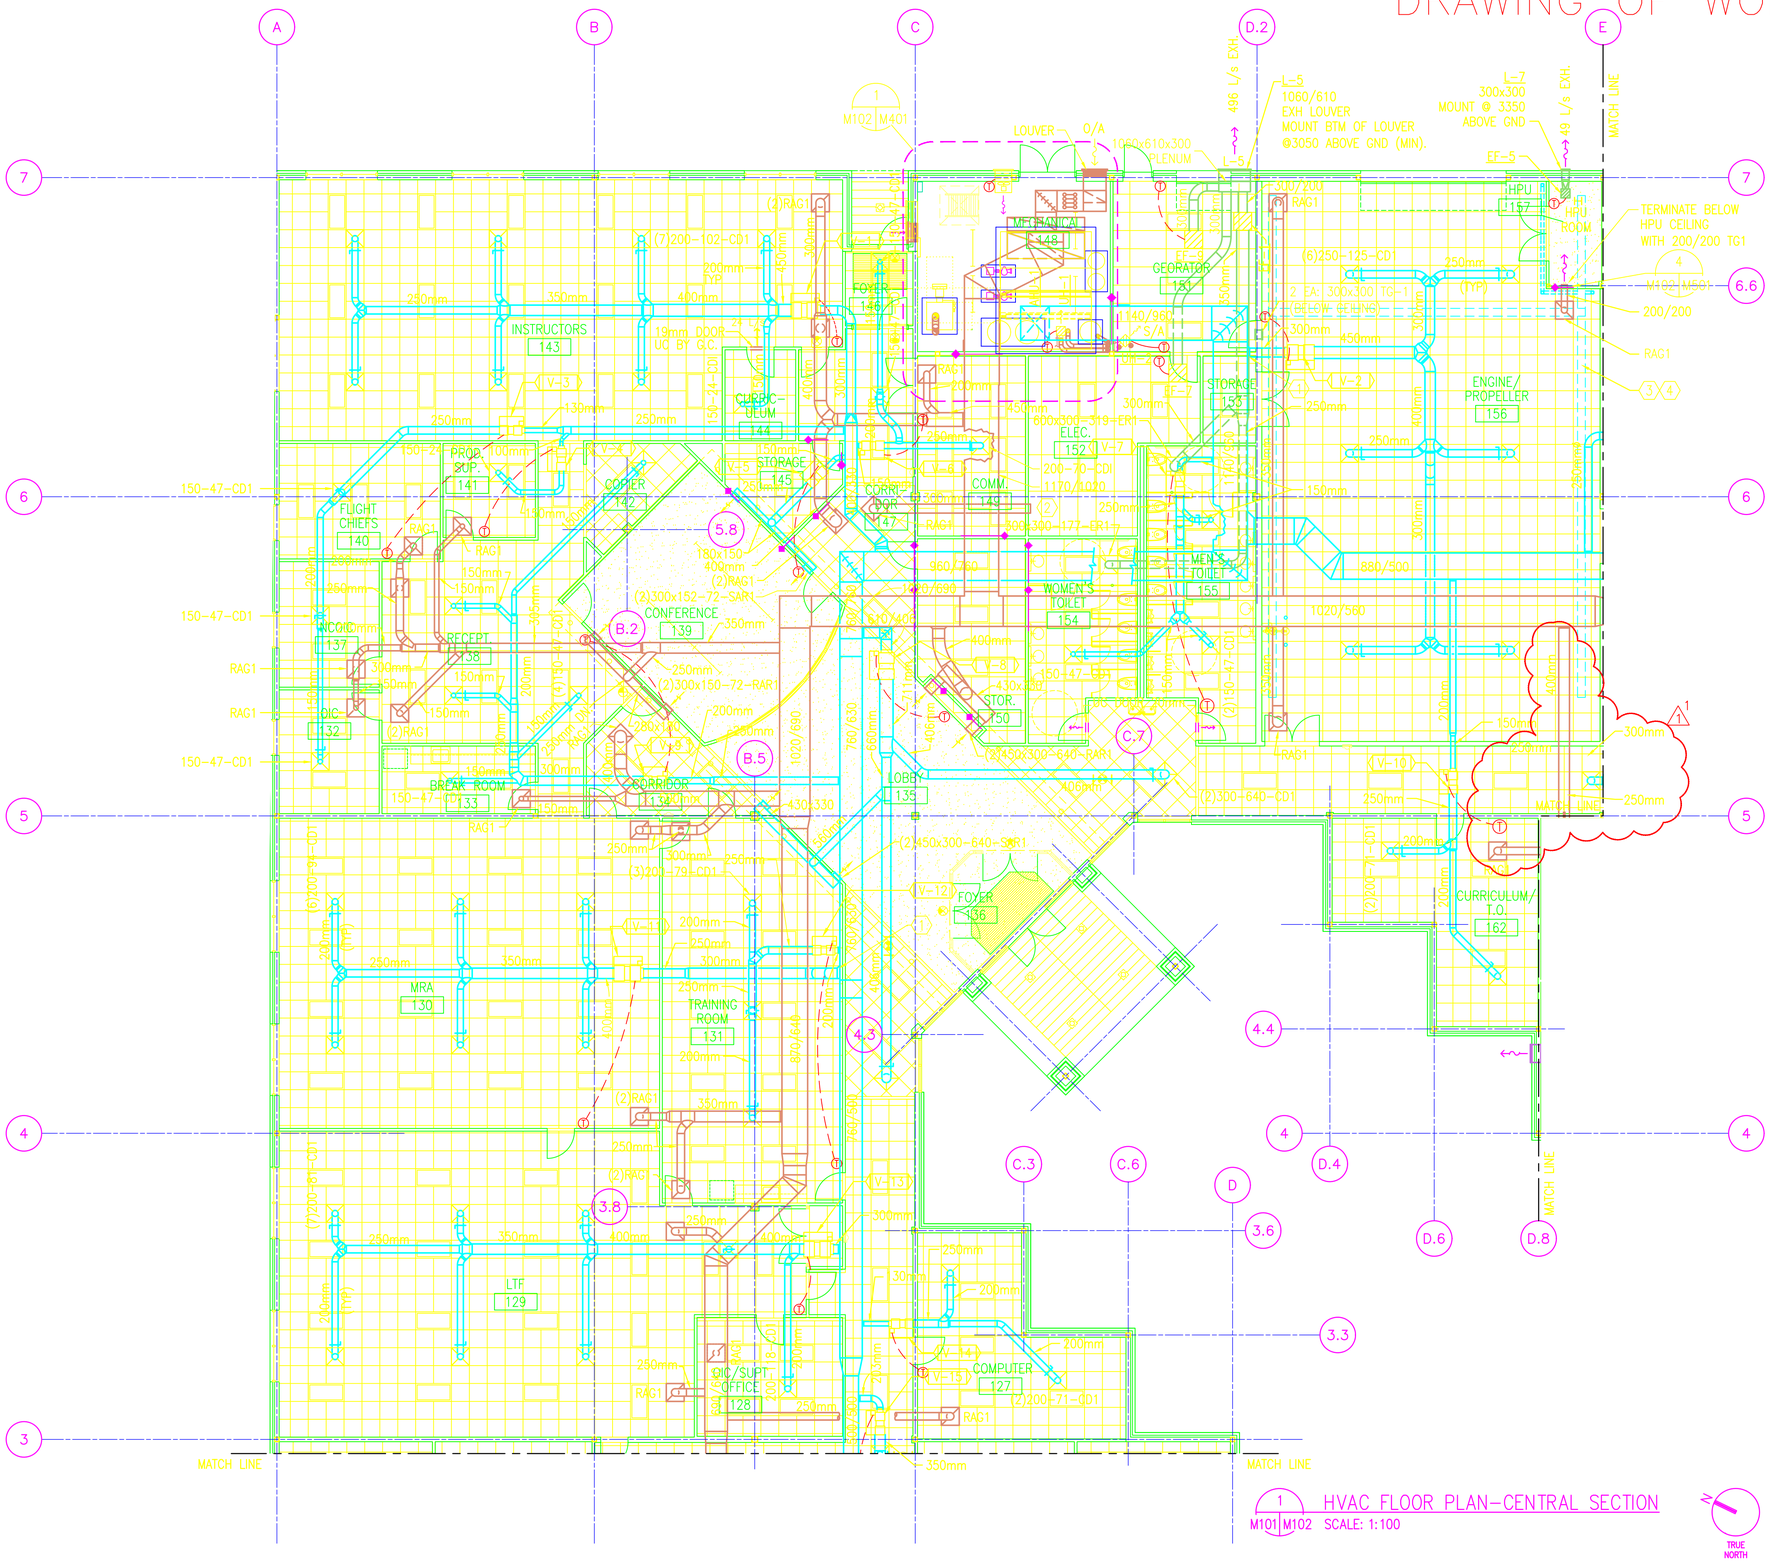

KEYNOTES:

1. TYPICAL – PROVIDE DUCT TAP PER DTL. 10/M501 OR PROVIDE BELLMOUTH FITTING ONE SIZE LARGER THAN DUCT RUNOUT.
2. TERMINATE 300mm TRANSFER DUCT INSIDE ELECTRICAL ROOM. PROVIDE FD AT WALL PENETRATION AND LEAVE DUCT END OPEN FOR FD ACCESS.
3. CRANE ASSEMBLY–REFER SPECIFICATION SECTION 14630. CRANE TO BE DESIGNED AND INSTALLED BY CONTRACTOR.
4. COORDINATE DUCTWORK LAYOUT WITH OVERHEAD CRANE ASSEMBLY.

GENERAL NOTES:

1. DUCTWORK SHALL BE EXTERNALLY INSULATED PER SPECIFICATION SECTION 15080.
2. CONTRACTOR SHALL PROVIDE SEISMIC BRACING FOR EQUIPMENT AND PIPING PER SPECIFICATION SECTION 15070.

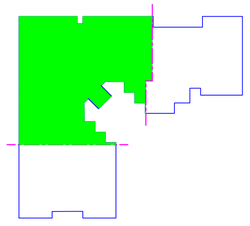

KEY PLAN

GRAPHIC SCALE:

0 1000 2000 4000

SCALE: 1:100

1 HVAC FLOOR PLAN–CENTRAL SECTION

M101 M102 SCALE: 1:100

TRUE NORTH

PLAN NORTH

U.S. ARMY CORPS OF ENGINEERS LITTLE ROCK DISTRICT

Mark	MOD. #	Description	Date	App.	Mark	Description	Date	App.
			04/09/04	PWD				

Designed by: CG
Reviewed by: TEK
Drawn by: MB
Dwg. Code:
Contract Date:
File Name: 193003M-102
Plot date: 06/06/03
Plot scale: 1:1
Contract No.: DACW03-01-D-0005
Submitted by: Atkins Benham, Inc.
Solicitation No.:

DEPARTMENT OF THE ARMY
U.S. ARMY CORPS OF ENGINEERS
LITTLE ROCK DISTRICT
LITTLE ROCK, ARKANSAS

Atkins Benham
(918) 492-1500 www.atkinsbenham.com
a member of the WS Atkins group of companies
WS Atkins

C-130J MAINTENANCE TRAINING FACILITY
LEAVEB, LITTLE ROCK AR.
Project No. NKAK 04-3004

HVAC FLOOR PLAN – CENTRAL SECTION

Sheet Reference Number:
M-102.1

Sheet 115 of 187

Drawing: P:\USTAH\FAC\50319300\20_CAD\M\193003M-1021 Saved: 04/07/2004 09:09 By: mb DimScale: 1.00 (TM=0)
XRefs: 193003A-FP01.DWG 193003S-CP01.DWG 193003G-BS001.DWG 193003M-HP01.DWG 193003A-CP01.DWG 193003M-EQ01.DWG 193003M-HP02.DWG 193003M-EQ02.DWG