Drawing: F:\2402151001 LRAFB C130J FUSELAGE TRAINER\20_CAD\C\151001C-404 Saved: 03/21/2003 11:38 By: BEAG2753 DimScale: 1.00 (TM=0)
XRefs: 151001G-BS001.DWG 151001C-DT05.DWG

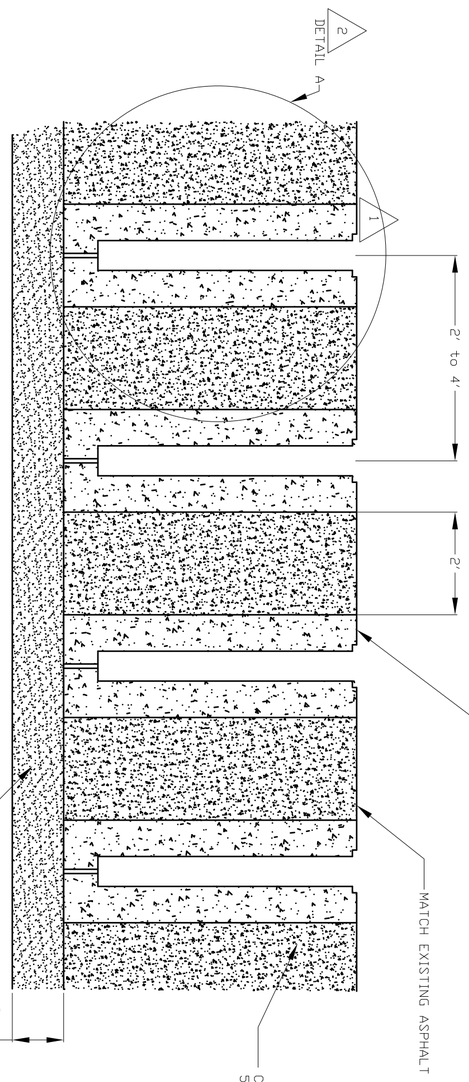

TRENCH DETAIL
SCALE: 1"=2'

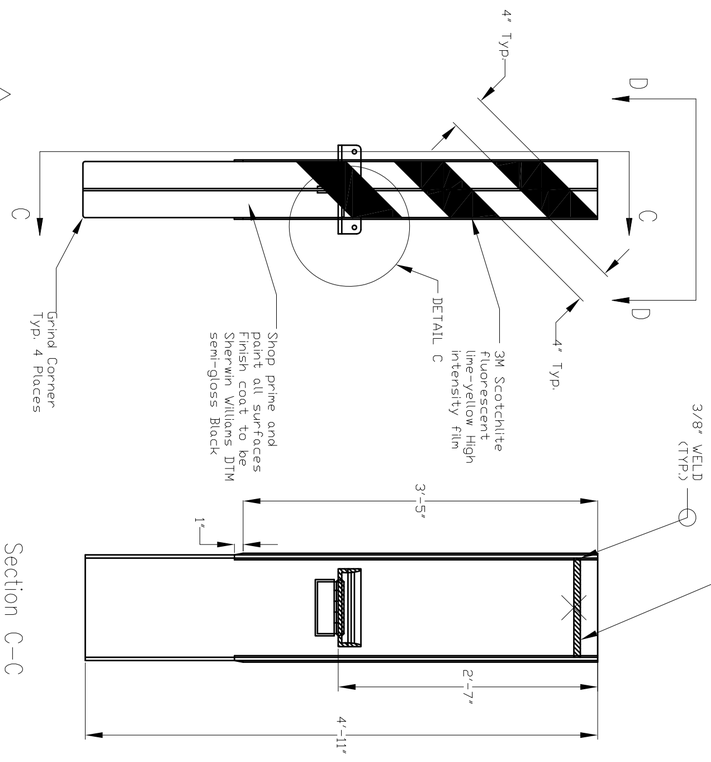

Section C-C
Scale: 1" = 1'

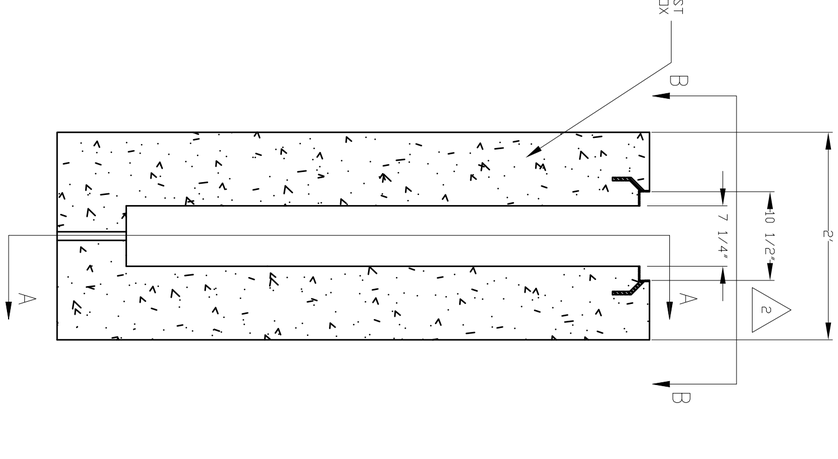

Detail A - Precast Bollard Box
Scale: 1" = 1'

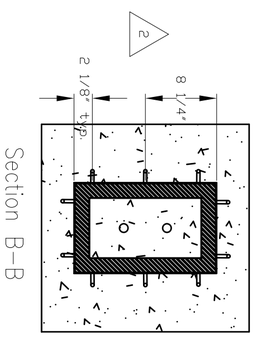

Section B-B
Scale: 1" = 1'

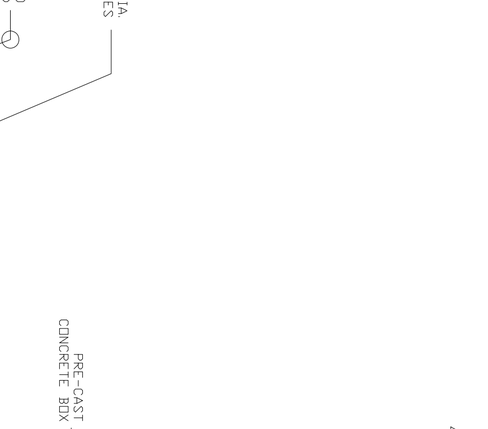

Section D-D
Scale: 1" = 1'

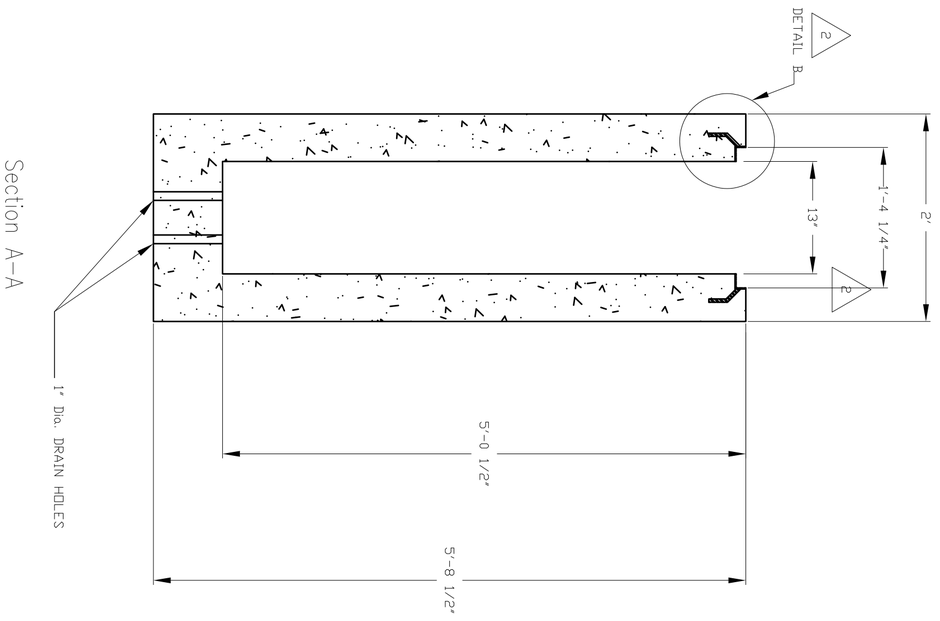

Section A-A
Scale: 1" = 1'

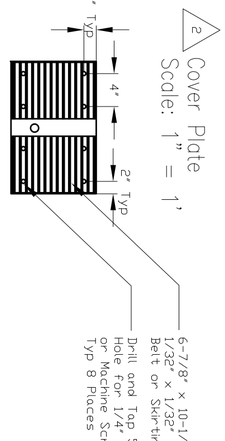

2 Cover Plate
Scale: 1" = 1'

2 Pad Placement
Scale: 1" = 1'

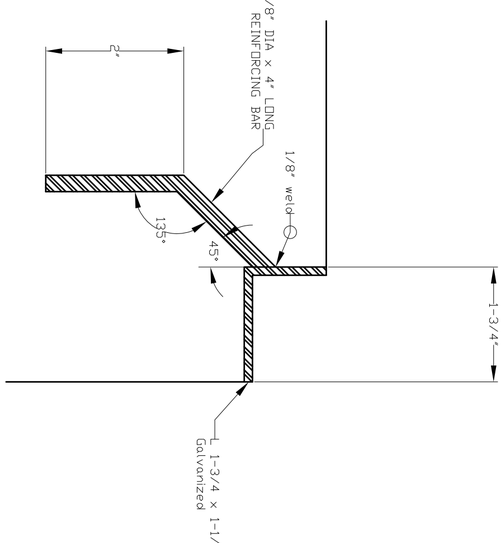

2 Detail B - Cover Plate Frame
Not to Scale

Section E-E - Hinged Support
Scale: 1" = 3"

Detail C - Hinged Support
Scale: 1" = 2"

Sheet Reference Number: C-404 Sheet 15 of 91	ADAL C-130J AIRCREW FUSELAGE TRAINER LRAFB, LITTLE ROCK AR. Project No. NKAK 043005 REMOVABLE BOLLARD DETAILS	DEPARTMENT OF THE ARMY U.S. ARMY CORPS OF ENGINEERS LITTLE ROCK DISTRICT LITTLE ROCK, ARKANSAS Atkins Benham (918) 492-1600 www.atkinsbenham.com a member of the WS Atkins group of companies WS Atkins	Designed by: / Drawn by: / Contract Date: Reviewed by: / Drwg. Code: / File Name: 193003X-000 Submitted by: Atkins Benham, Inc. / Plot date: 02/04/03 / Plot scale: 1:1 Invitation No.: DACA03-03-R-0021 / Contract No.: DACA03-03-B-	Mark / Description / Date / Appr. (x2)	U.S. ARMY CORPS OF ENGINEERS LITTLE ROCK DISTRICT