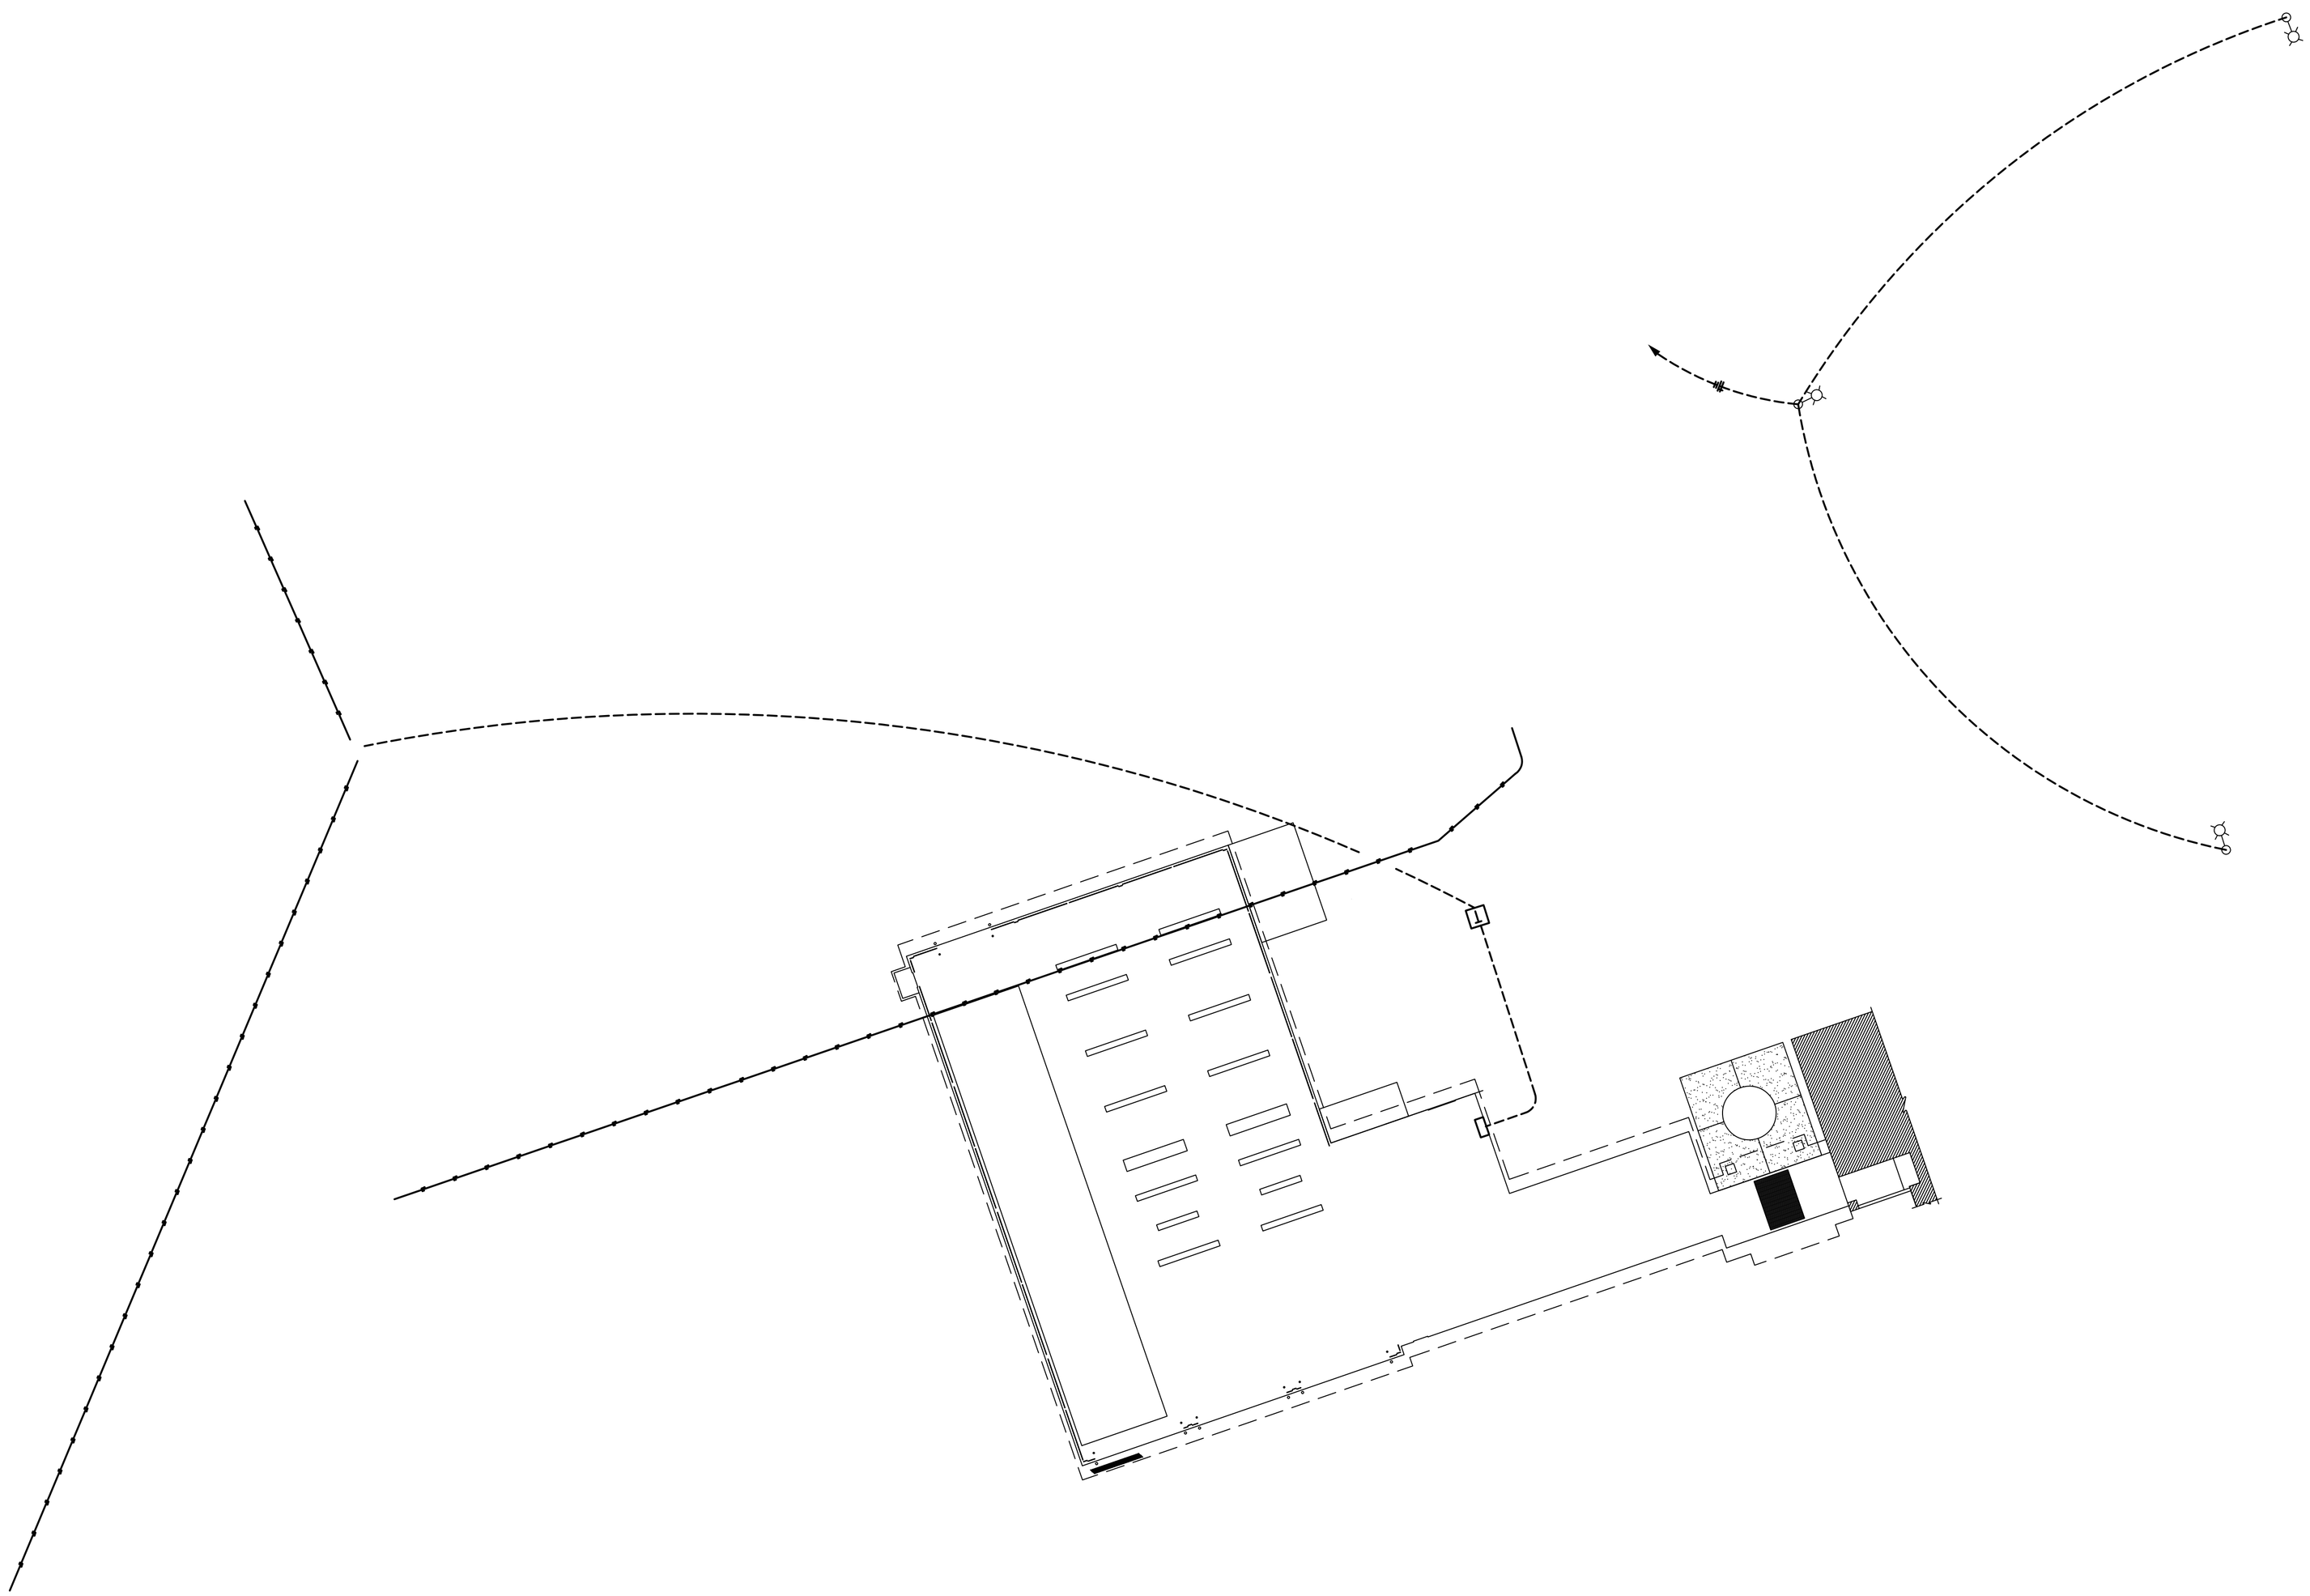

X/X/X

ADAL C-130J AIRCREW FUSELAGE TRAINER LRAFB, LITTLE ROCK AR. Project No. WK4K 043005	Sheet Reference Number: Sheet 1 of 91

DEPARTMENT OF THE ARMY
U.S. ARMY CORPS OF ENGINEERS
LITTLE ROCK DISTRICT
LITTLE ROCK, ARKANSAS

Atkins Benham
(918) 492-1600 www.atkinsbenham.com
a multidisciplinary, multinational group of companies Atkins
WS Atkins

Designed by:	Drawn by:
Reviewed by:	Drwg. Code:
Submitted by:	Plot date: 02/04/03
Atkins Benham, Inc.	Plot scale: 1:1
Installation No. DACA03-03-R-0021	Contract No. DACA03-03-R-
Contract Dates:	File Number: 193003X-000

Mark	Description	Date	Appr.	Mark	Description	Date	Appr.

U.S. ARMY CORPS
OF ENGINEERS
LITTLE ROCK DISTRICT