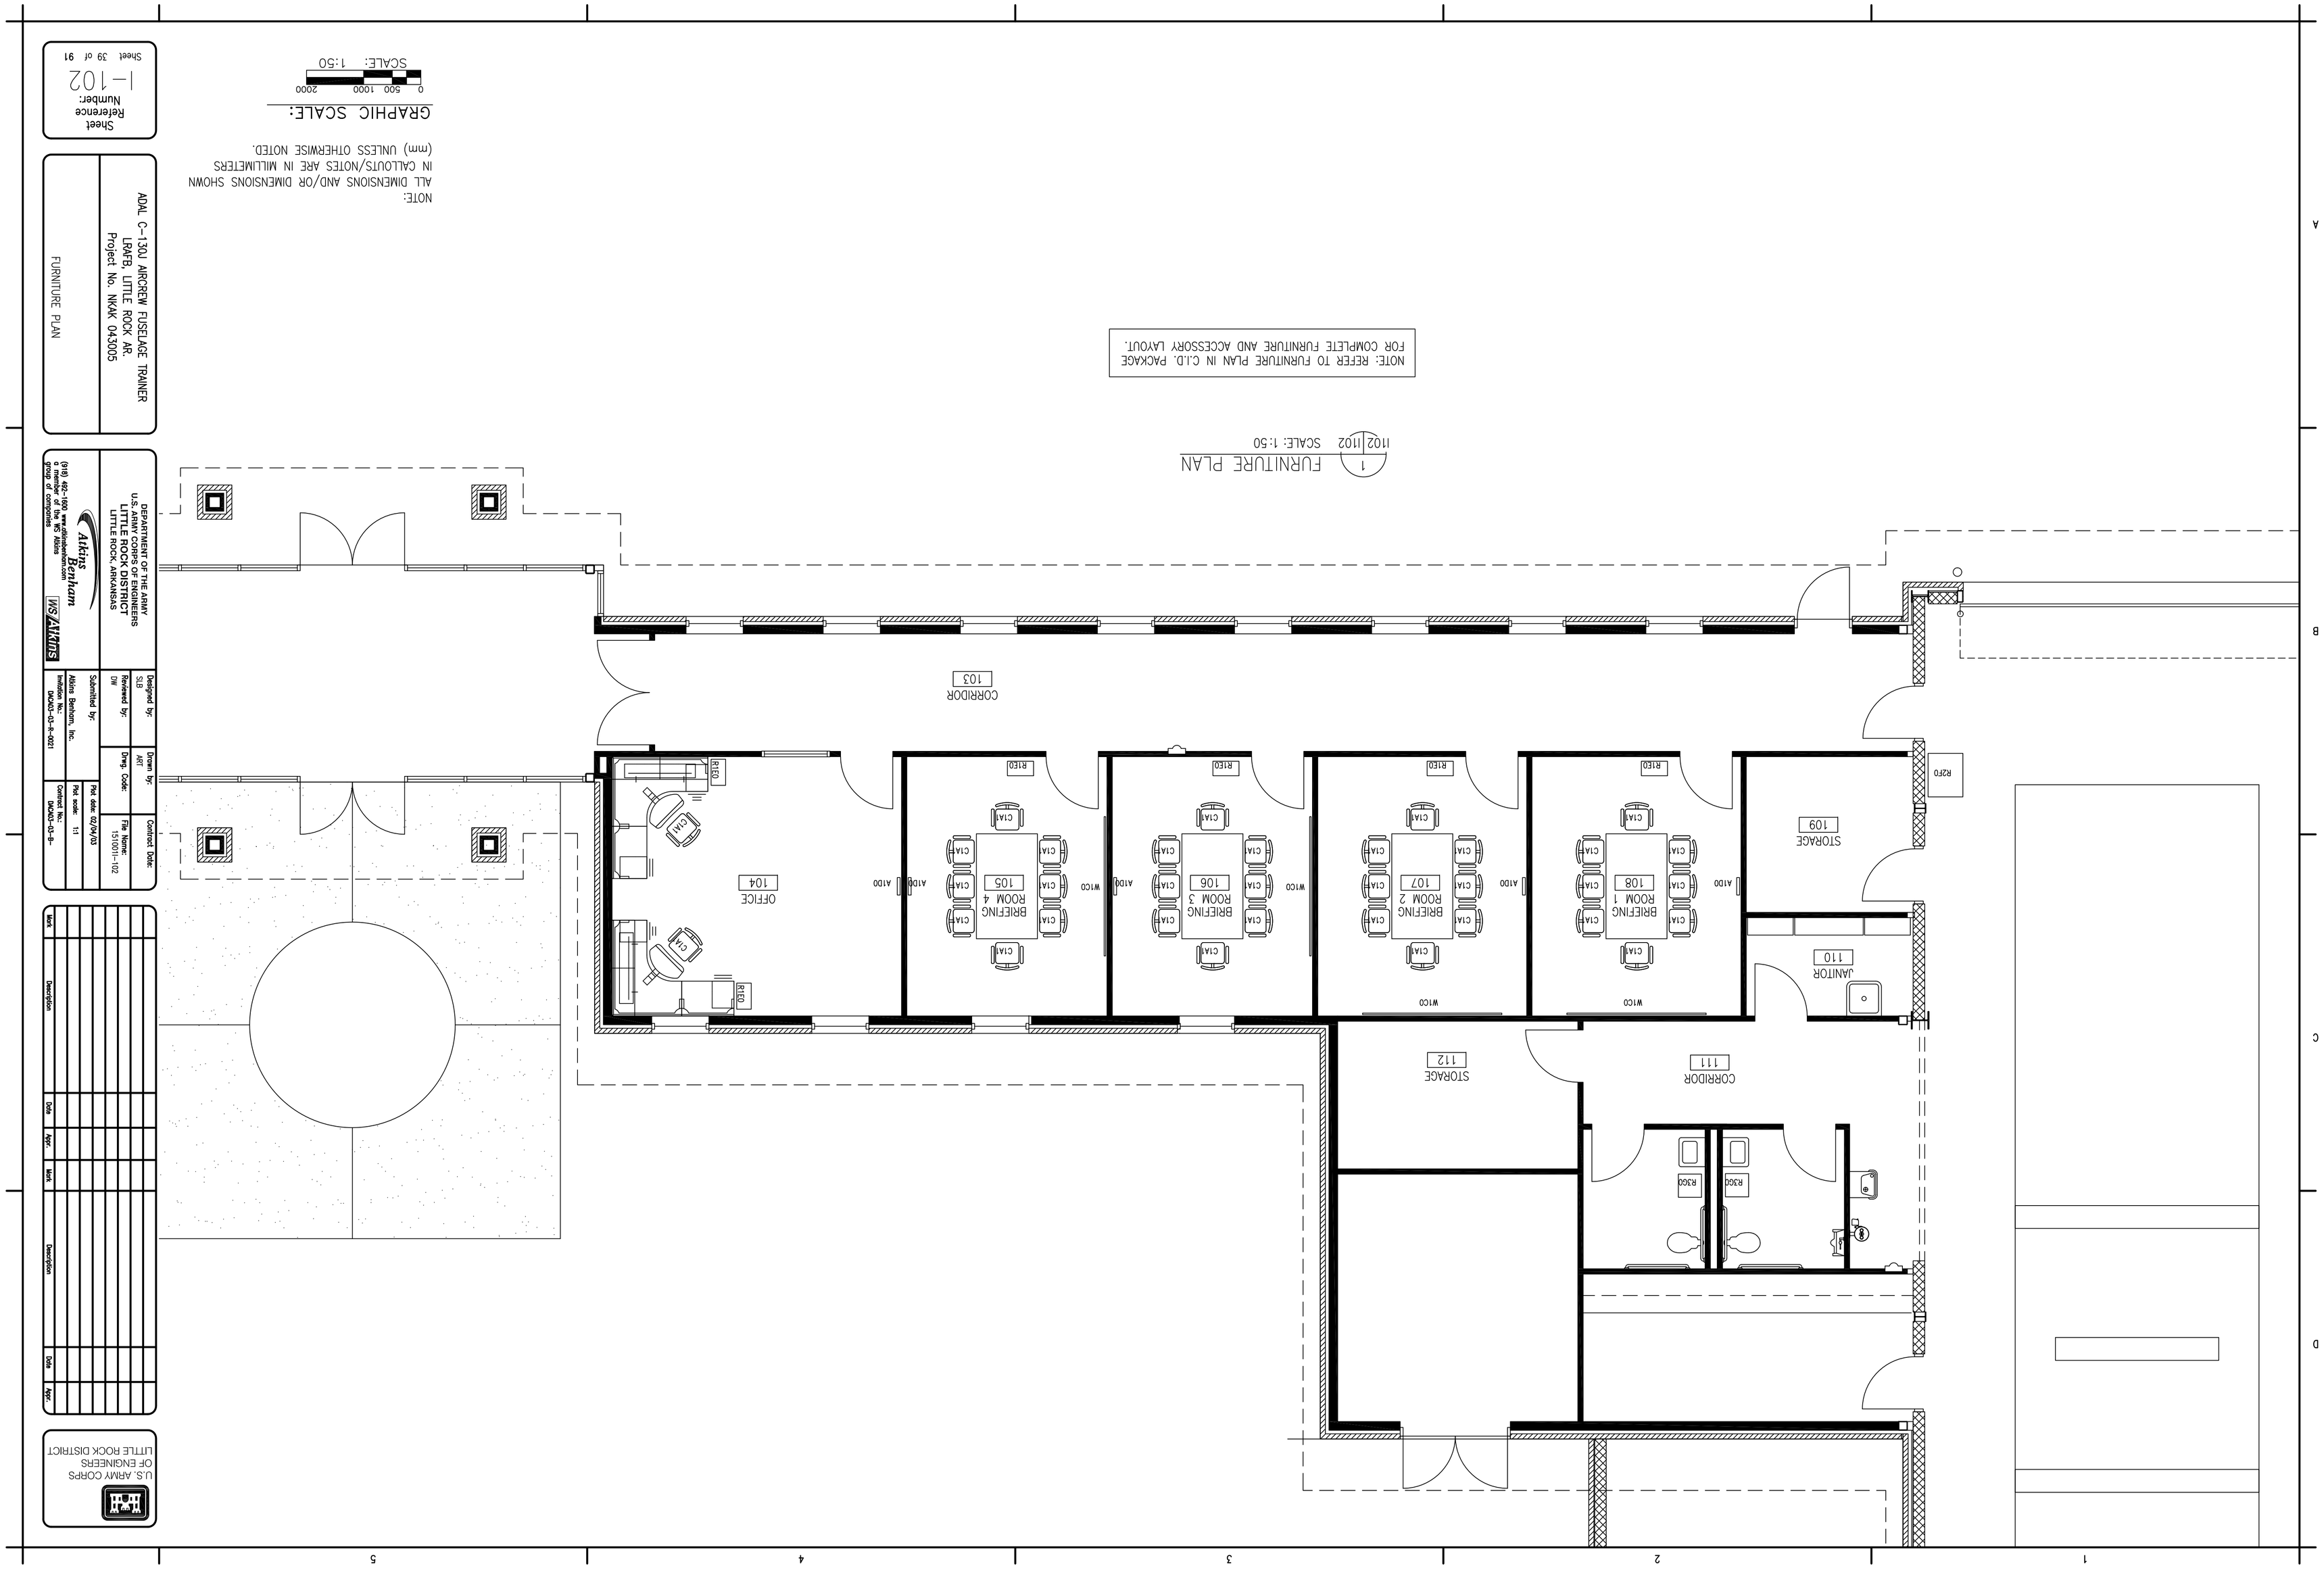Drawing: F:\2402151001 LRAFB C130J FUSELAGE TRAINER\20_CAD\\151001I-102 Saved: 03/27/2003 18:19 By: tbg DimScale: 1.00 (TM=0)
XRefs: 151001G-BS001.DWG 151001A-FP01.DWG 151001I-RP01.DWG 151001S-CP01.DWG