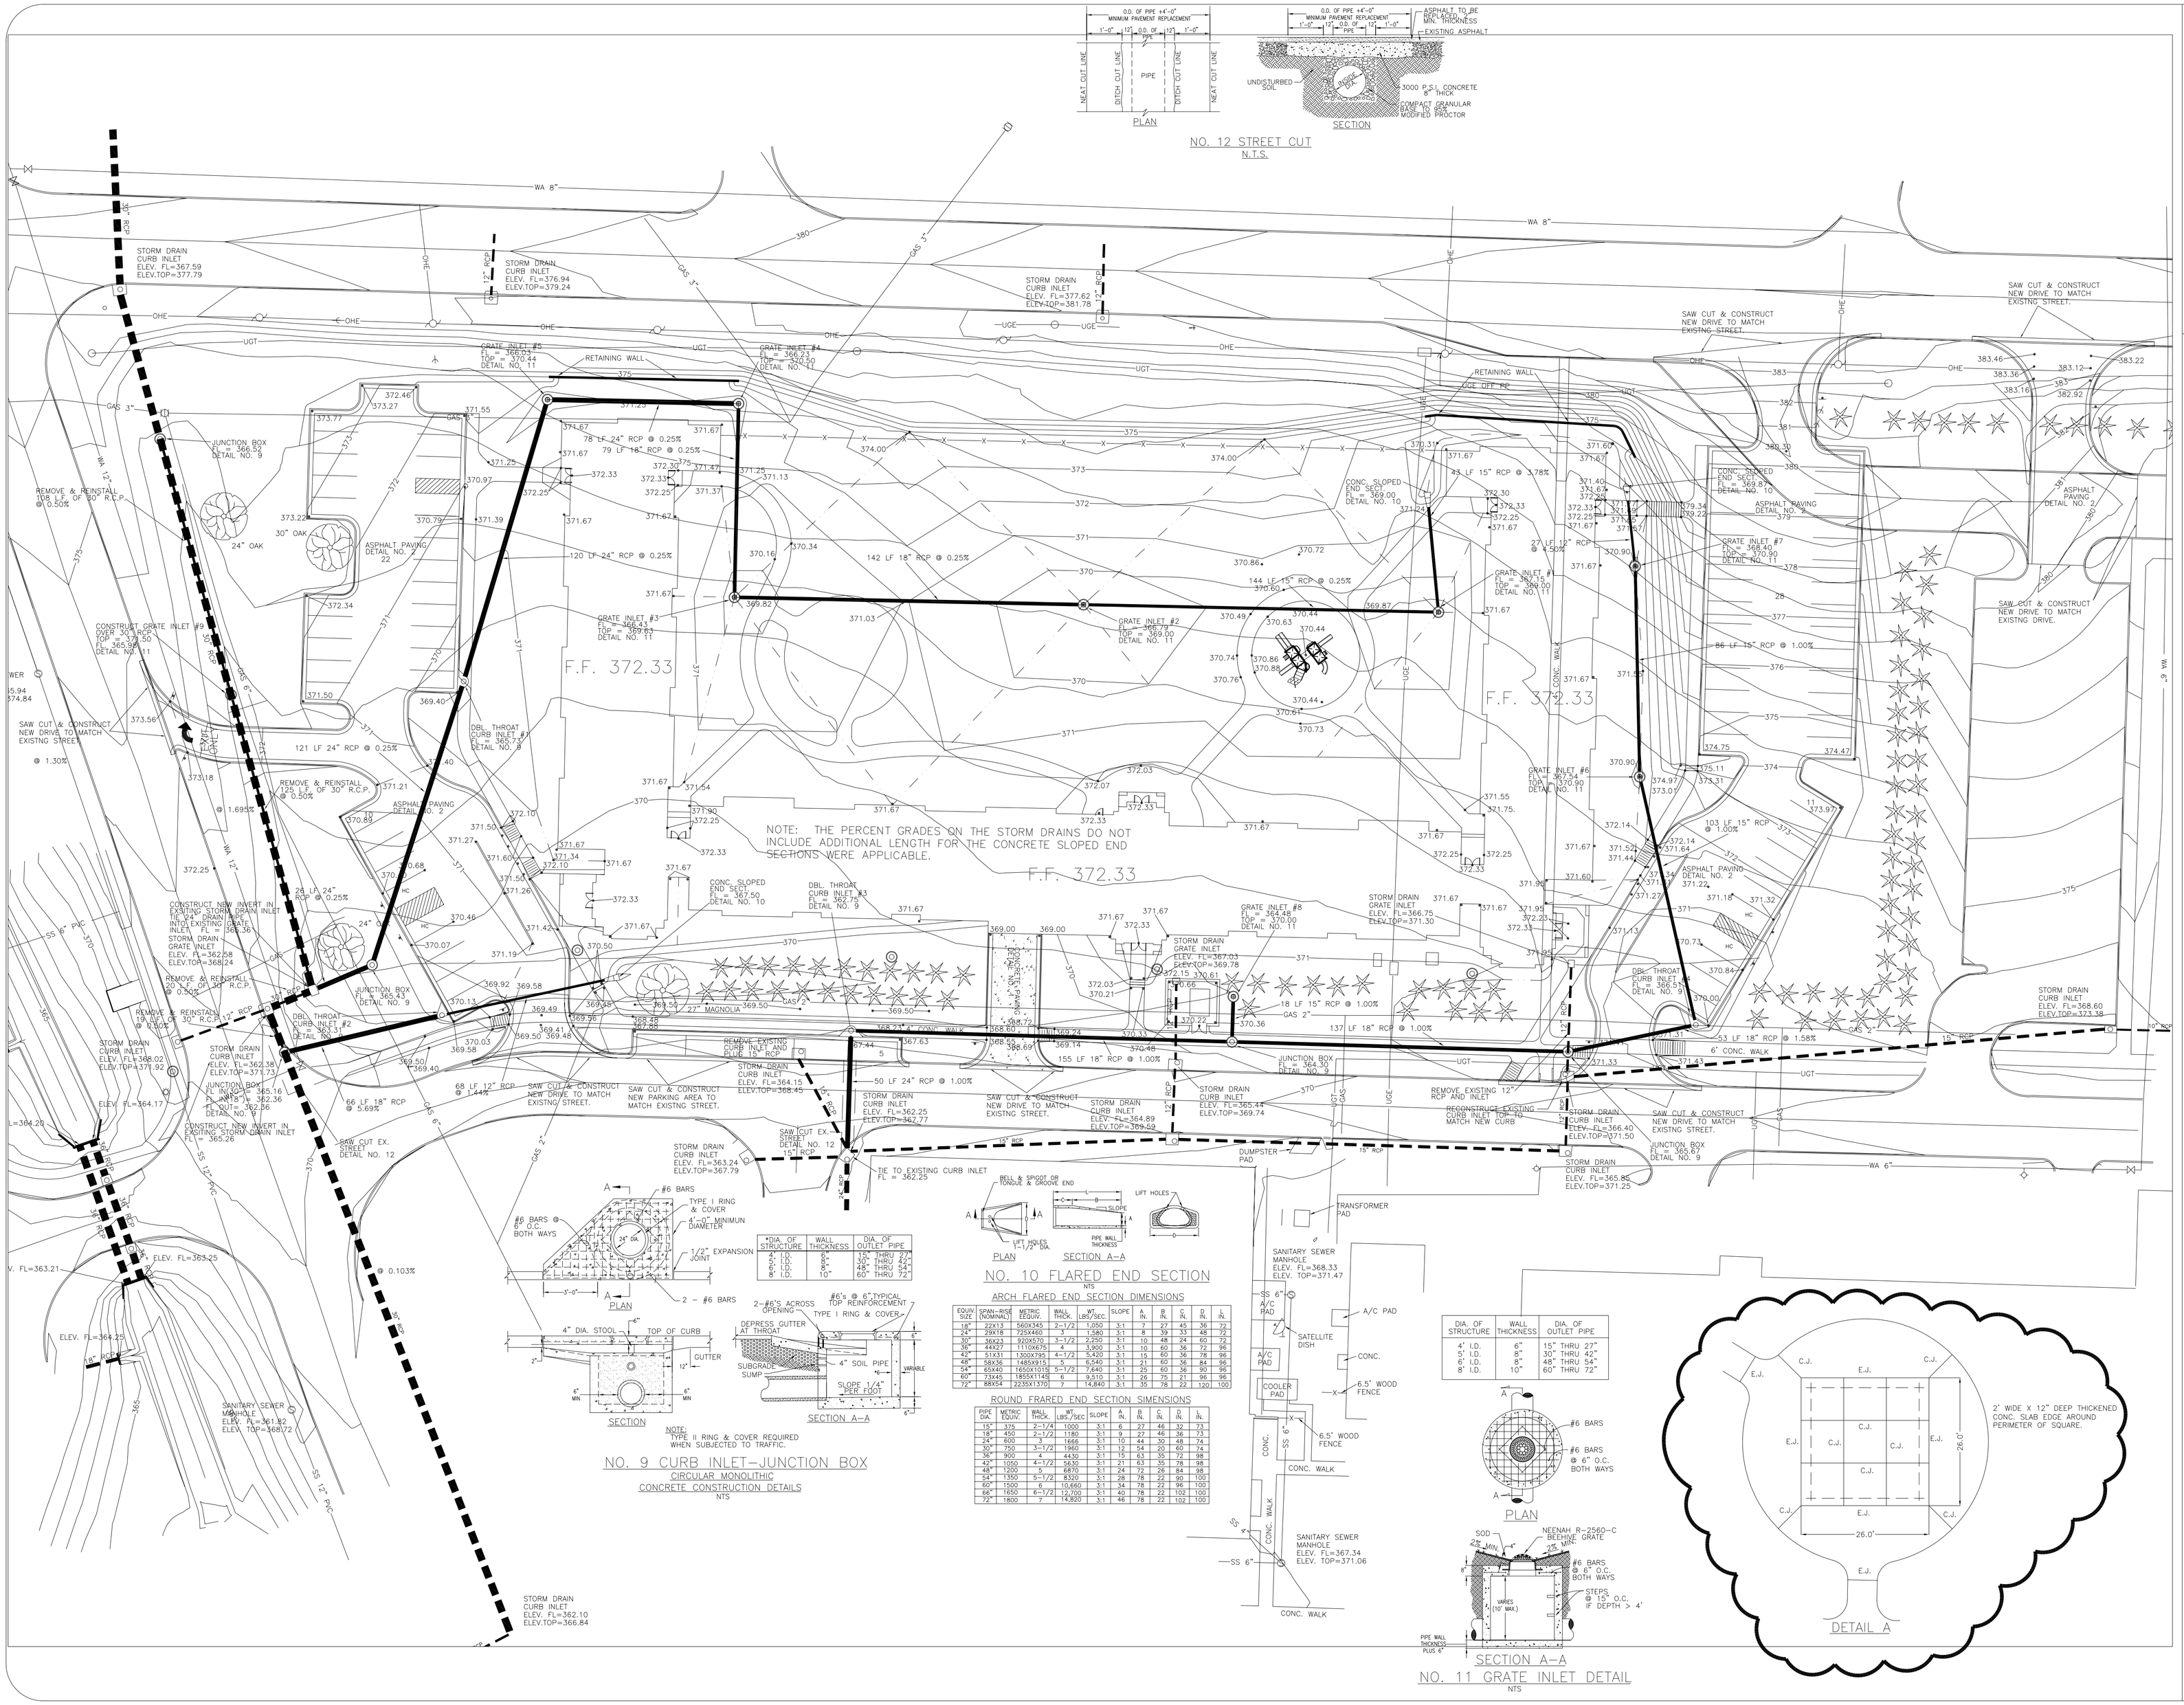

AIR EDUCATION & TRAINING COMMAND

LITTLE ROCK A.F.B.
ARKANSAS

No.	Revision/Issue	Date	BY	APP'D
1	Gazebo Slab Detail	2/05		

PROJECT TITLE

TEMPORARY LODGING FACILITY (TLF)
LITTLE ROCK AIR FORCE BASE

SHEET TITLE

GRADING & DRAINAGE PLAN
AS-BUILT

DRAWN BY KRY	LEAD DESIGNER KRY
TECH REVIEWER JEE	FILE LOCATION G:\00-133\DESIGN\00133SITE.DWG
DESIGNED BY KRY	PROJECT NUMBER NKAK02-5001
DATE 28 MAY 2002	SHEET C2
SCALE 1"=30'	3 OF 108