
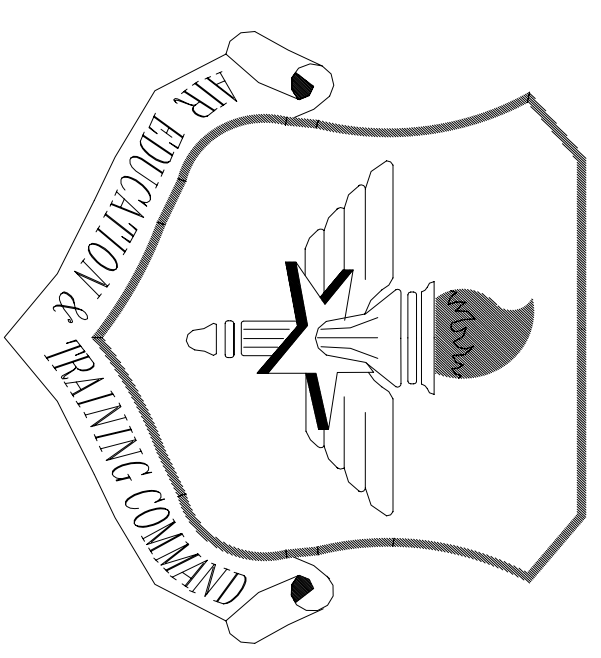


NOTE:
 1. SEE SHEETS A25 - A28 FOR INTERIOR DIMENSIONS NOT SHOWN.
 2. ALL DIMENSIONS SHOWN ARE TO FINISH FACE OF BRICK.

1 FIRST FLOOR DIMENSION PLAN
 SCALE 1/16" = 1'-0"
 0" 5' 10' 20' 40'

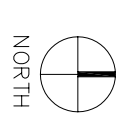

LITTLE ROCK A.F.B.
 ARKANSAS

No.	Revision/Issue	Date	BY	APP'D
1	Wall and Door locations Changed from Design			

PROJECT TITLE
 TEMPORARY LODGING FACILITY

SHEET TITLE
 FIRST FLOOR DIMENSION PLAN
 AS-BUILT

DRAWN BY JB / RL	LEAD DESIGNER BC
TECH REVIEWER	FILE LOCATION
DESIGNED BY BC	PROJECT NUMBER NKA02-5001
DATE 28 MAY 2002	SHEET 14 of 108
SCALE 1/16" = 1'-0"	