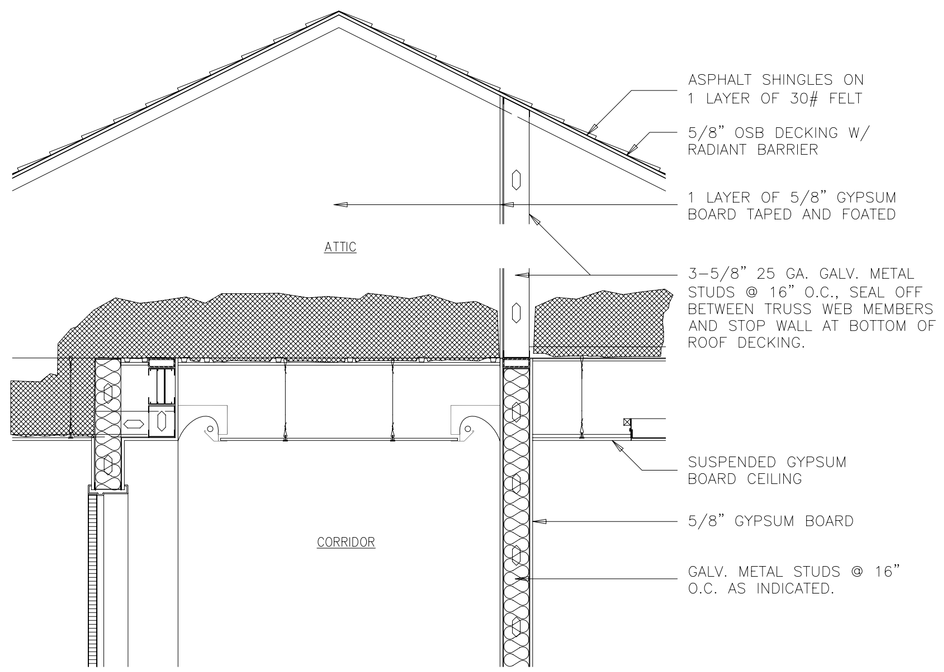

3 DRAFT STOPPING SECTION
SCALE :3/4"=1'-0"
RE :
0' 1' 2' 4'

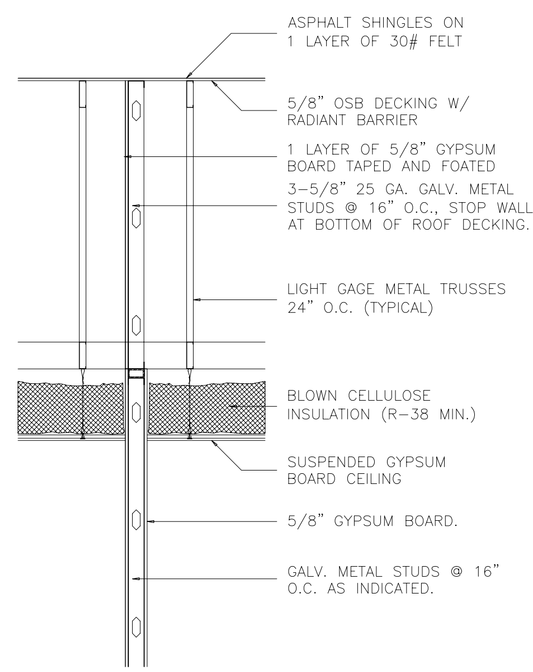

2 DRAFT STOPPING SECTION
SCALE :3/4"=1'-0"
RE :
0' 1' 2' 4'

DOOR AND FRAME SCHEDULE

DOORS								FRAMES				DOOR & FRAME		
DOOR NO.	DOOR SIZE (W x H x T)	DOOR TYPE	MATERIAL	GAUGE	FINISH	GLAZING TYPE	TYPE	MATERIAL	GAUGE	FINISH	HWD. SET	FIRE RATING	REMARKS
1	3'-0" x 7'-0" x 1 3/4" PR.	A	AL		AL	GL-2	VARIES	AL		AL	1		1
2	3'-0" x 7'-0" x 1 3/4" PR.	A	AL		AL	GL-2	F7	AL		AL	1		
3	3'-0" x 7'-0" x 1 3/4" PR.	D	WD		STAIN		F6	HM	16	PT	6	45 MIN.	
4	3'-0" x 7'-0" x 1 3/4"	B	HM	16	PT		F4	HM	16	PT	3	1 HR.	
5	3'-0" x 7'-0" x 1 3/4"	C	WD		STAIN	GL-3	F4	HM	16	PT	5	1 HR.	5
6	3'-0" x 7'-0" x 1 3/4"	D	WD		STAIN		F4	HM	16	PT	4	45 MIN.	
7	2'-4" x 7'-0" x 1 3/4" PR.	G	WD		STAIN		—	HM	16	PT	7		
8	3'-0" x 7'-0" x 1 3/4"	D	WD		STAIN		F4	HM	16	PT	8-12		4
9	3'-0" x 7'-0" x 1 3/4"	F	WD		STAIN		F3	HM	16	PT	13		
10	2'-4" x 7'-0" x 1 3/4"	G	WD		STAIN		F2	HM	16	PT	14		
11	2'-8" x 7'-0" x 1 3/4"	E	WD		STAIN		F3	HM	16	PT	14		
12	2'-0" x 7'-0" x 1 3/4" PR.	H	WD		STAIN		F5	HM	16	PT	15		
13	12'-0" x 7'-0" x 1 3/4"	J	WD		STAIN		F8	HM	16	PT	16		
14	6'-0" x 10'-0" x 1 3/4"	K	STEEL					STEEL			17		
15	3'-0" x 7'-0" x 1 3/4"	A	AL		AL	GL-2	VARIES	AL		AL	2		1

REMARKS
1. REEFER TO DOOR & WINDOW ELEVATIONS A35.
2. ALL GLAZING SHALL HAVE APPROPRIATE FIRE RATING.
3. NOT USED
4. HW- 8 (BEDROOMS)
   HW- 9 (TOILET VESTIBULES FROM LIVING ROOM/ KITCHEN AREA)
   HW- 10 (ROOM 101 AND 105)
   HW- 11 (ROOM 106)
   HW- 12 (ROOM 108 FROM CORRIDOR 103)
5. 1st FLOOR IN STAIR 117 & 162, PAINT "NO FIRE EXIT" W/ 4" HIGH LETTERS ON BACK OF DOOR.

NOTE:
CORRIDOR PARTITIONS, SMOKE STOP PARTITIONS, HORIZONTAL EXIT PARTITIONS, EXIT ENCLOSURES, AND FIRE RATED WALLS REQUIRED TO HAVE PROTECTED OPENINGS SHALL BE EFFECTIVELY AND PERMANENTLY IDENTIFIED WITH SIGNS OR STENCILING IN A MANNER ACCEPTABLE TO THE AUTHORITY HAVING JURISDICTION. SUCH IDENTIFICATION SHALL BE ABOVE ANY DECORATIVE CEILING AND IN CONCEALED SPACES. SUGGESTED WORDING: FIRE AND SMOKE BARRIER PROTECT ALL OPENINGS. SPACE SIGNAGE NO FARTHER THAN 4'-0" O.C.

LEGEND

- 1 HOUR RATED PARTITION, RE: 1/A7
- 1/2 HOUR RATED PARTITION, AS PER DETAIL 1/A7
- DIRECTION OF EGRESS
- EXIT SIGN, ONE SIDED
- EXIT SIGN, DOUBLE SIDED
- F.E.C. FIRE EXTINGUISHER CABINET
- (X) DOOR SYMBOL

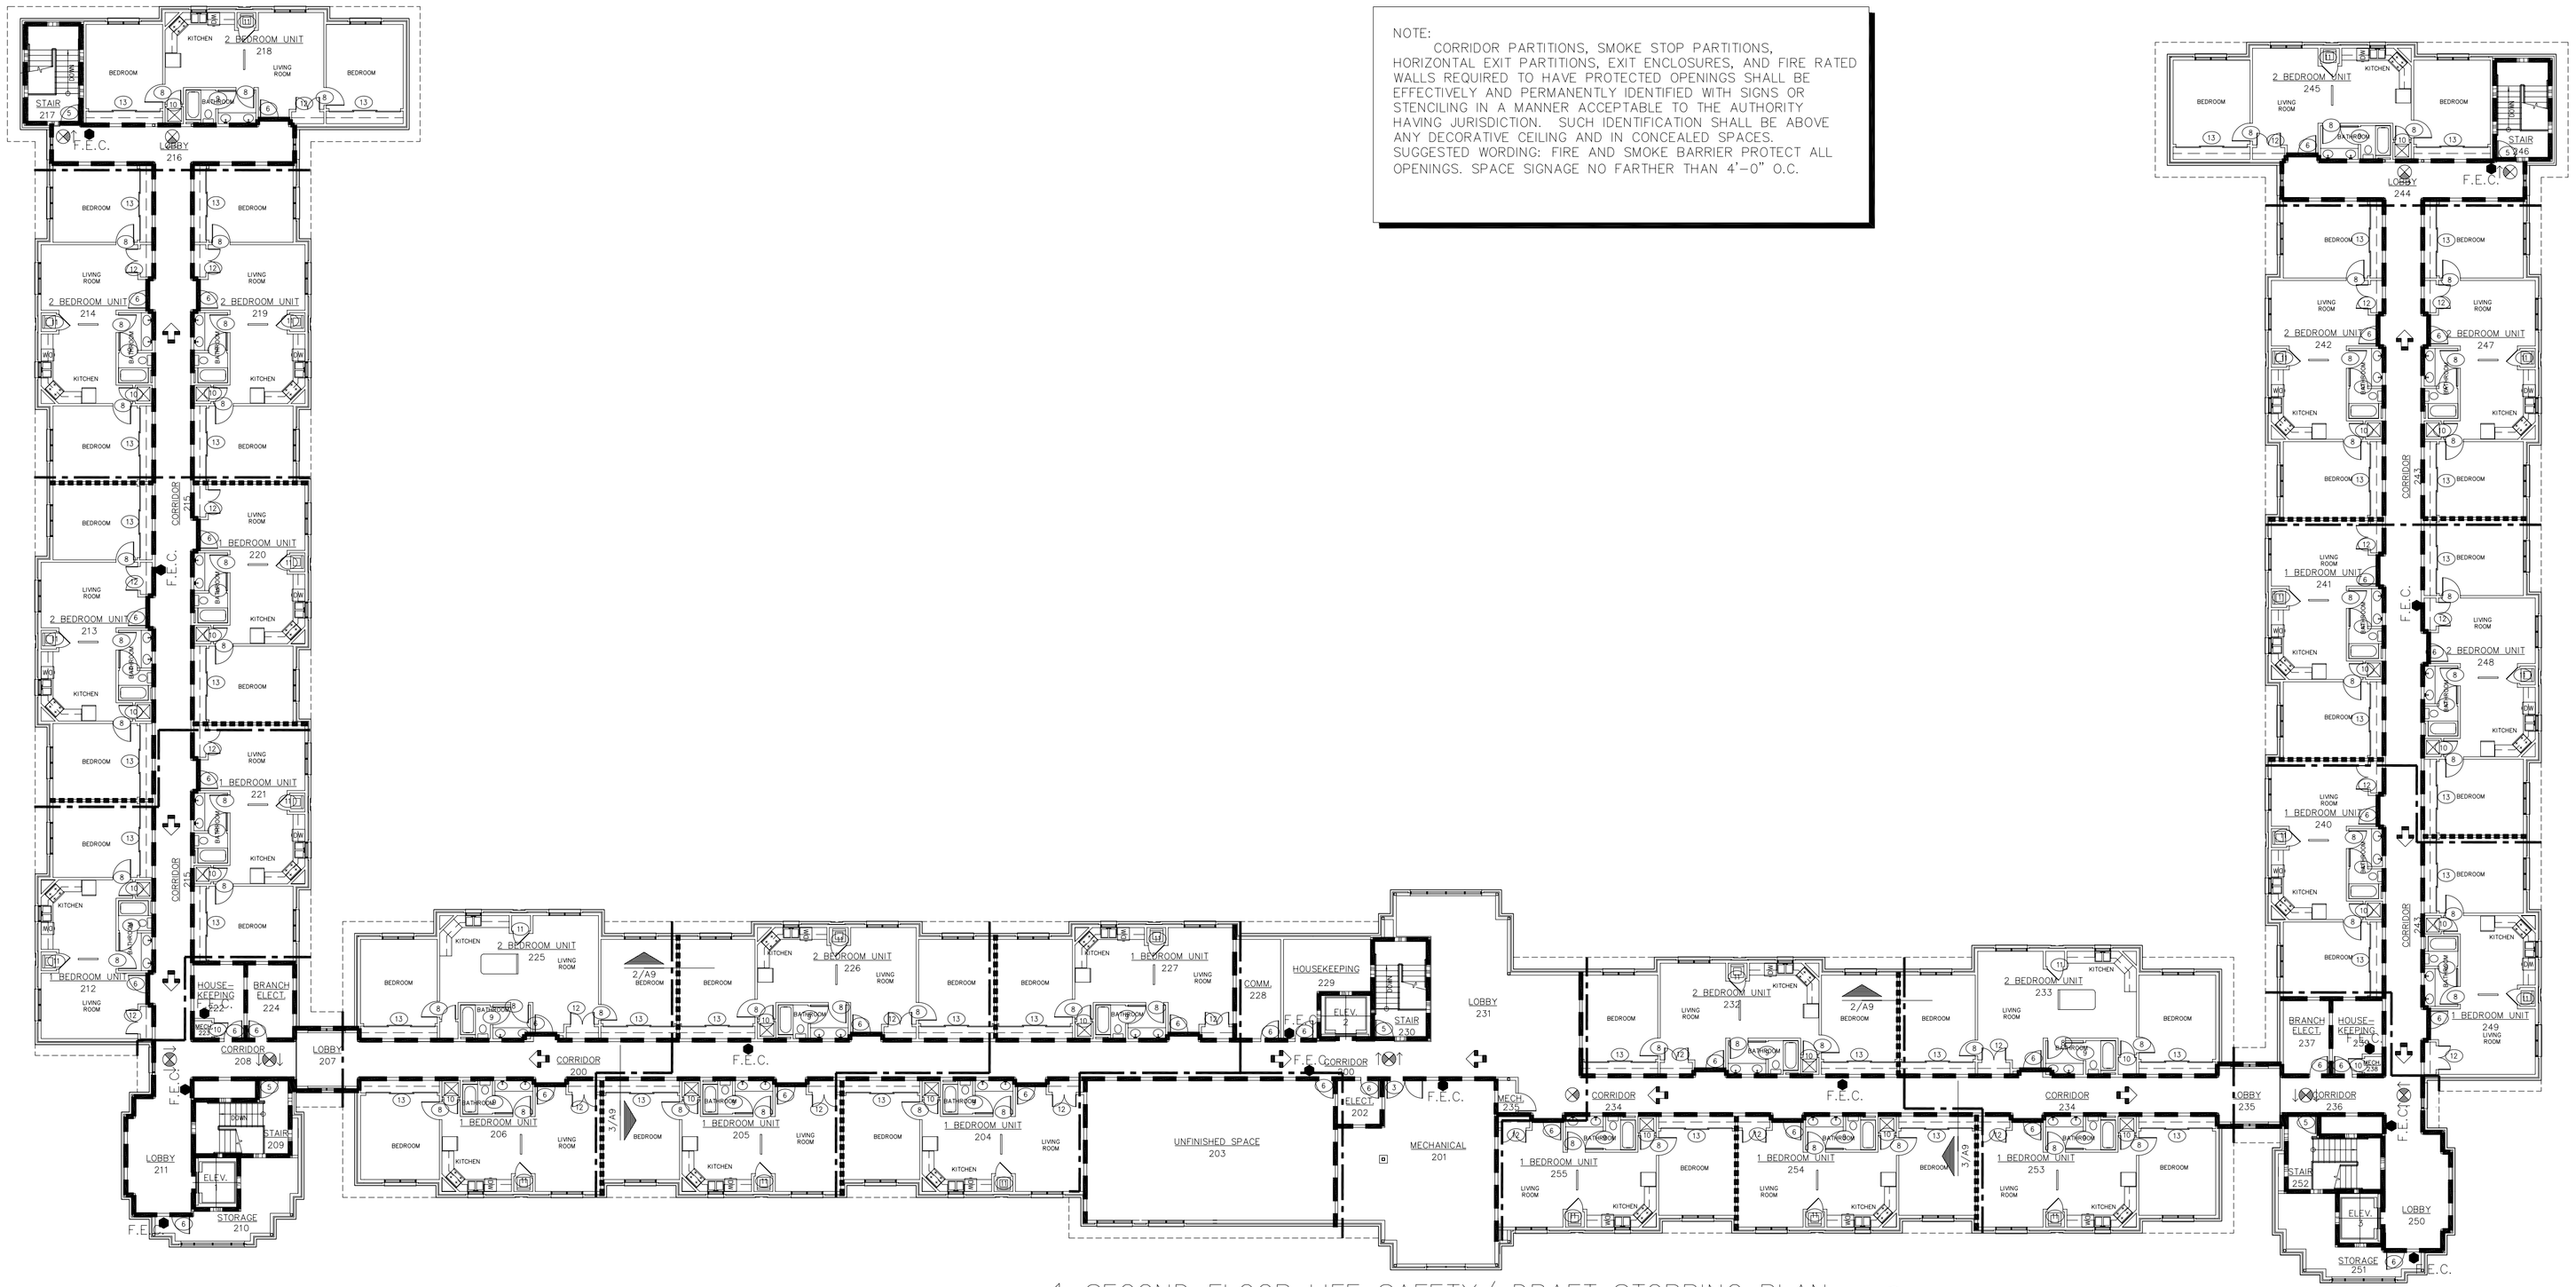

1 SECOND FLOOR LIFE SAFETY/ DRAFT STOPPING PLAN
SCALE :1/16"=1'-0"
RE :
0' 5' 10' 20' 40'
SECOND FLOOR 32,212 SQ.FT.
NORTH

AIR EDUCATION & TRAINING COMMAND

LITTLE ROCK A.F.B.
ARKANSAS

No.	Revision/Issue	Date	BY	APP'D
1	No Changes from Deign to As-Built			

PROJECT TITLE
TEMPORARY LODGING FACILITY

SHEET TITLE
SECOND FLOOR
LIFE SAFETY PALN
AS-BUILT

DRAWN BY JB	LEAD DESIGNER BG
TECH REVIEWER	FILE LOCATION
DESIGNED BY BG	PROJECT NUMBER NKAK02-5001
DATE 28 MAY 2002	SHEET A9
SCALE 1/16" = 1'-0"	18 OF 108