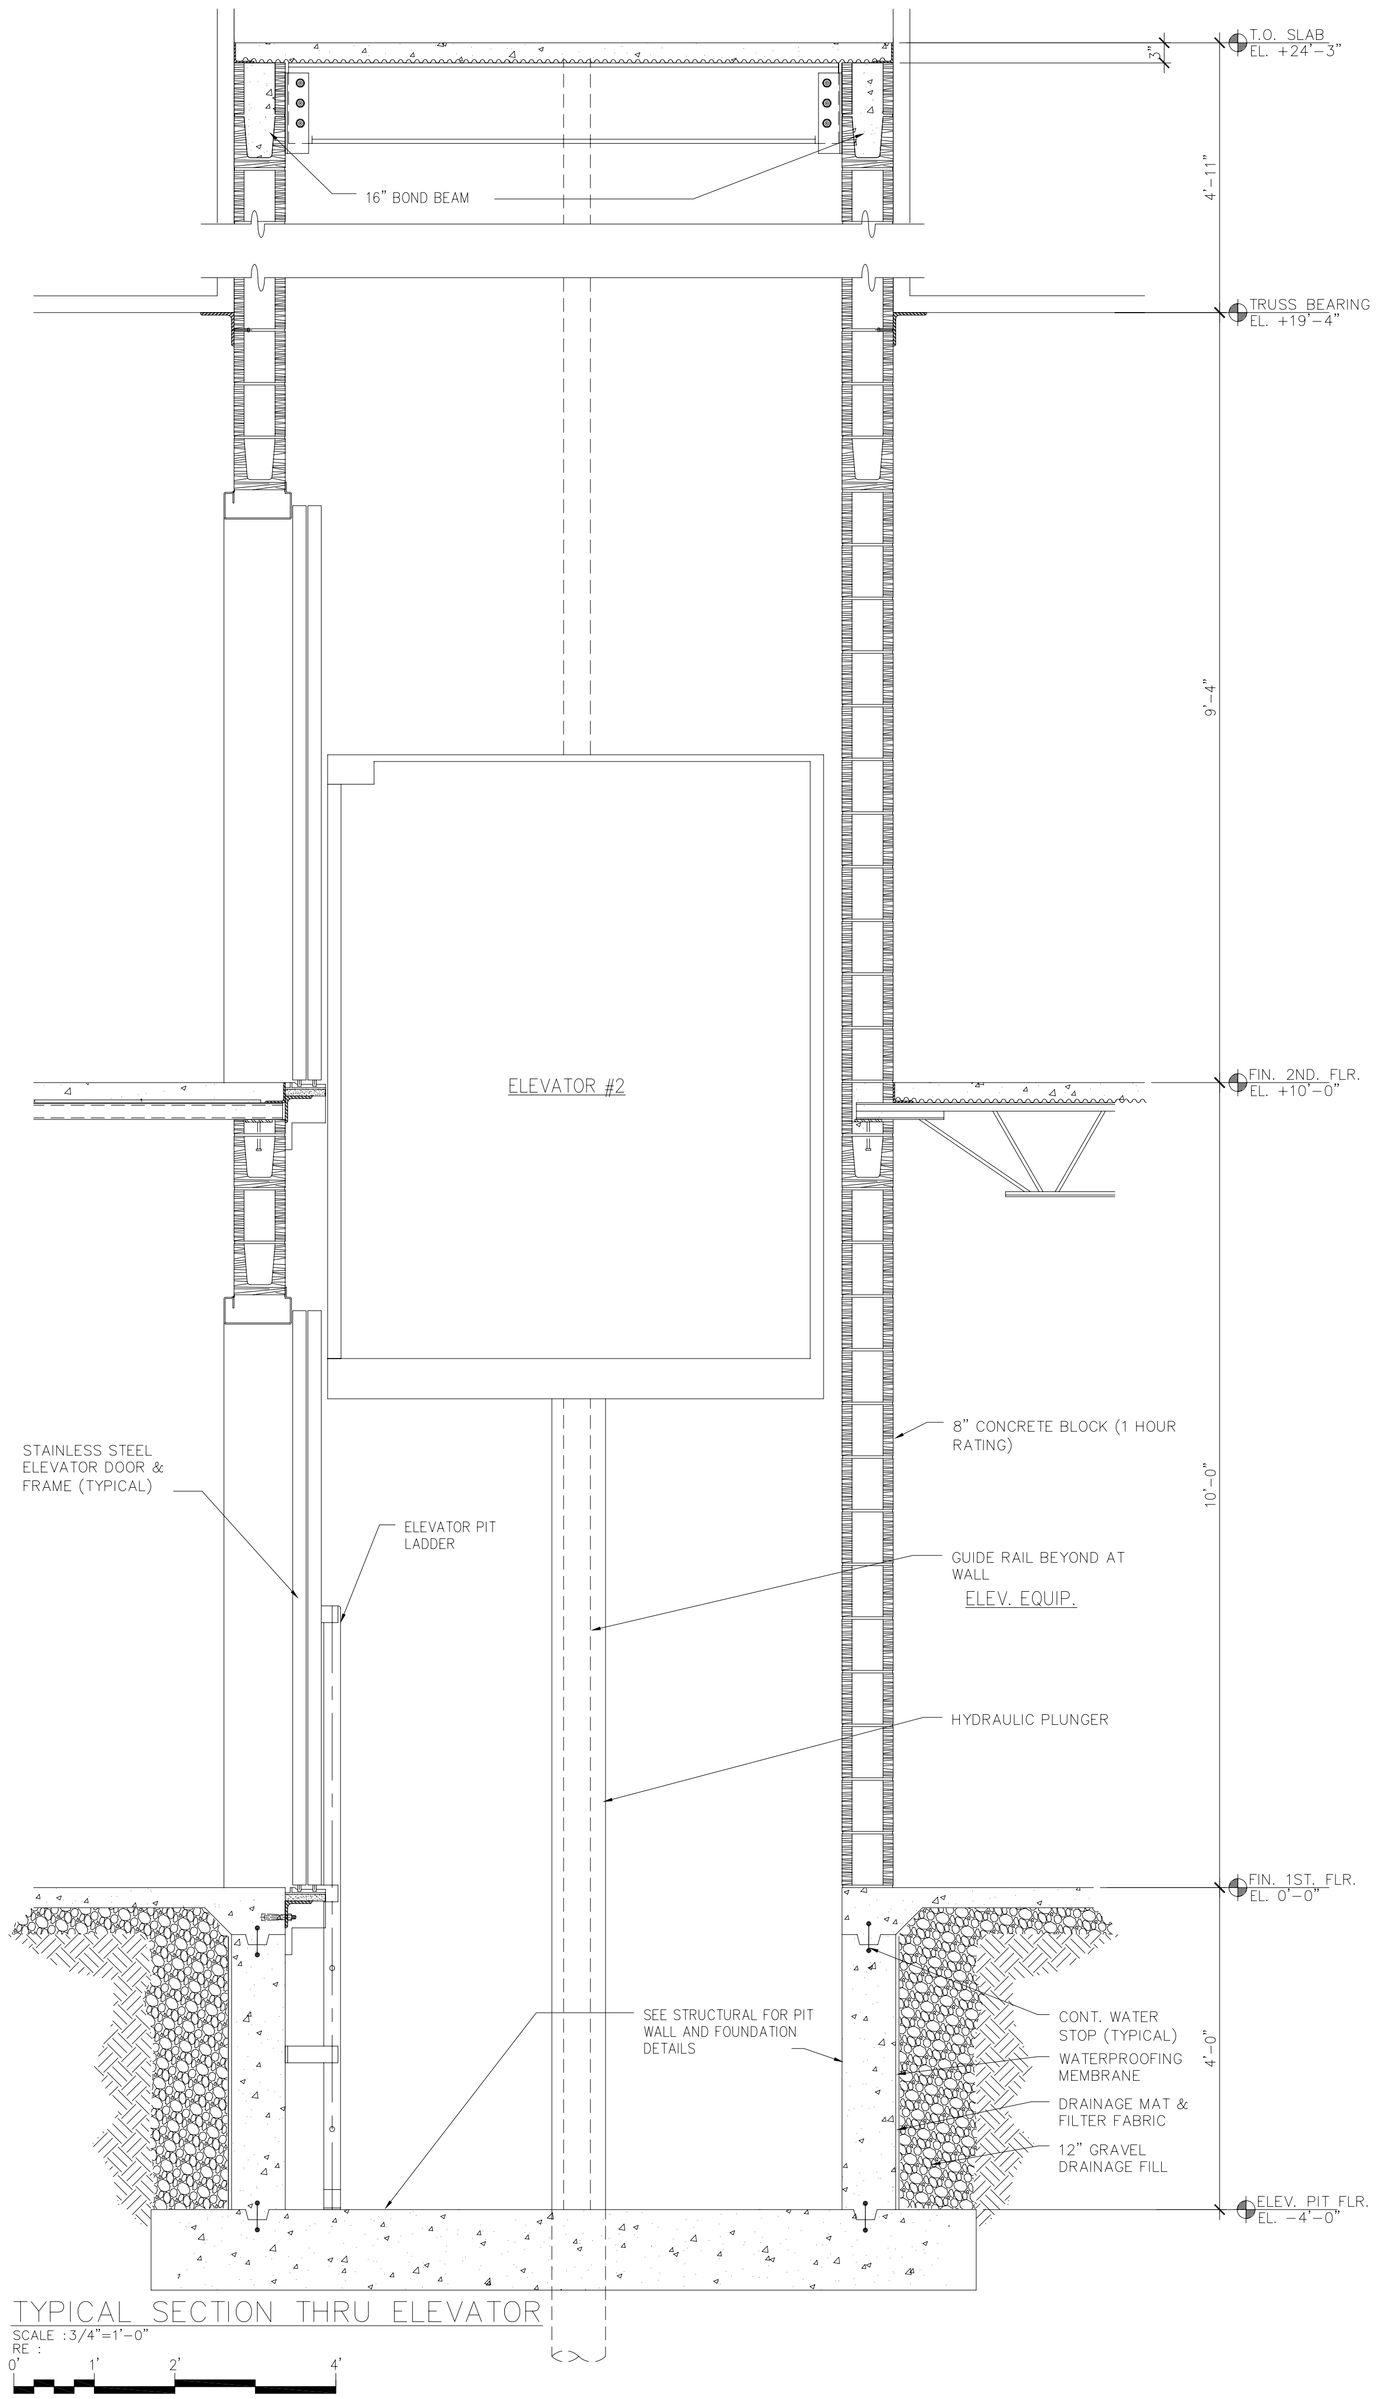

2 TYPICAL SECTION THRU ELEVATOR

SCALE :3/4"=1'-0"
RE :
0' 1' 2' 4'

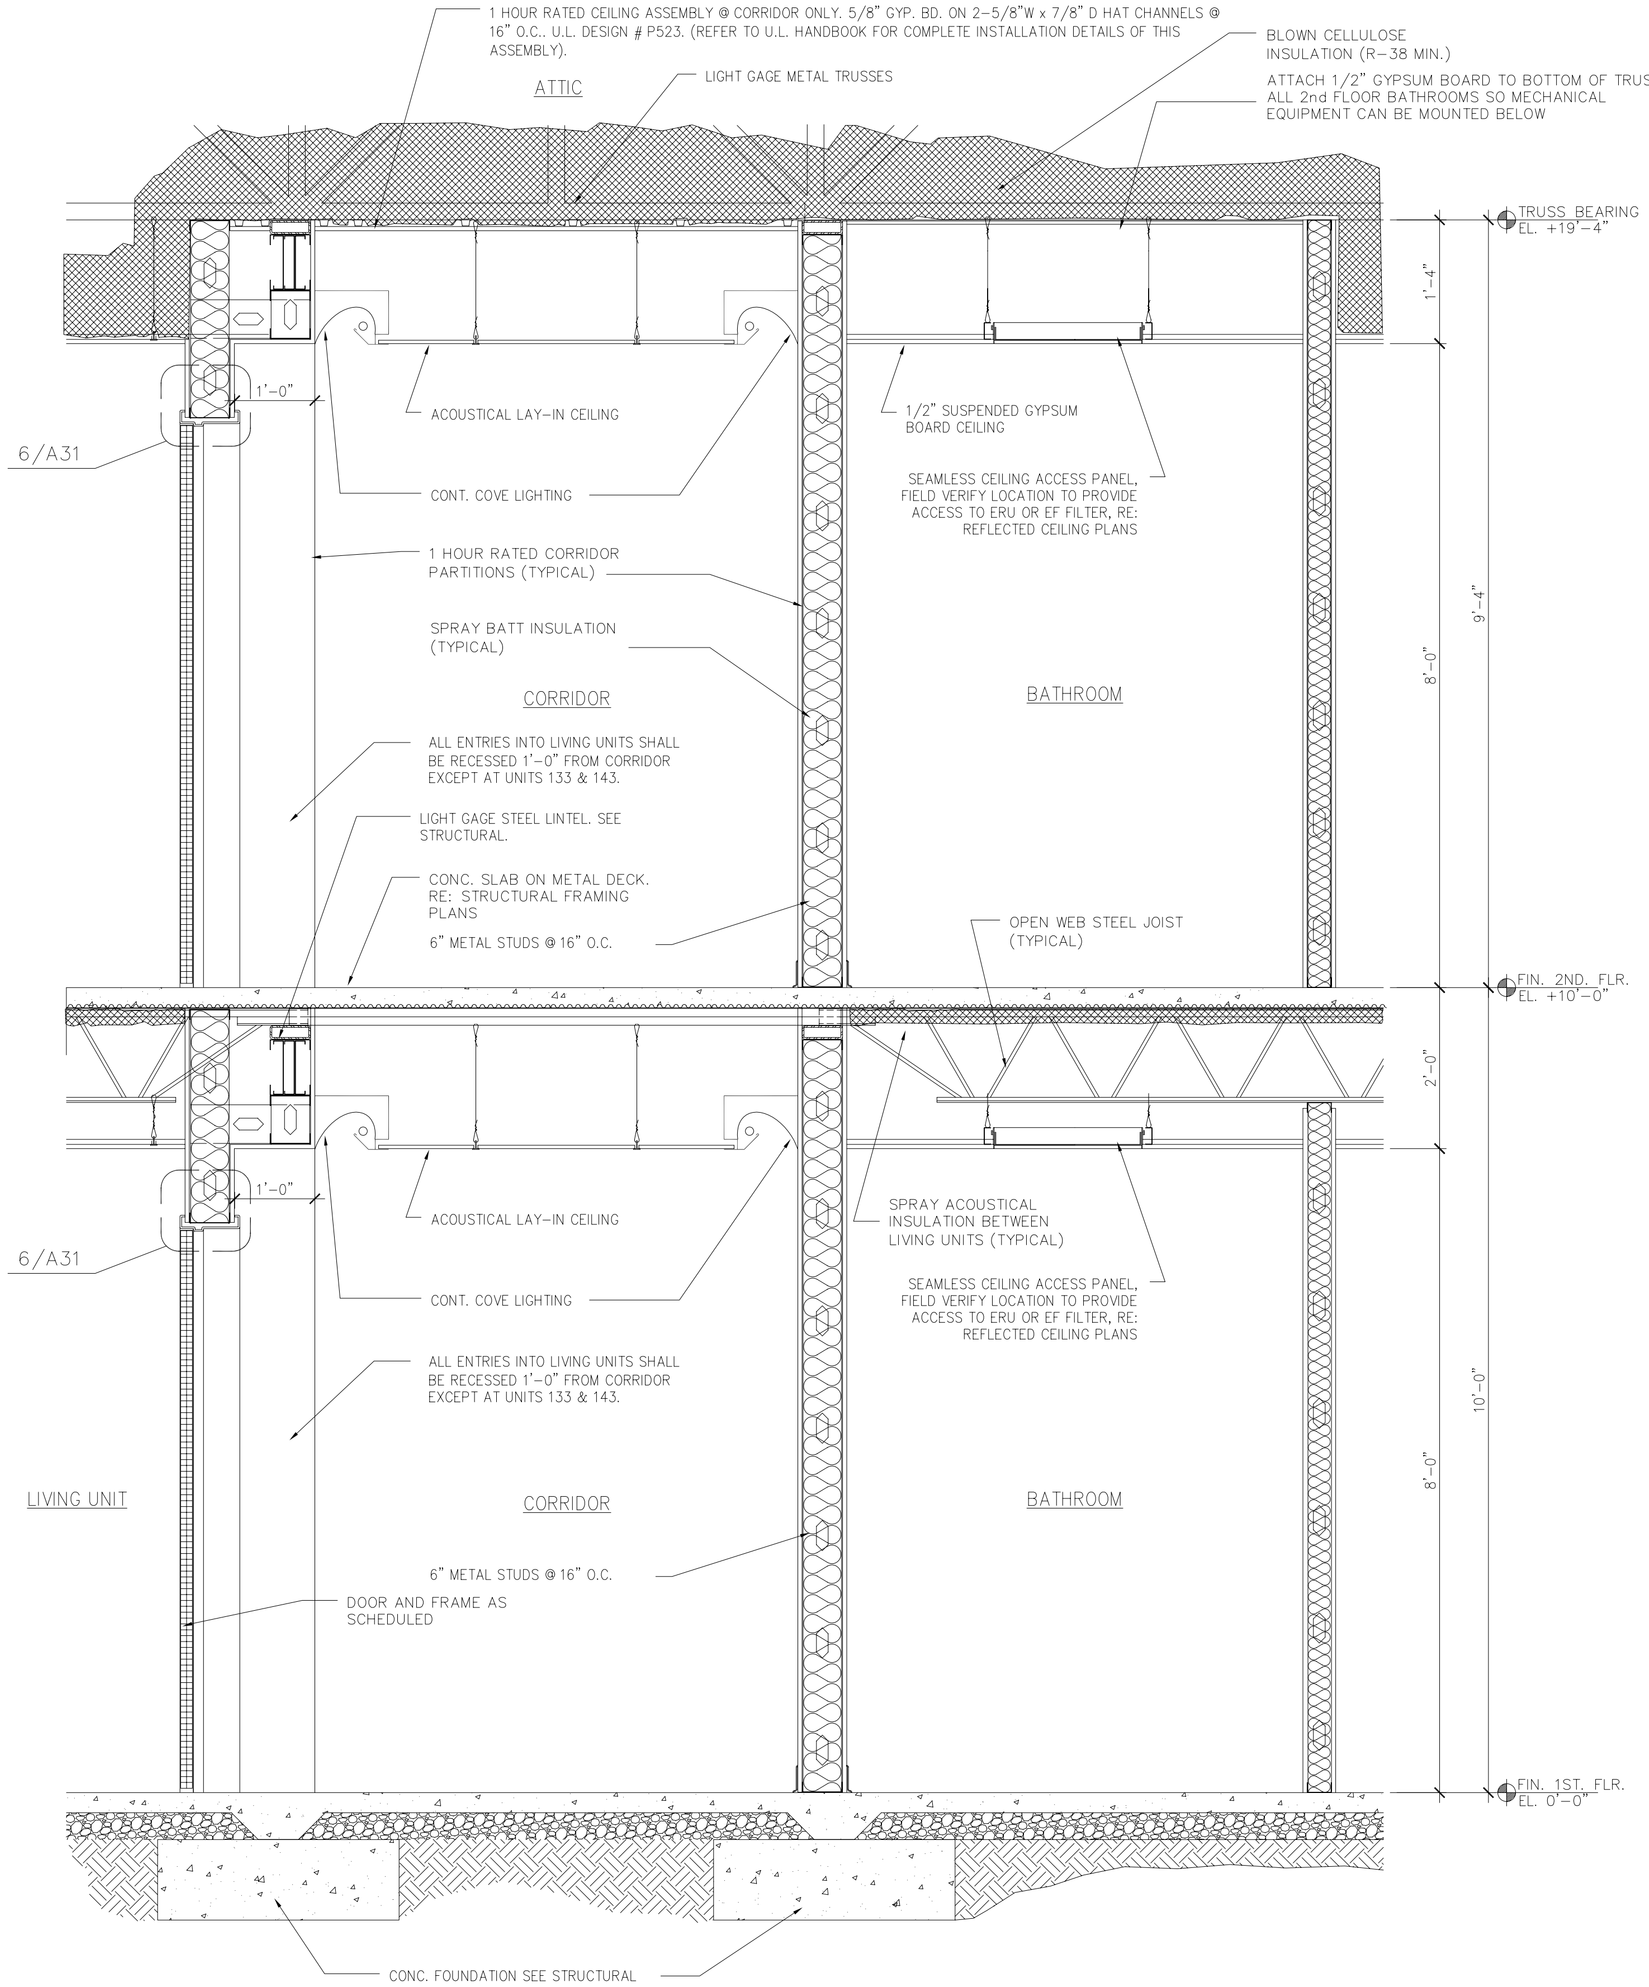

1 SECTION THRU TYPICAL CORRIDOR

SCALE :3/4"=1'-0"
RE :
0' 1' 2' 4'

AIR EDUCATION & TRAINING COMMAND

LITTLE ROCK A.F.B.
ARKANSAS

No.	Revision/Issue	Date	BY	APP'D
1	No changes from Design to As-Built			

PROJECT TITLE

TEMPORARY LODGING FACILITY

SHEET TITLE

ELEVATOR AND CORRIDOR SECTIONS

AS-BUILT

DRAWN BY: RL	LEAD DESIGNER: BG
TECH REVIEWER:	FILE LOCATION:
DESIGNED BY: BG	PROJECT NUMBER: NKAK02-5001
DATE: 28 MAY 2002	SHEET: A23
SCALE: 3/4"=1'-0"	32 OF 108