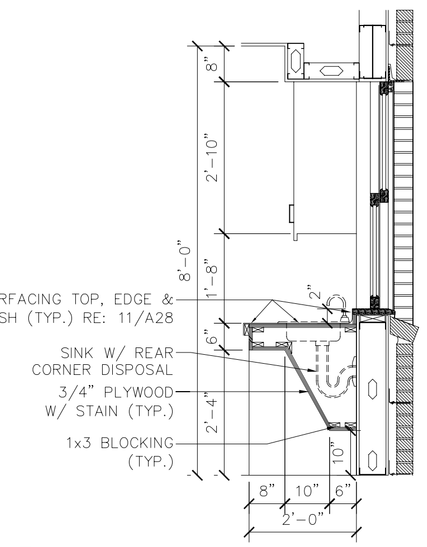

8 MILLWORK SECTION

SCALE : 1/2" = 1'-0"
RE : 1' 2' 4'

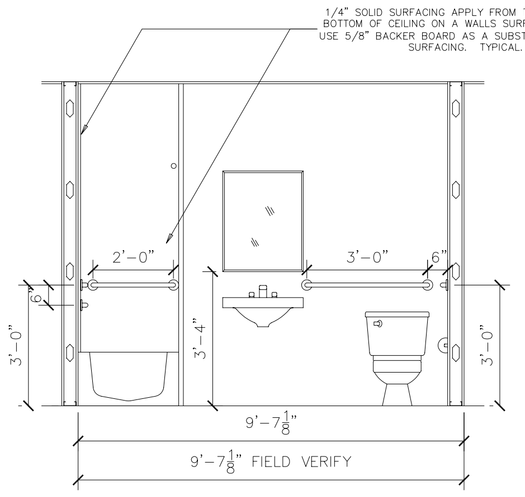

7 2 BEDROOM ADA UNIT ELEVATION

SCALE : 3/8" = 1'-0"
RE : 2/A26
0' 1' 2' 4'

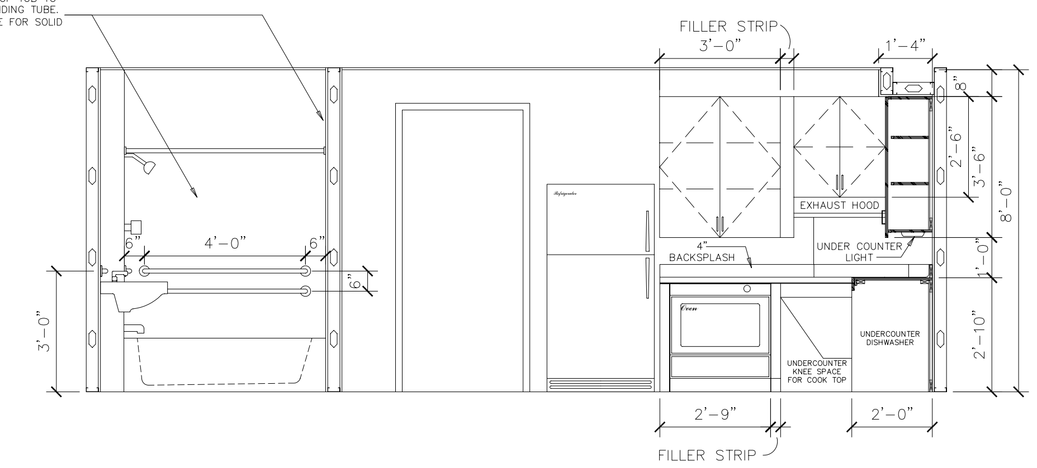

6 2 BEDROOM ADA UNIT ELEVATION/ SECTION

SCALE : 3/8" = 1'-0"
RE : 2/A26
0' 1' 2' 4'

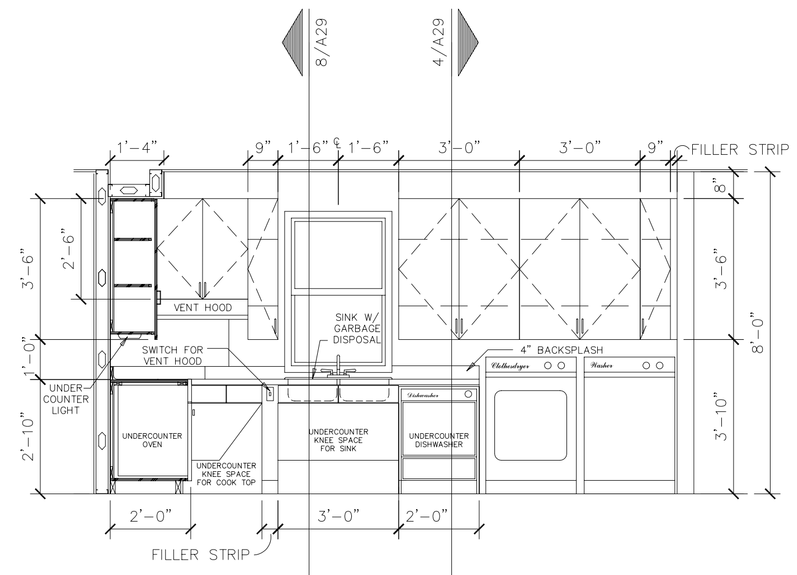

5 2 BEDROOM ADA UNIT ELEVATION

SCALE : 3/8" = 1'-0"
RE : 2/A26
0' 1' 2' 4'

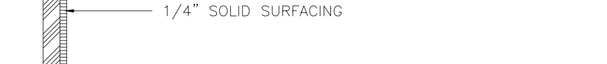

9 SOLID SURFACING TUB SURROND DETAIL

SCALE : 3"=1'-0"
RE : 3/A29

EQUIPMENT SCHEDULE & GENERAL NOTE:

1. EQUIPMENT/APPLIANCES ARE TO BE OWNER FURNISHED AND CONTRACTOR INSTALLED.

NOTE:

1. PREMANUFACTURED PREFINISHED CABINET STAIN TO MATCH WILSONART LAMINATE 10777-7 DARK MAHOGANY, SUBMIT SAMPLES FOR APPROVAL.

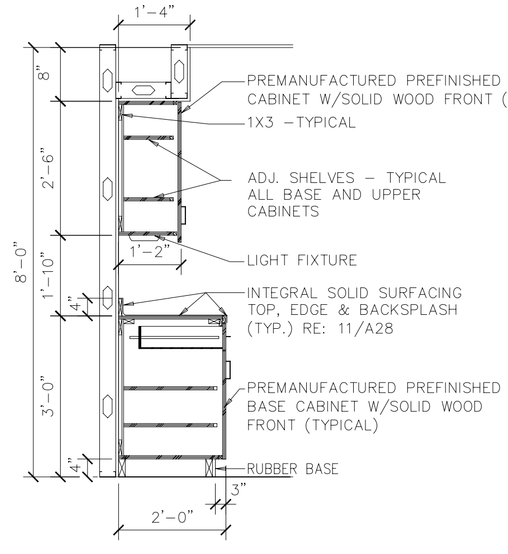

4 MILLWORK SECTION

SCALE : 1/2" = 1'-0"
RE : 1/A29
0' 1' 2' 4'

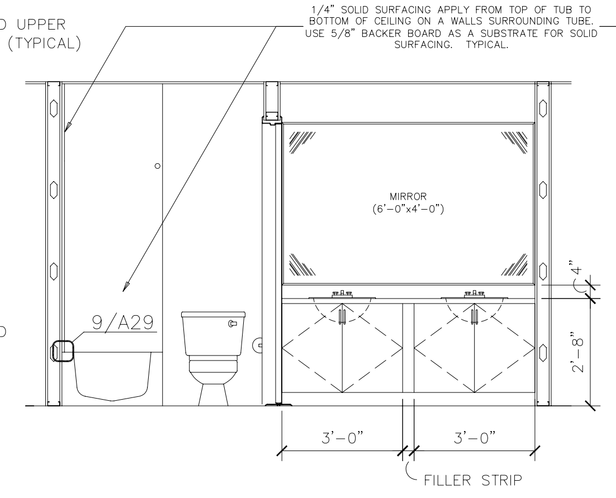

3 TYPICAL 1&2 BEDROOM UNIT ELEVATION

SCALE : 3/8" = 1'-0"
RE : 1/A27
0' 1' 2' 4'

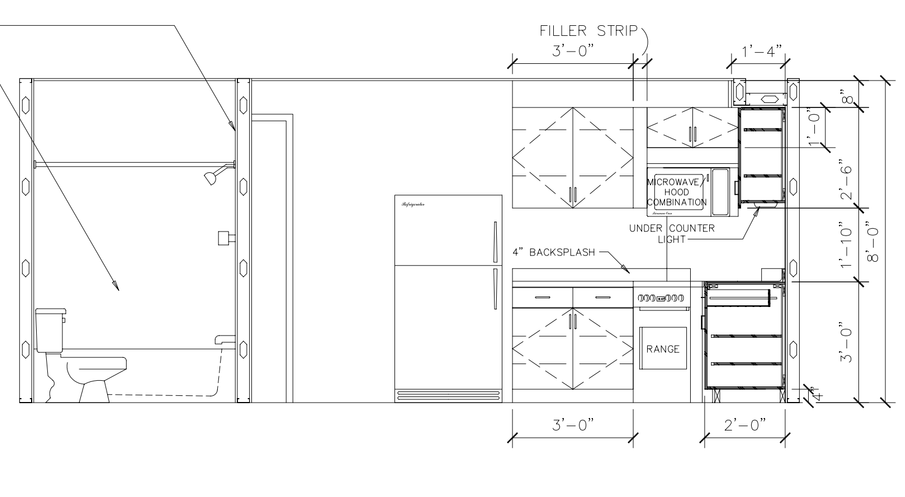

2 TYPICAL 1&2 BEDROOM UNIT ELEVATION

SCALE : 3/8" = 1'-0"
RE : 1/A27
0' 1' 2' 4'

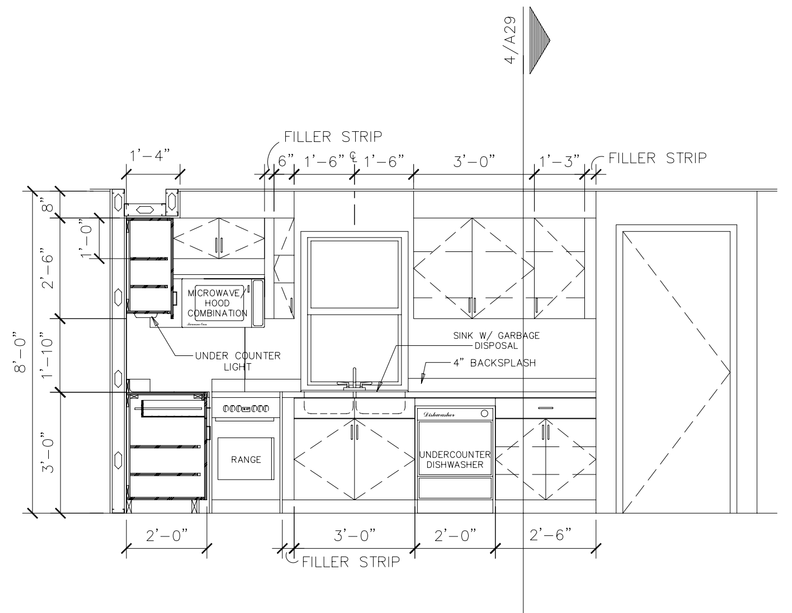

1 TYPICAL 1&2 BEDROOM UNIT ELEVATION

SCALE : 3/8" = 1'-0"
RE : 1/A27
0' 1' 2' 4'

LITTLE ROCK A.F.B.
ARKANSAS

No.	Revision/Issue	Date	BY	APP'D
1	No changes from Design to As-Built			

PROJECT TITLE

TEMPORARY LODGING FACILITY

SHEET TITLE

1, 2 & ADA BEDROOM UNITS ELEVATIONS/ SECTIONS

AS-BUILT

DRAWN BY: JB	LEAD DESIGNER: BG
TECH REVIEWER:	FILE LOCATION:
DESIGNED BY: BG	PROJECT NUMBER: NKAK02-5001
DATE: 28 MAY 2002	SHEET: A29
SCALE: 3/8" = 1'-0"	38 OF 108