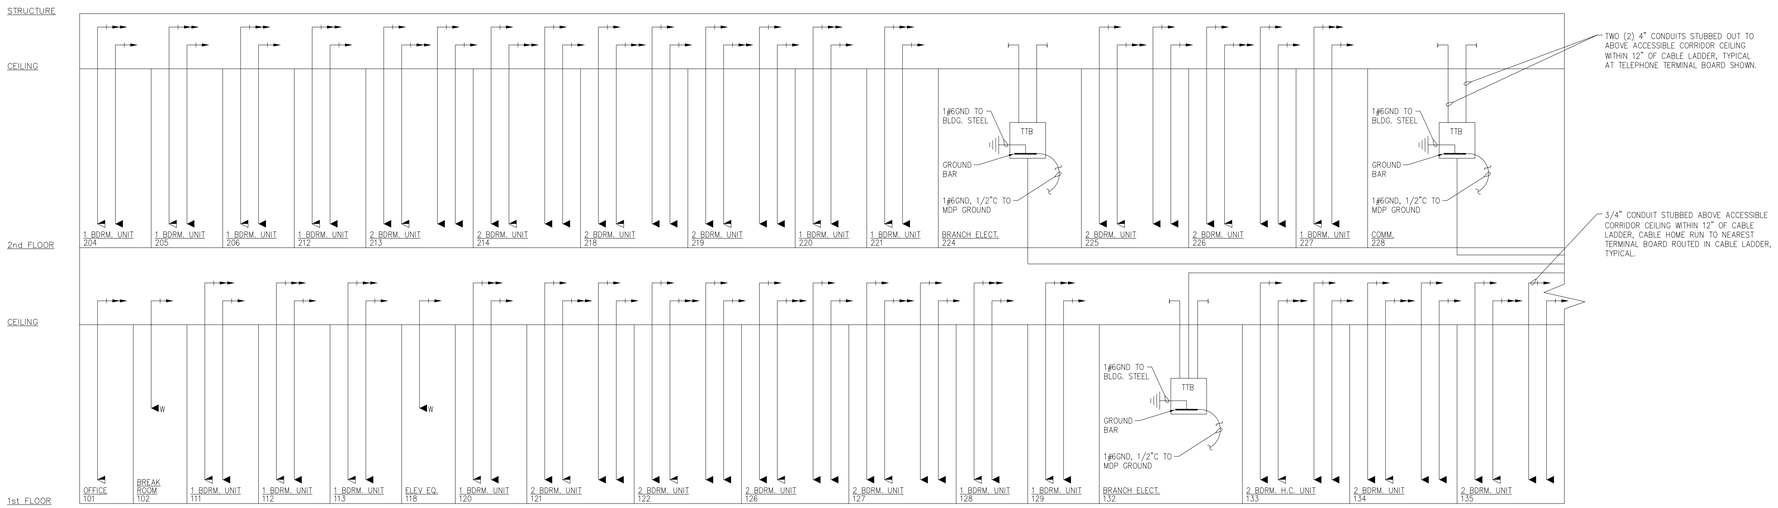

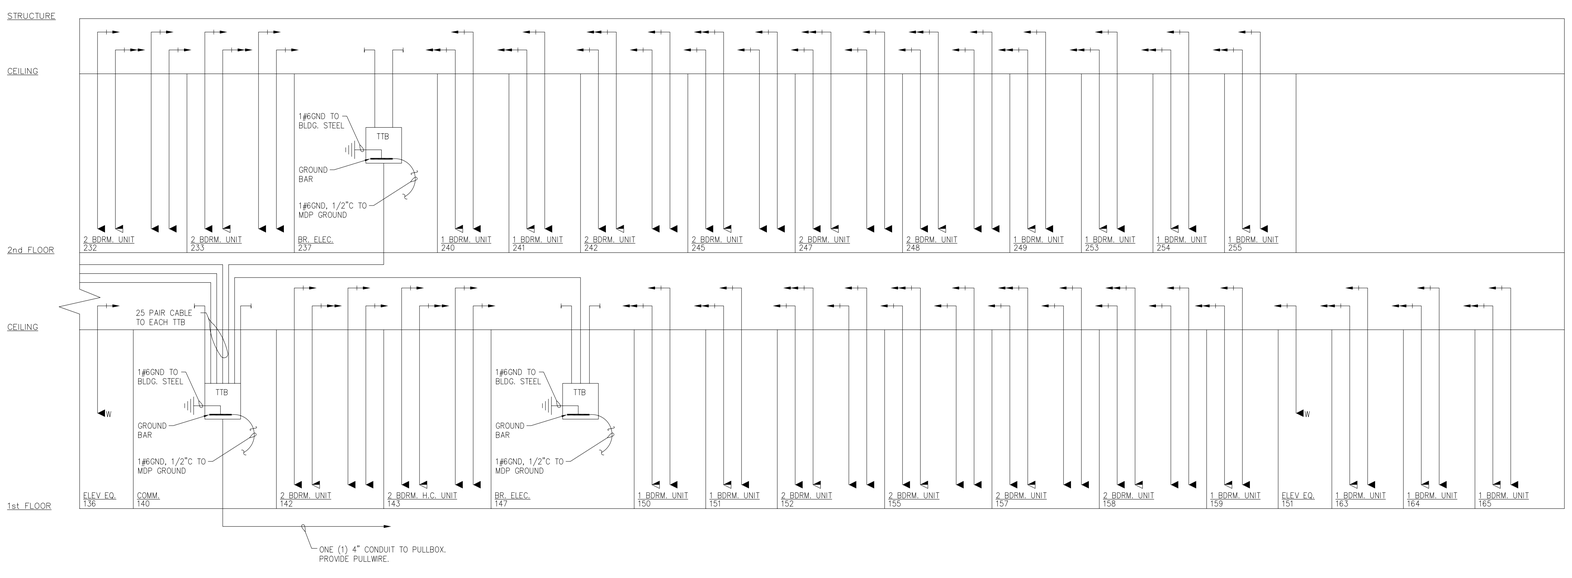

1 SYSTEMS RISER DIAGRAM
SCALE: NONE

LITTLE ROCK A.F.B.
ARKANSAS

CIVIL ENGINEER	CHIEF ENGINEER
CHIEF OF OPERATIONS	BIO ENVIRONMENTAL ENG.
FIRE CHIEF	SAFETY
PROGRAM MANAGER	USING AGENCY

No.	Revision/Issue	Date	BY	APP'D
1	No Changes from Design to As-Built			

PROJECT TITLE
TEMPORARY LODGING FACILITY

SHEET TITLE
SYSTEMS RISER DIAGRAM

DRAWN BY BTM	LEAD DESIGNER BRM
TECH REVIEWER	FILE LOCATION
DESIGNED BY BTM	PROJECT NUMBER NKAK02-5001
DATE 28 MAY 2002	SHEET E14
SCALE NONE	105 OF 108