
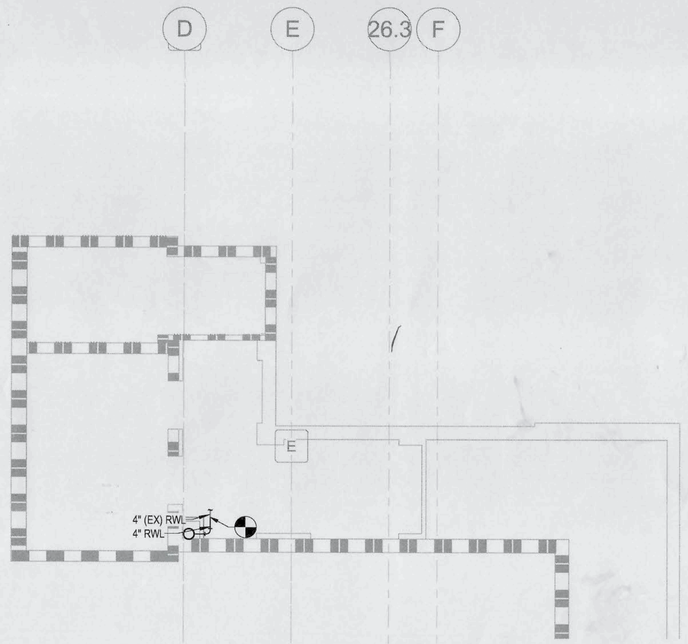


C2 BASEMENT STORM SEWER PLAN

1/8" = 1'-0"

0 4' 8' 16'

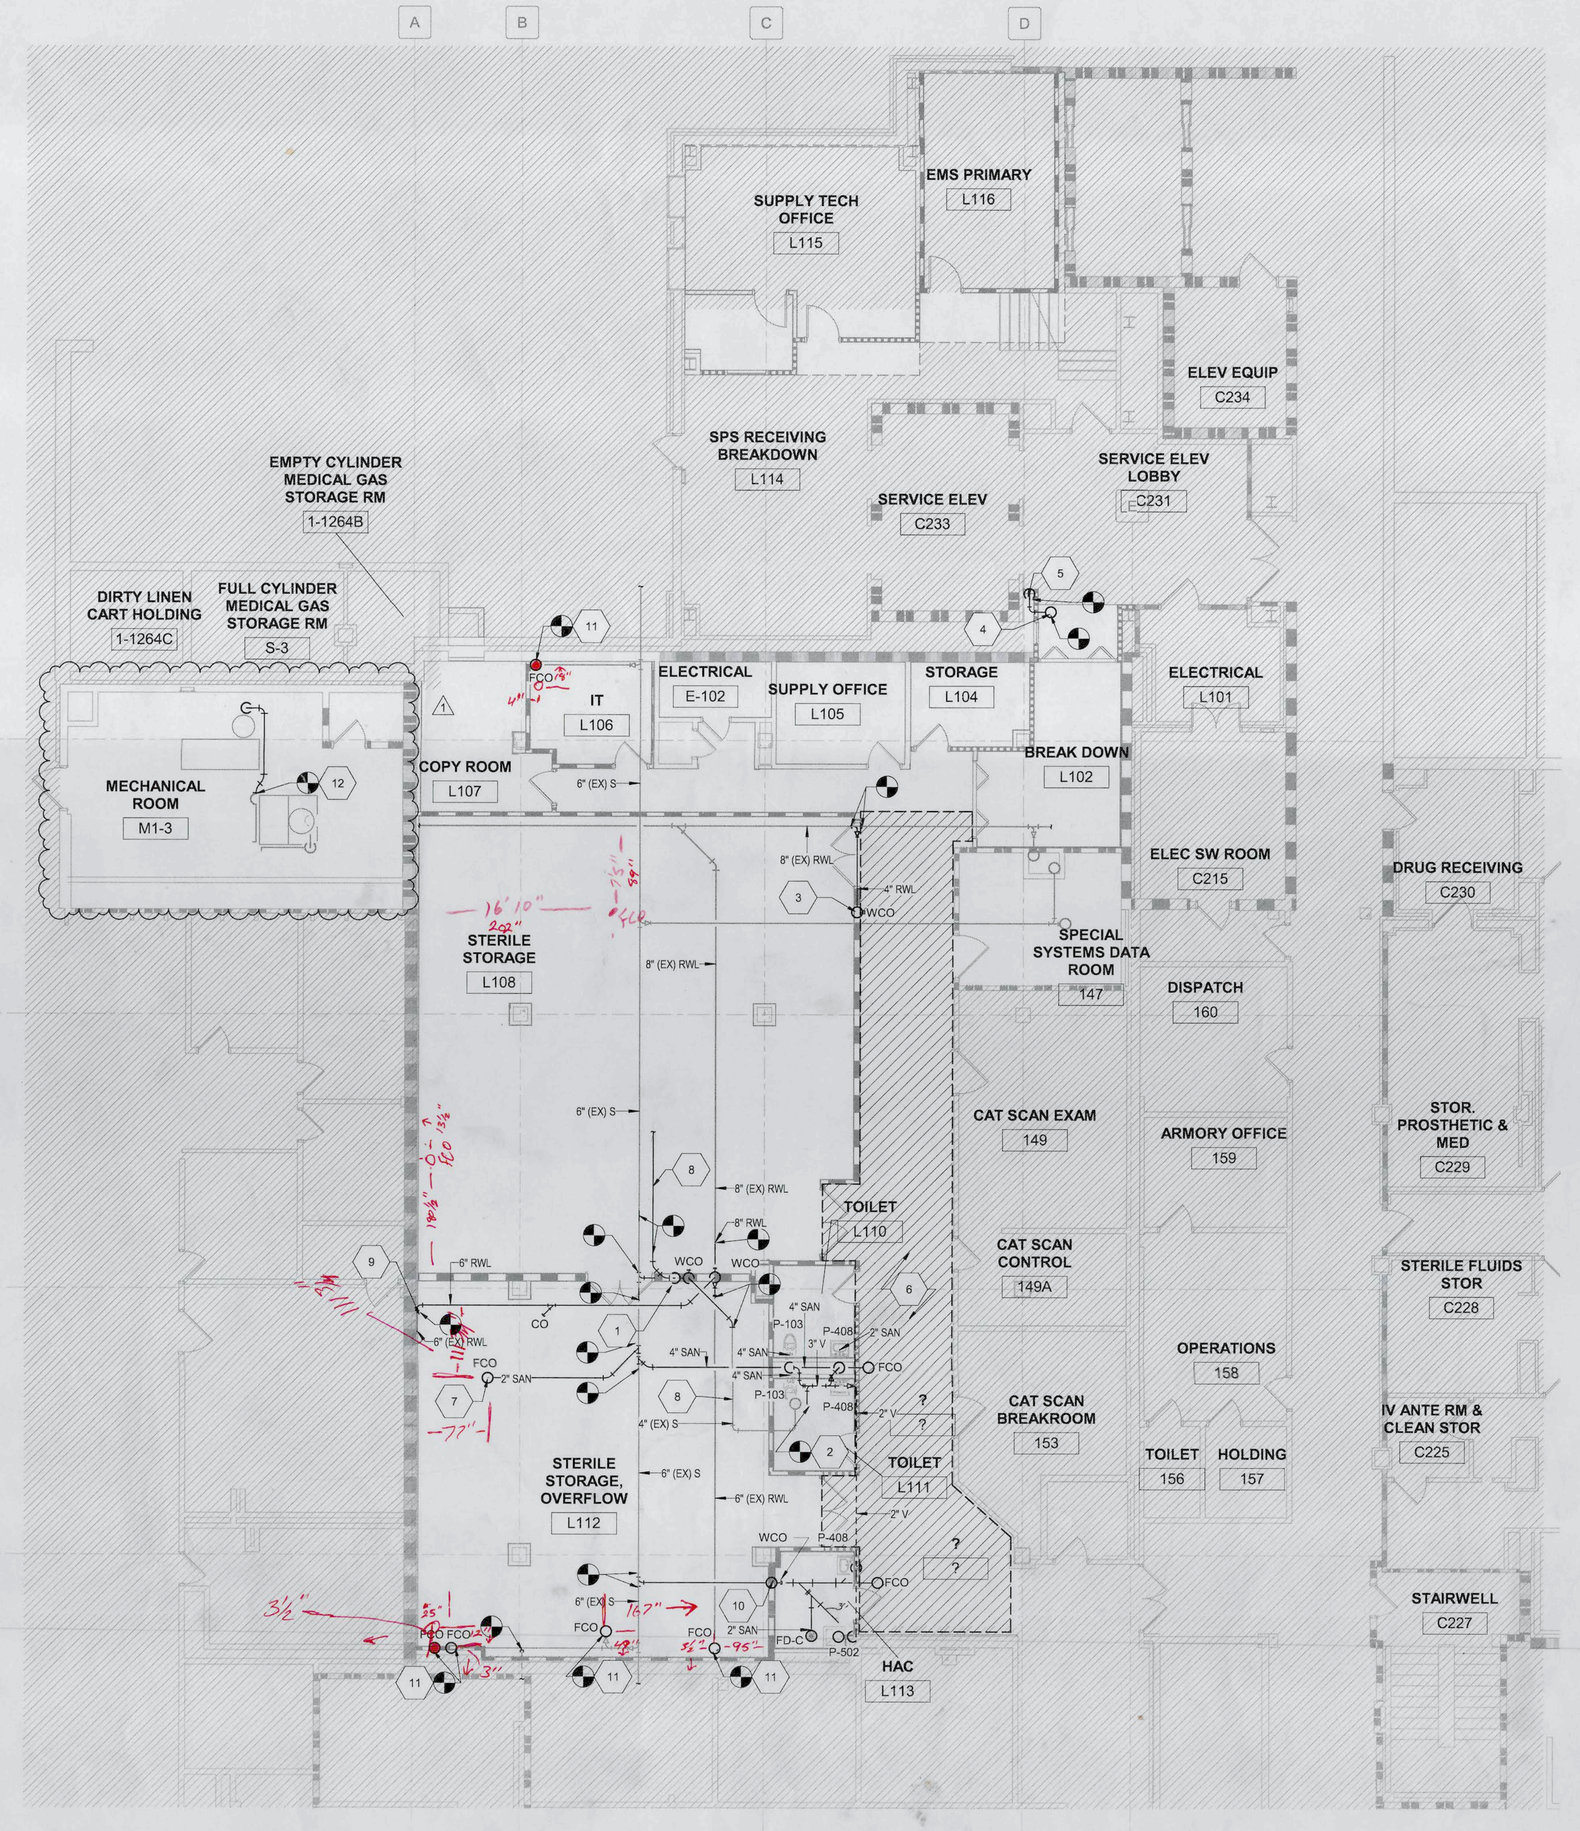

F4 FIRST FLOOR SANITARY SEWER PLAN

1/8" = 1'-0"

0 4' 8' 16'

GENERAL NOTES

A. REFER TO SHEET PL001 FOR LEGEND, ABBREVIATIONS, SCHEDULES AND GENERAL NOTES.

B. UTILITY SERVICES MUST BE MAINTAINED TO THE FLOOR ABOVE. ANY DISRUPTION IN SERVICES SHALL BE COORDINATED WITH THE C.O.R. TWO WEEKS BEFORE THE DISRUPTION. SERVICES SHALL NOT BE OUT FOR MORE THAT 8 HOURS OR AS ALLOWED BY THE C.O.R.

C. ALL WORK ON THE FLOOR SHALL BE DONE ON NIGHTS OR WEEK ENDS UNLESS OTHERWISE PERMITTED BY C.O.R.

SHEET KEYNOTES

1. 4" SANITARY FROM FLOOR ABOVE.
2. 3" VENT PIPE TO FLOOR ABOVE.
3. FUTURE 4" STORM PIPE. CAP PIPE ABOVE CEILING.
4. EXISTING 6" STORM PIPING FROM FLOOR ABOVE.
5. REVISE EXISTING PIPE ROUTING ON FLOOR BELOW TO ACCOMMODATE NEW STORM PIPE PENETRATION.
6. ALL WORK IN CORRIDOR L109 MUST BE PERFORMED AFTER HOURS AND MUST BE PATIENT ACCESSIBLE DURING FACILITY OPERATION HOURS. SEE SHEET AE111-A FOR MORE INFORMATION.
7. FUTURE LOCATION FOR SUMP PUMP CONNECTION.
8. EXISTING 4" SANITARY PIPE FROM FLOOR ABOVE ROUTED WITHIN THE CEILING SPACE OF THE FIRST FLOOR.
9. EXISTING 6" STORM PIPE FROM FLOOR ABOVE ROUTED WITHIN THE CEILING SPACE OF THE FIRST FLOOR.
10. FUTURE 4" WASTE PIPE. CAP PIPE ABOVE CEILING.
11. INSTALL NEW CLEANOUT ON EXISTING SANITARY AND STORM PIPING.
12. CONNECT NEW DRAIN PIPE TO EXISTING PIPE AND ROUTE TO FLOOR DRAIN AS SHOWN.


PARTITION LEGEND

- EXISTING PARTITION / BARRIER - WALL TO REMAIN
- EXISTING PARTITION / BARRIER - WALL TO BE REMOVED
- NEW PARTITION / BARRIER - WALL

PARTITION GRAPHICS

- NO RATING
- SMOKE RESISTIVE PARTITION - NON RATED
- 1 HOUR FIRE BARRIER
- 1 HOUR FIRE/SMOKE BARRIER
- 2 HOUR FIRE BARRIER
- 2 HOUR FIRE/ SMOKE BARRIER

KEY PLAN

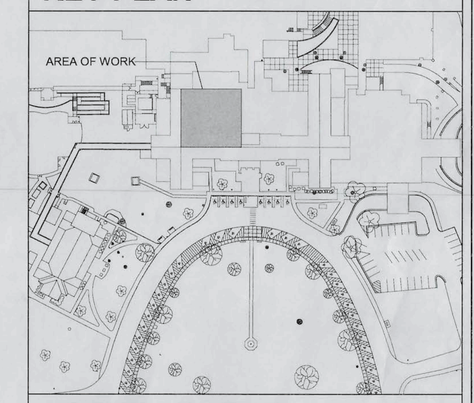

NORTH LEGEND



FIRST FLOOR - FFE: 0'-0"

Revision Number	Revisions:	Date:
1	AMENDMENT 02	07/11/2024

CONSULTANTS

CONSULTING STRUCTURAL ENGINEERS

BRITT, PETERS AND ASSOCIATES PLLC consulting engineers

ARCHITECT/ENGINEER OF RECORD

A/E:
HARRELL DESIGN GROUP PC
10720 SIKES PLACE, SUITE 100
CHARLOTTE, NC 28277
704-814-1346
POC: LEE HARRELL PE, LEED AP, QCxP
PRESIDENT
HDG PROJECT: 19022

HARRELL DESIGN GROUP, P.C.
WWW.HARRELLDG.COM

COPYRIGHT © 2024

MP

PRINT NAME: WILLIAM G. GRANEY JR. SEAL 054948 REGISTERED PROFESSIONAL ENGINEER

William G Graney Jr
Charlotte, NC
I am approving this document
bgraney@harrelldg.com
2024.07.11 15:43:29-04'00'

DRAWING TITLE	FIRST FLOOR SANITARY SEWER PLAN
APPROVED	
PHASE	CONSTRUCTION DOCUMENTS SUBMISSION
	FULLY SPRINKLERED
PROJECT TITLE	RENOVATE SPACE FOR LOGISTICS (B-1)
LOCATION	FAYETTEVILLE VA MEDICAL CENTER
ISSUE DATE	11 APRIL 2024
CHECKED	WGG
DRAWN	DM
PROJECT NUMBER	564-24-104
BUILDING NUMBER	1
DRAWING NUMBER	PL201-A

Engineering Service
VETERANS HEALTH CARE SYSTEM OF THE OZARKS
VA U.S. Department of Veterans Affairs

VA FORM 08 - 6231

Autodesk Docs://19022 - Fayetteville (DIQ Project No. 564-19-403 Renovation of SPS/19022 - PLUMB - R2024.2.rvt
7/11/2024 3:36:18 PM